

"Murex"
Lon. 11350



Arrangement of Machinery


DETAIN

DETAIN



Section at 24 Transverse Sectioning App.

OILERS "NASSA" & "NOBIA"
Proposed Arrangement of Machinery
Scale 3/8" = 1 foot

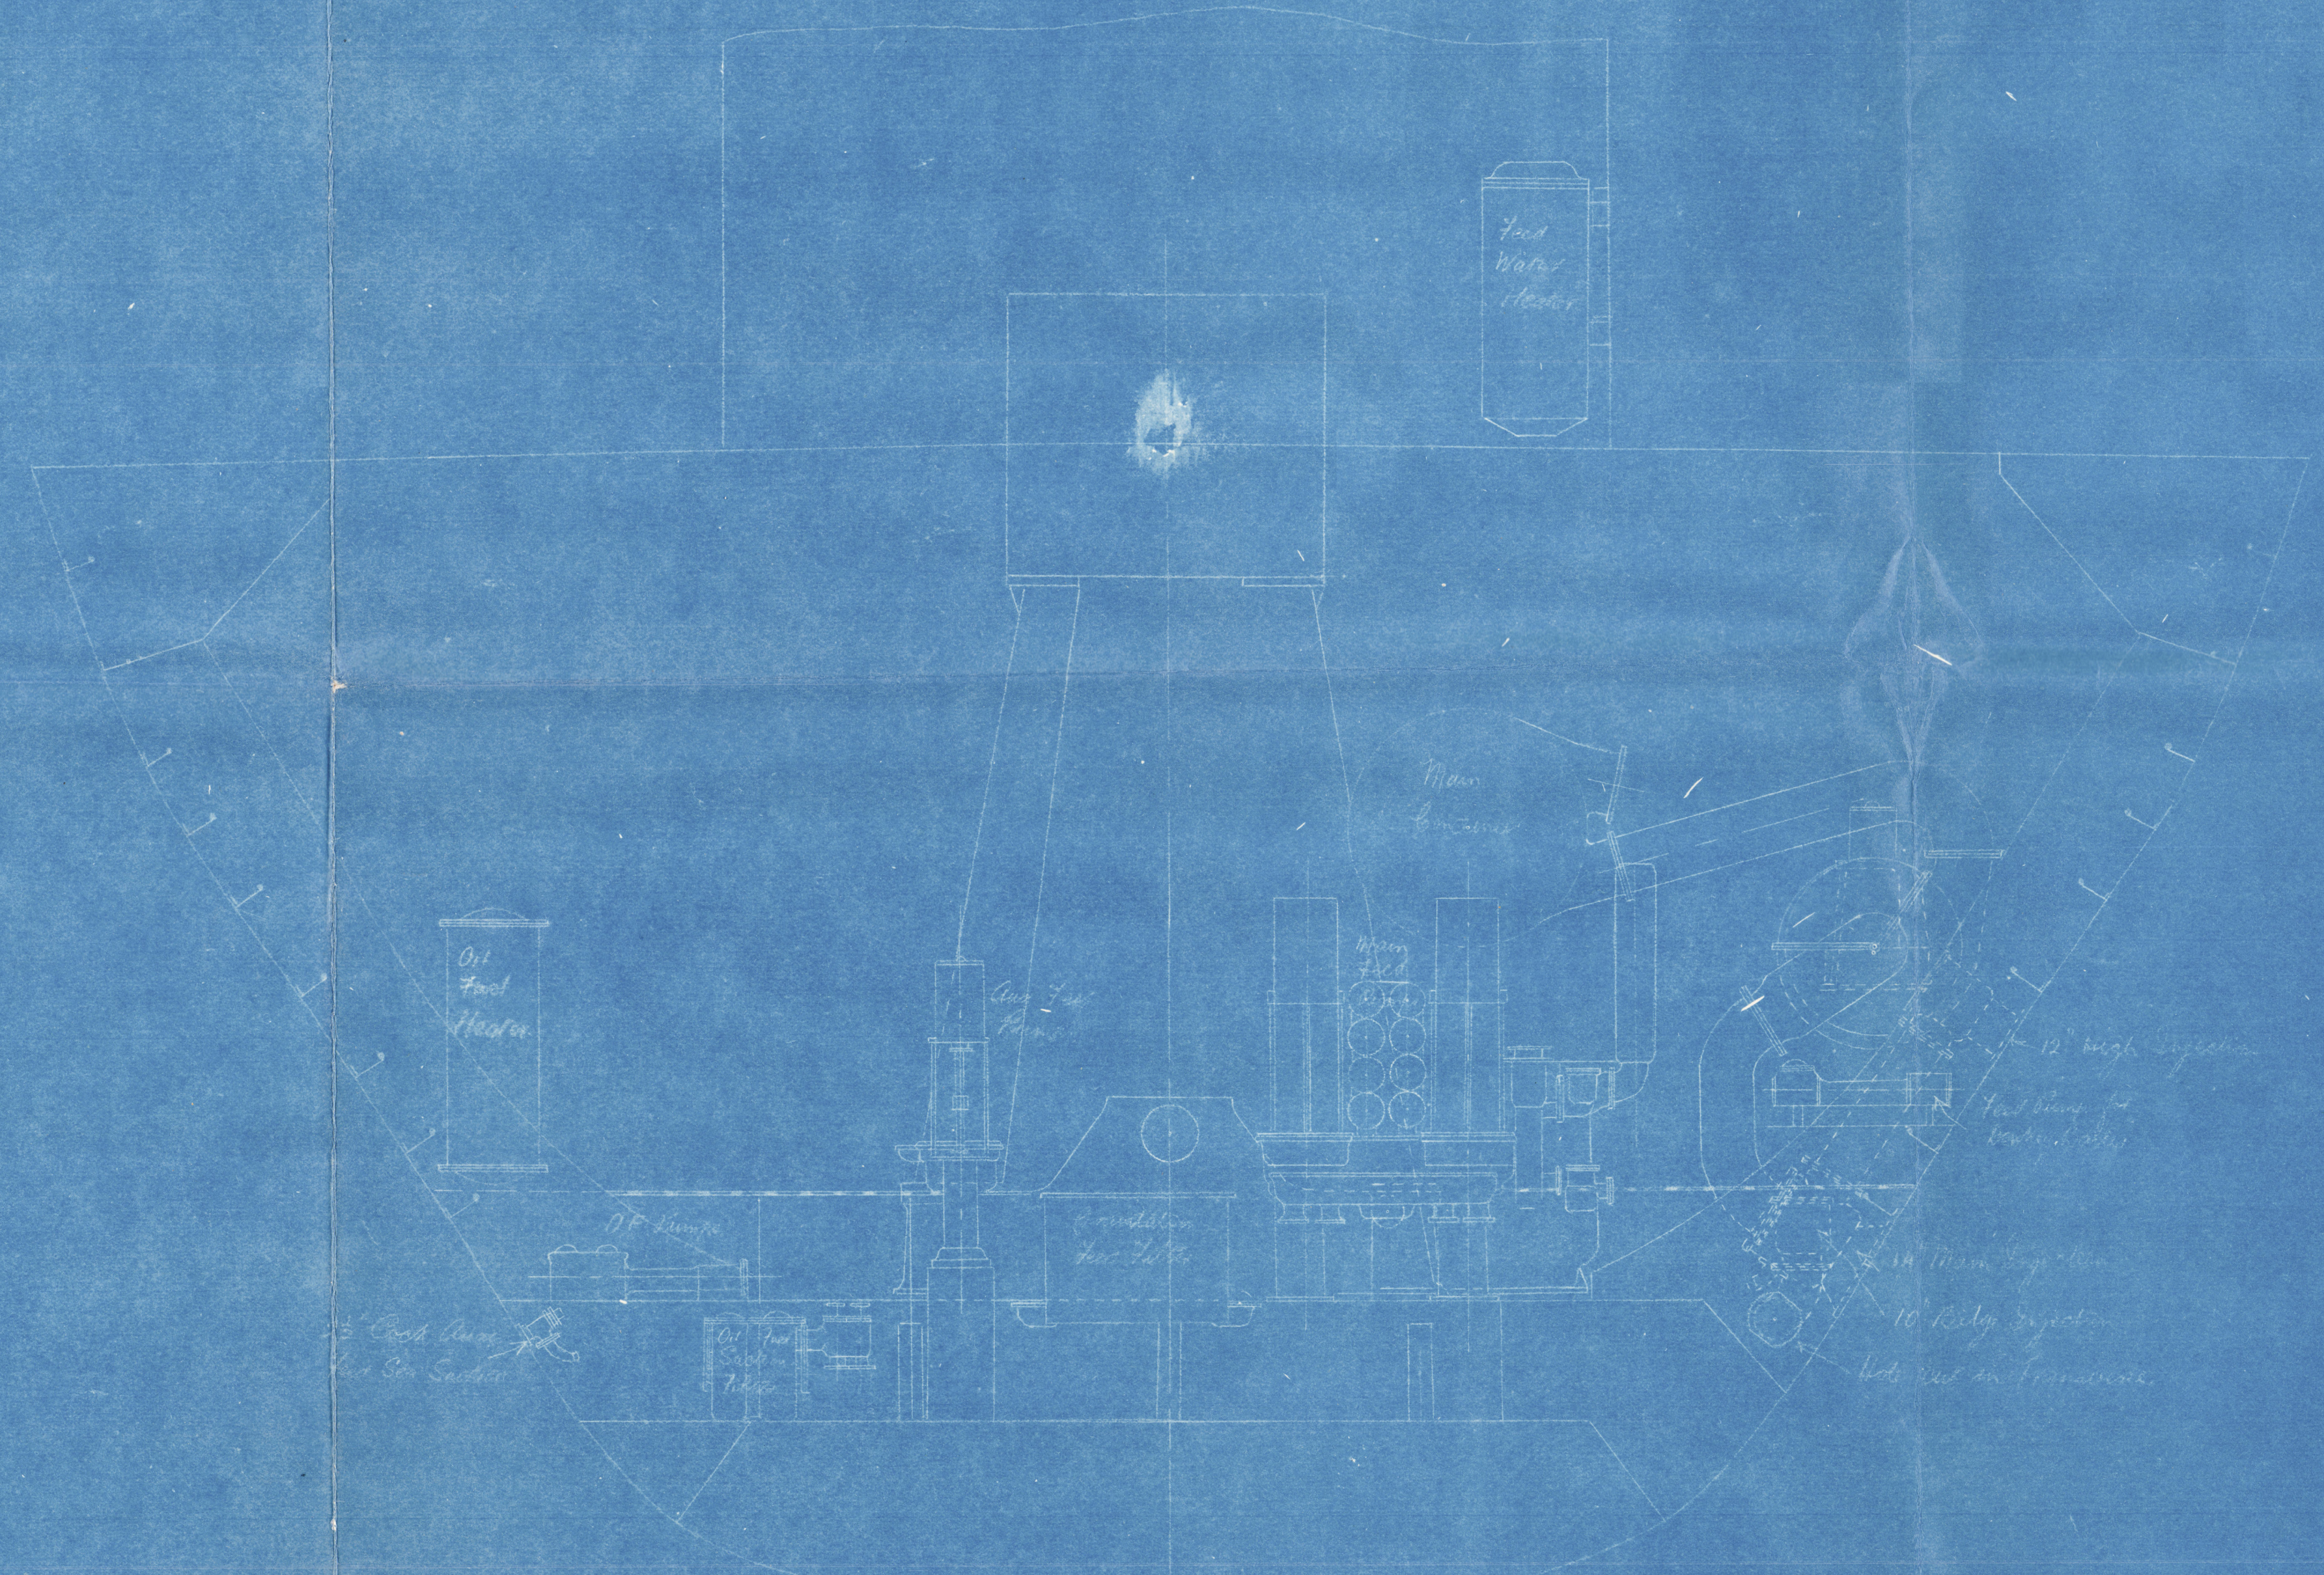

Section at 28 Transverse Sectioning App.

22 8 21

L.Y. ARA
22/8/21