

PLAN No. 2371

FOR ENCLOSURE TO

Messrs. The Surveyors  
Lloyd's Register of Shipping

COCHRANE & SONS, LTD.

SHIPBUILDERS, SEASIDE

DATE 29/12/14

# MIDSHIP SECTION.

N<sup>os</sup> 934-5-6 945

STEEL SCREW TRAWLERS.

DIMENSIONS 138'-4" B.P. x 23'-7 1/2" M.L.D. x 14'-0" M.L.D.

SCALE 1/2" ONE FOOT.

Also

N<sup>os</sup> 944-5.

DECK PLATED OVER IN WAY OF MACHINERY SPACE.

ENGINE AND BOILER CASING AS PREVIOUSLY APPROVED.

## NUMERALS.

B+D ----- 37.62

L x (B+D) ----- 5203.97


## EQUIPMENT.

1st BOWER ANCHOR	-----	8 CWTs STOCKLESS
2nd " "	-----	7 1/4 " "
KEEDGE ANCHOR	-----	3 1/4 " E x STOCK
120 FATHOMS	1 1/16	STUD LINK CABLE.
60 "	6	HAWSER.
60 "	5	WARP.


## RIVETING.

BUTTS OF SHELL PLATING LAPPED AND DOUBLE RIVETED, EXCEPT GARBBOARD AND SHEERSTRAKE WHICH ARE STRAPPED AND DOUBLE RIVETED. LANDINGS DOUBLE RIVETED. BULWARKS SINGLE RIVETED.

STEM 7 1/2 x 1 1/8 BULB BAR.  
STERNPOST 6 x 3 1/4  
BUDDER AS PER RULE  
BULKHEADS AS PER PROFILE.  
ENGINE FLOORS 50  
BOILER ROOM FLOORS 1/4 5

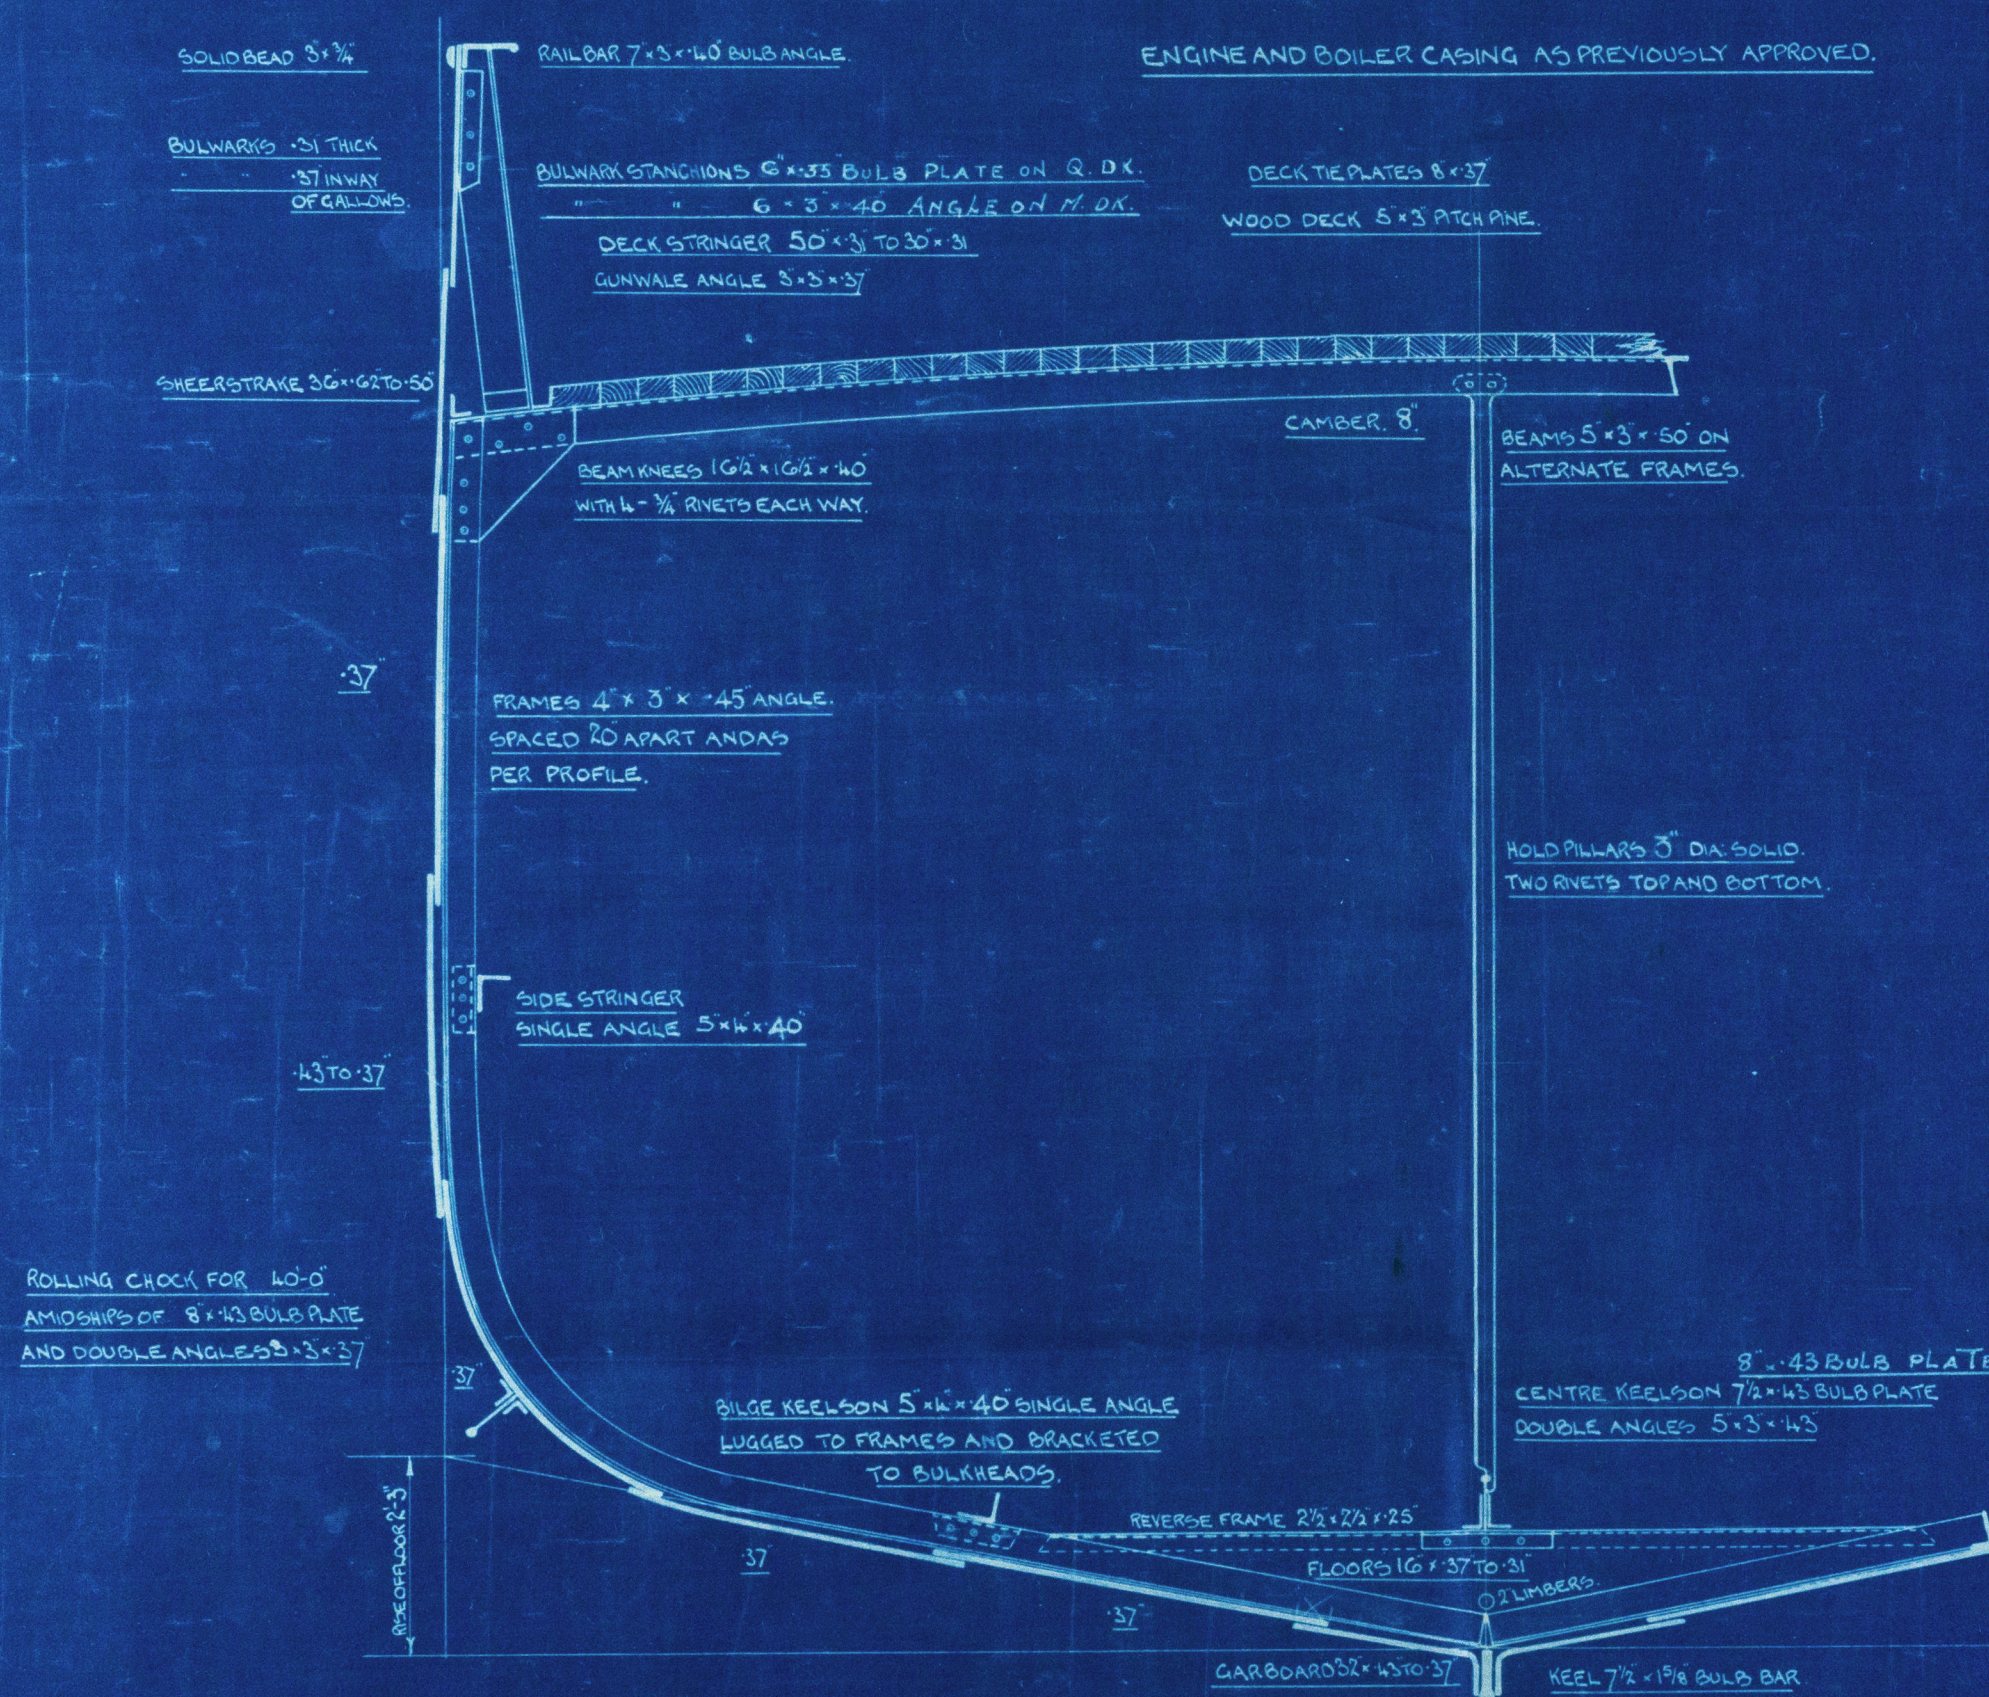

APPROVED BY LLOYD'S 27-11-23

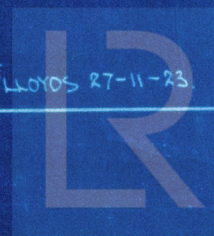


WST-0020



Cochrane's 945  
Midship Section as  
built.

5/5 Lord Incheape.  
Hull Report No. 35744.

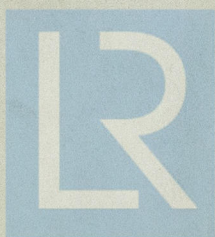

© 2019

Lloyd's Register  
Foundation

W57-0020