


2/8/28

AMENDED PLAN OF DECKS S.S. Nos 265 & 6.

SCALE 1/8" = 1 FOOT.

UPPER DECK

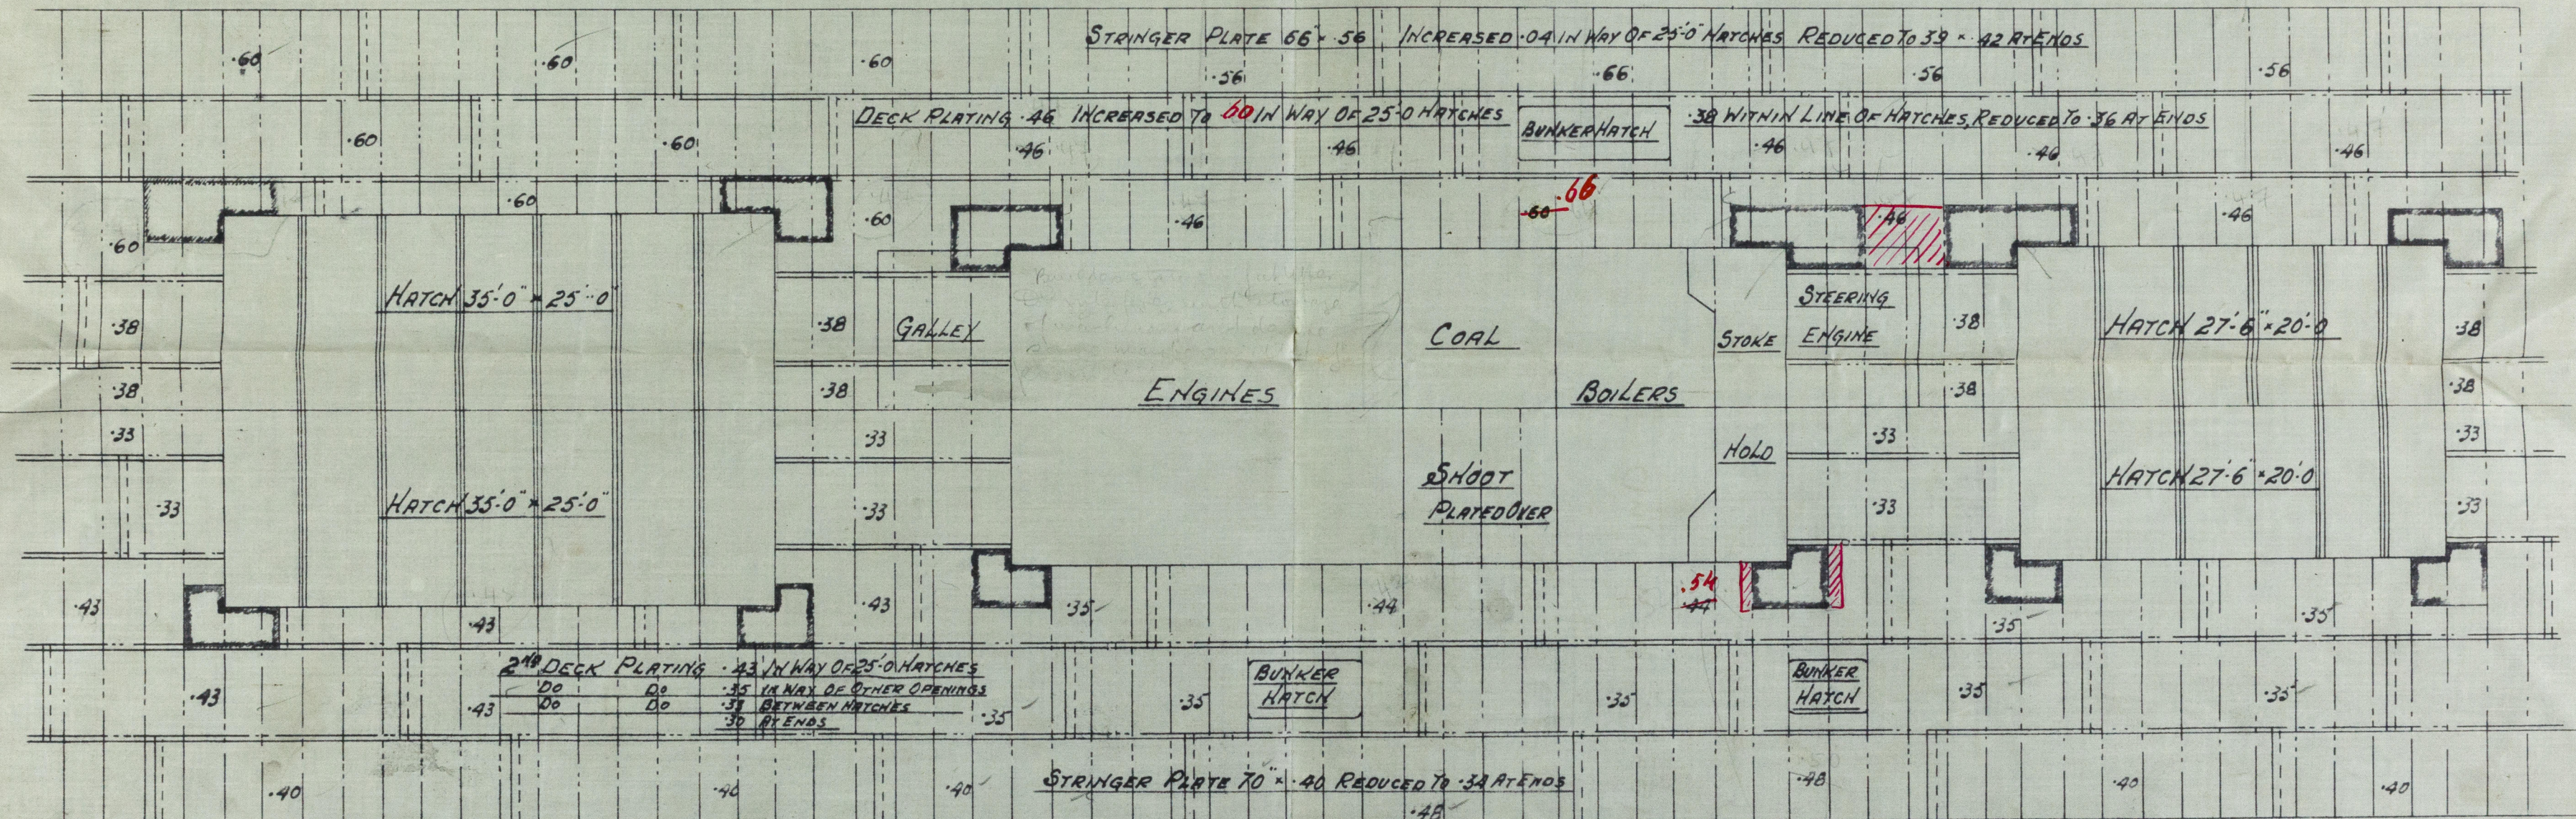

BARTRAM & SONS, LTD.
SHIPBUILDERS
SUNDERLAND.



© 2011

Lloyd's Register
Foundation

W57-0120

SUNDERLAND

BARTRAM & SONS

N^o 265/6.

Amended Decks.

s.s. "Llanarth"

SUNDERLAND RPT. NO. 29995.

s.s. "Llanishen"

SUNDERLAND RPT. NO. 30047

W57-0120



© 2019

Lloyd's Register
Foundation