

SUNDERLAND.

BAR/RAF & SONS W/D.

S.S. Nos. 263/4.

MIDSHIP SECTION.

(SHOWING ARRANG. OF OUTSIDE

TANK BRACKETS & MAIN FRAMES.

S/S LLANFAIR No. 263

SUNDERLAND RPT. NO. 29779



© 2019


Lloyd's Register
Foundation

W57-0210

3-10-27

SS N°263 & 4. DUPLICATES OF N°S 261 & 2

EXCEPT PROPOSED ALTERATION IN FRAMES & BRACKETS OUTSIDE TANK

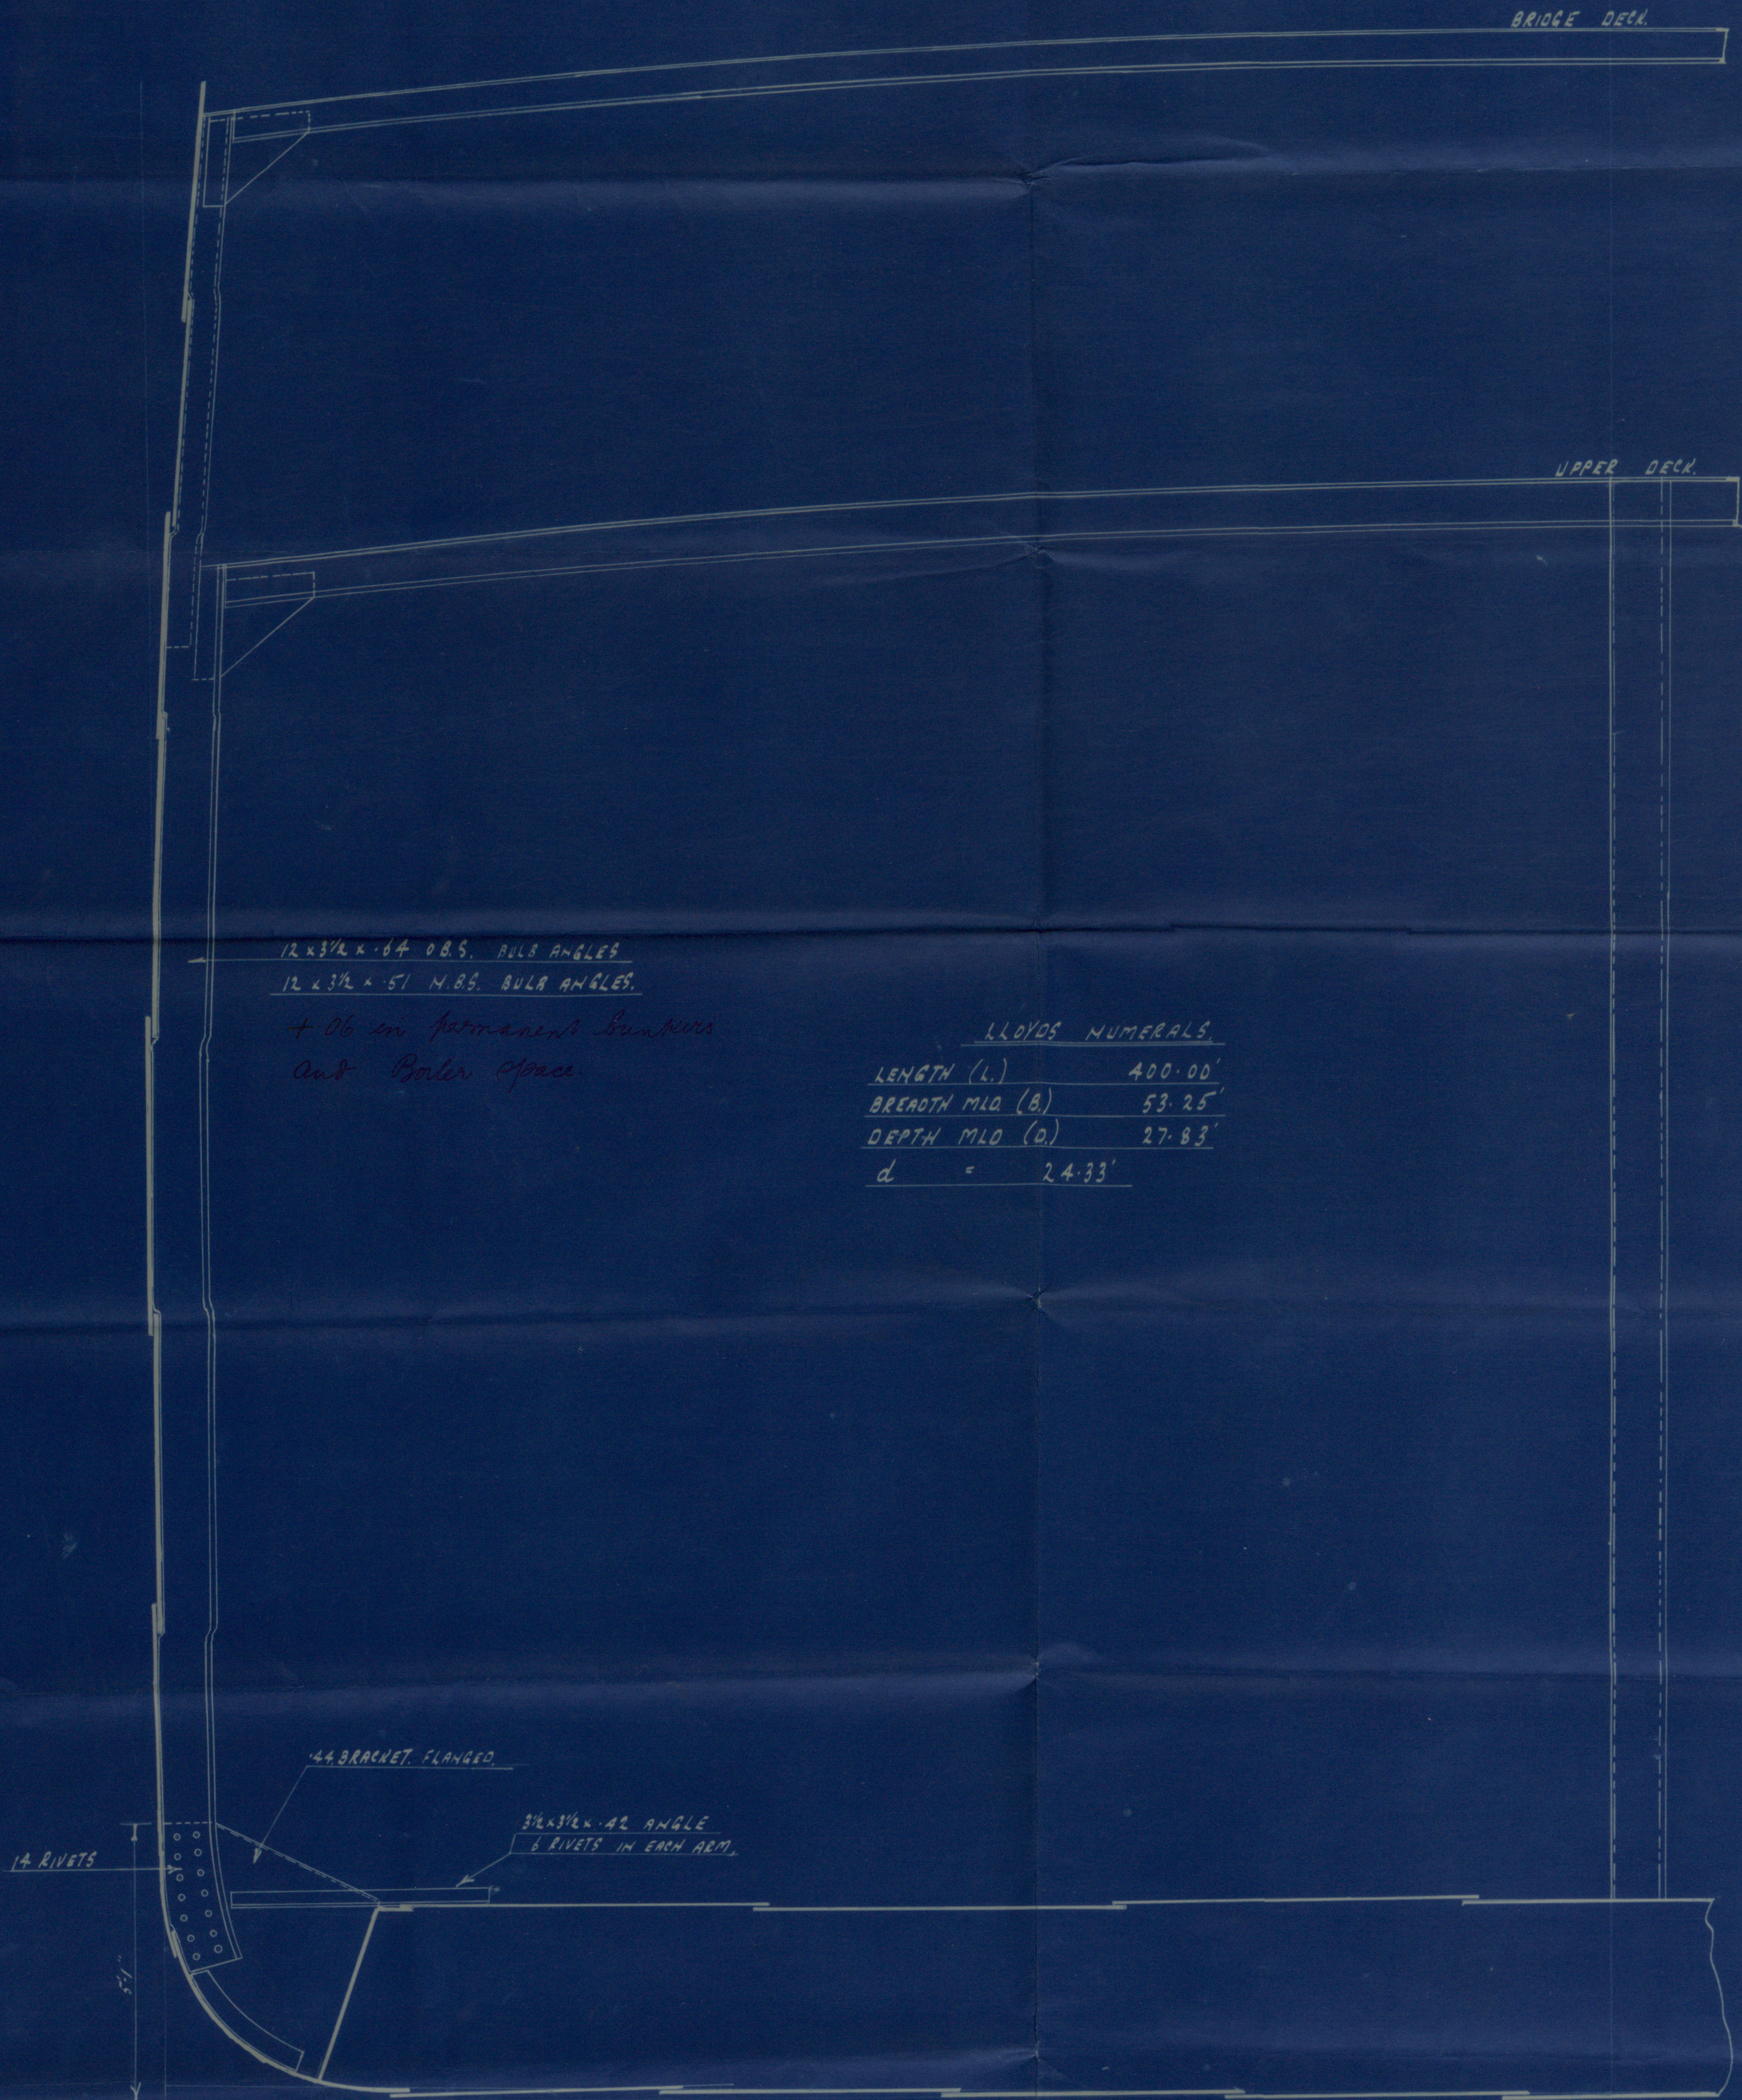

LLOYD'S NUMERALS	
LENGTH (L.)	400.00'
BREADTH MLO (B.)	53.25'
DEPTH MLO (D.)	27.83'
d	= 24.33'

MESSRS BARTRAM & SONS LTD.
SHIPBUILDERS
SUNDERLAND.

W.S.
3. 10. 27
LR
51-6210