




Plan of Gussert.

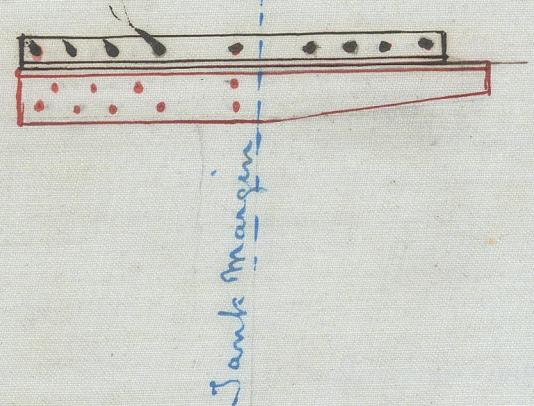

Section showing arrangement of Gussert, etc.

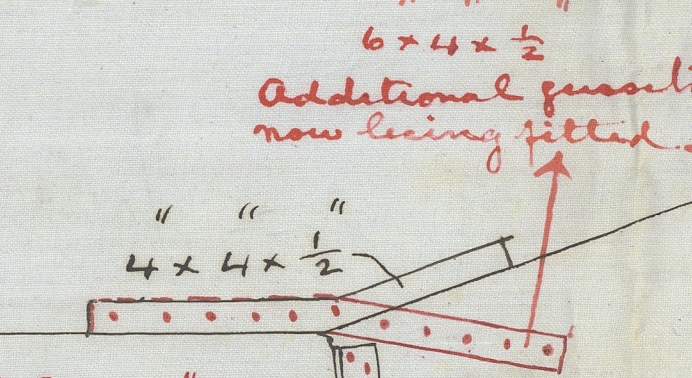


SECTION AT 183 FRAME

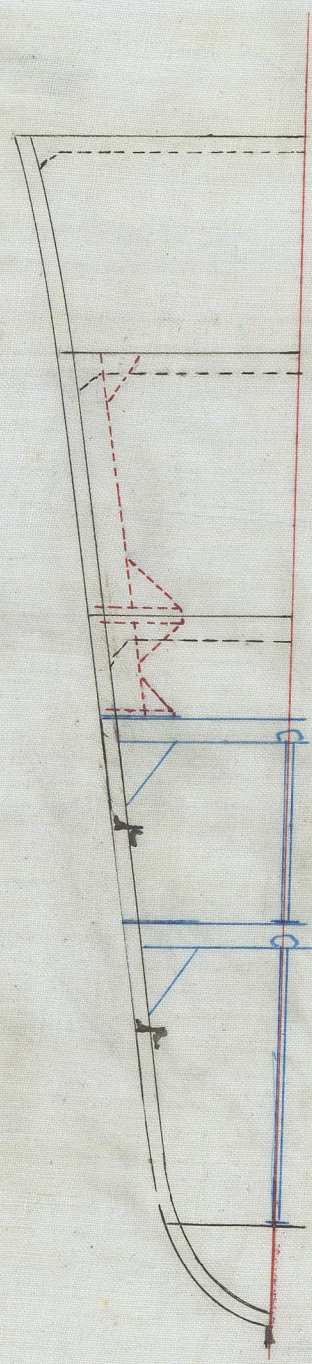

S.S. "MARENGO"

SCALE: 1/8" = 1 Foot.

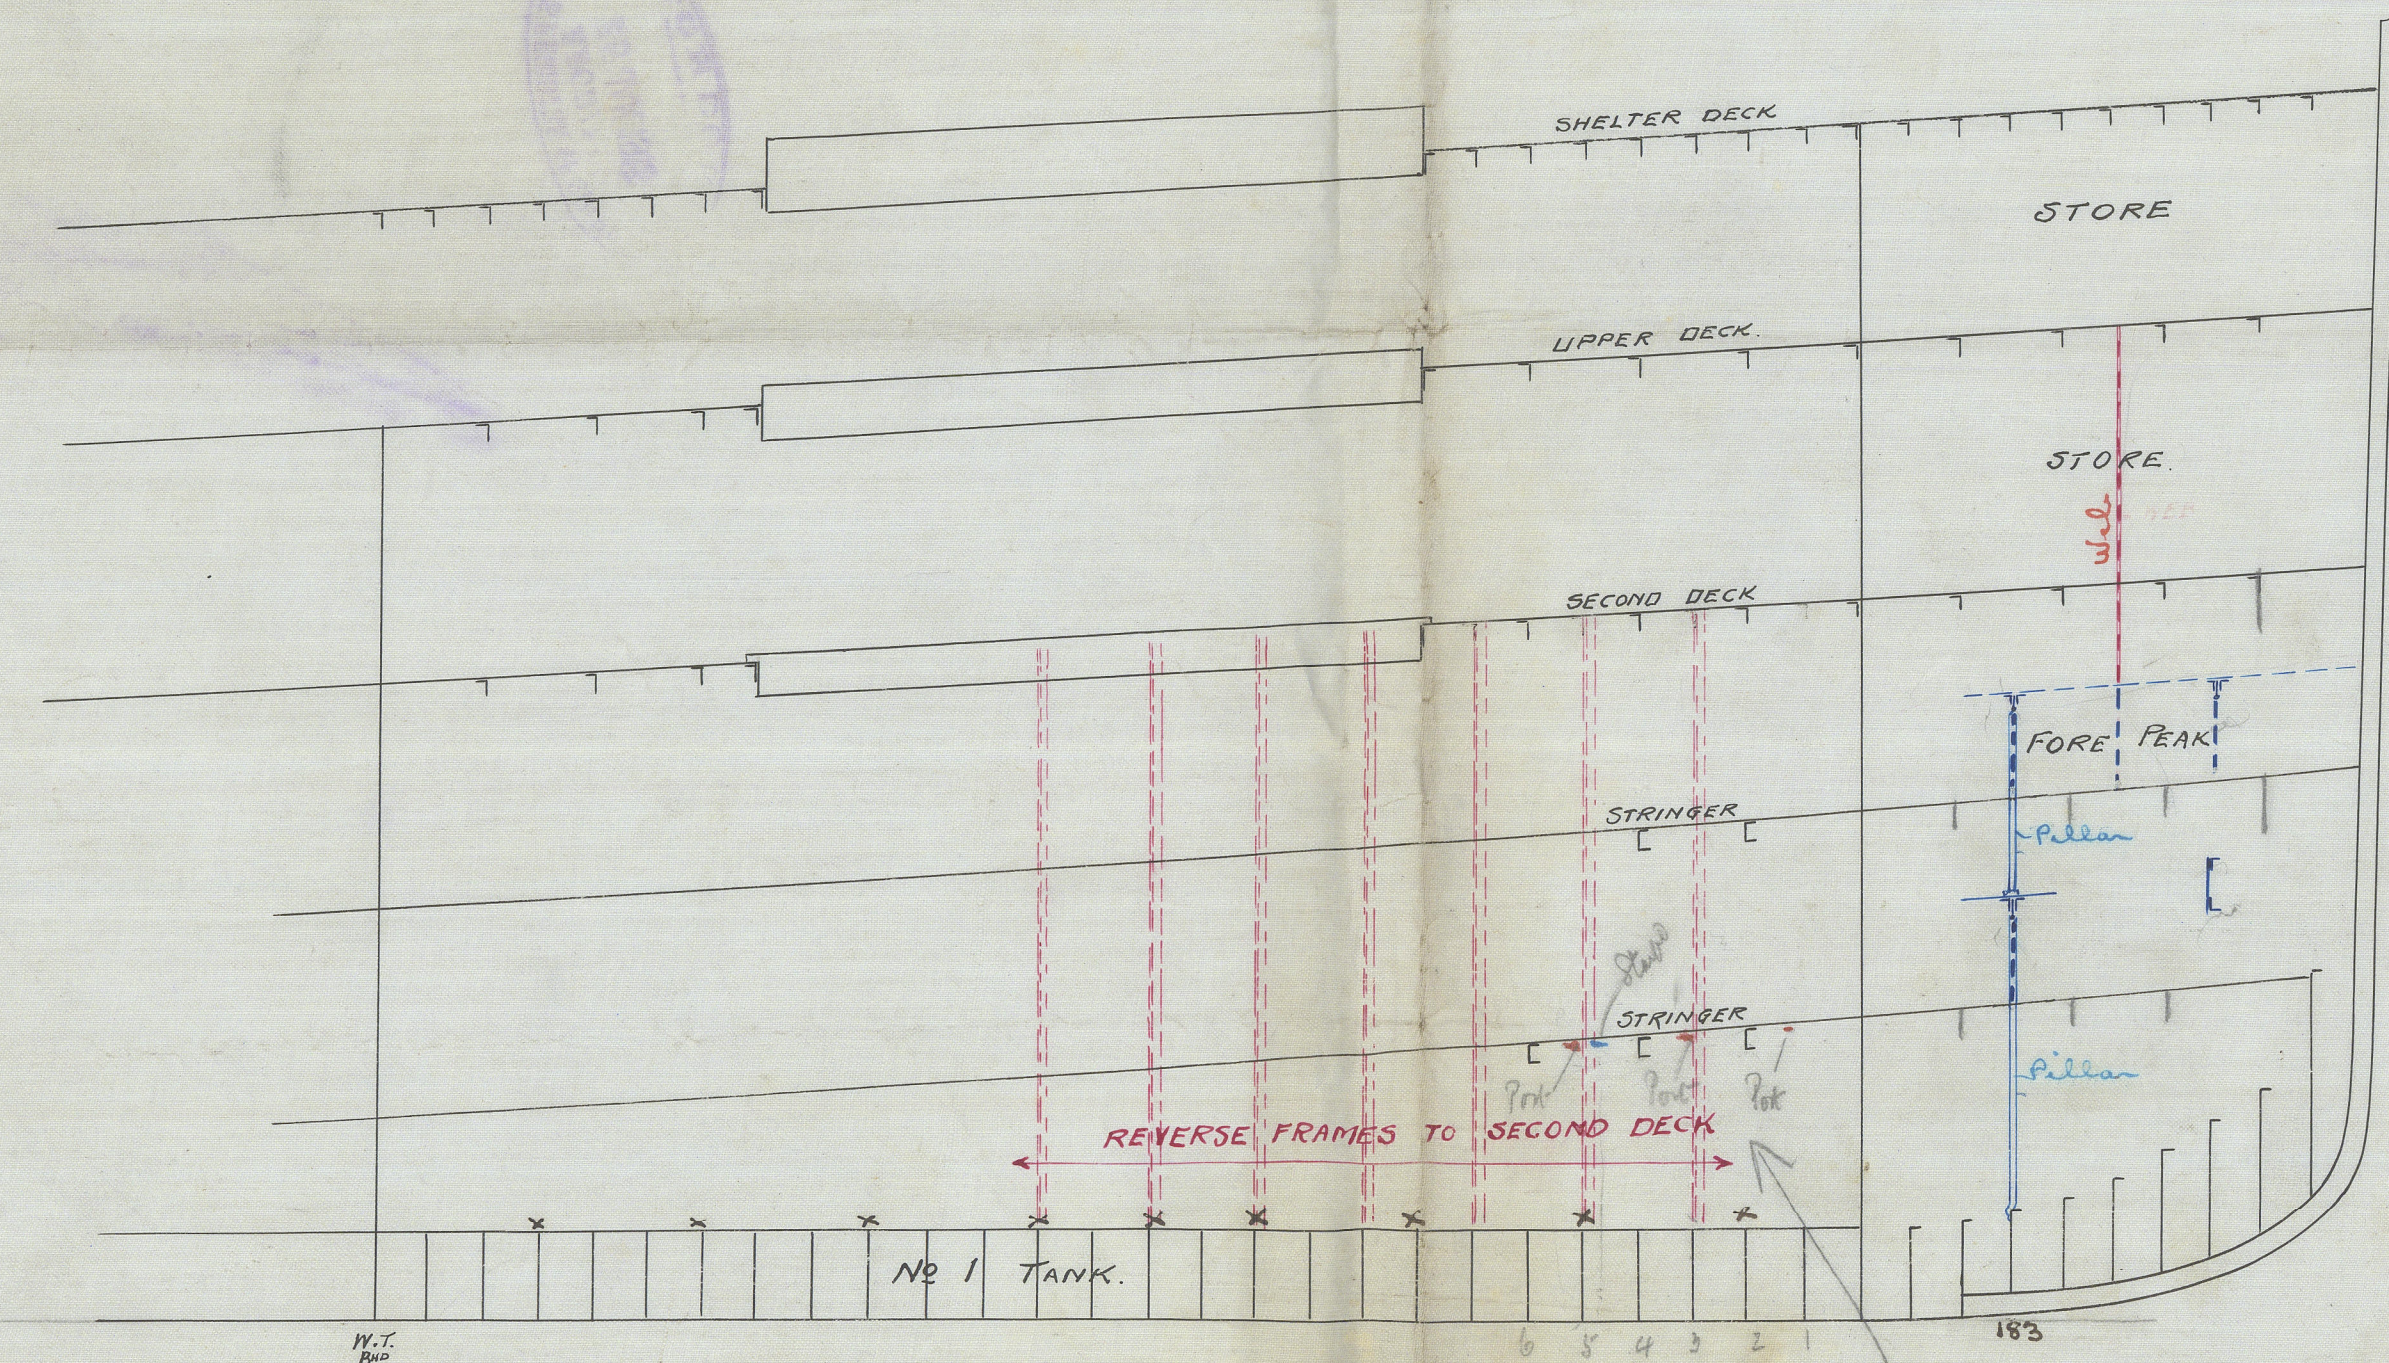

Additions in blue fitted at Hull in March 1912 - See Report No. 24773.

Additions in Red now being fitted at Hull 24/1/13.

RETAIN


The gusserts are marked thus x

Fractures in No. 2 plate in 2 strakes marked in blue on starboard side and in red on port side (3 in No. 2)






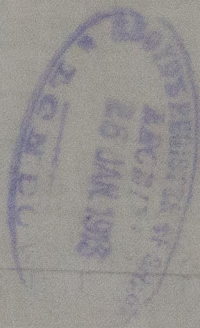


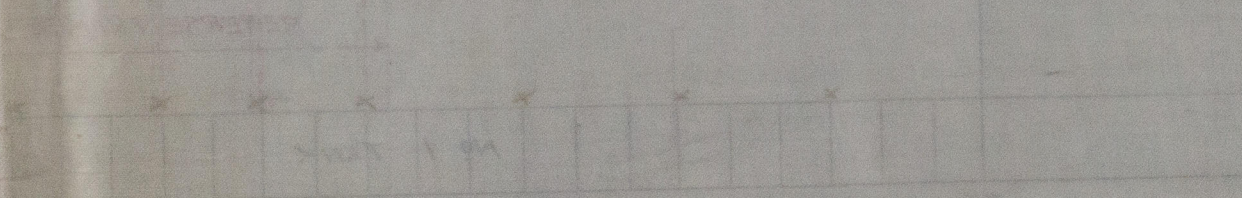


W570-0029



© 2020

Lloyd's Register  
Foundation