







Northumberland Shp. Co. Ld.  
No 141

Approved Midships Section.

NOV 1909

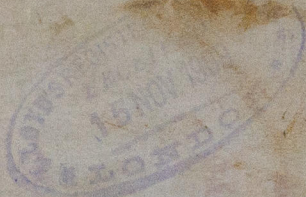

171 7/8

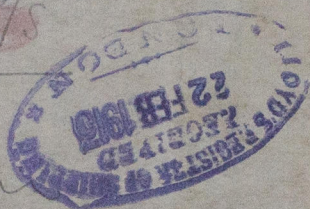




Section

NOV 27 1909

S.S. "MARENGO"

NEWCASTLE ON TYNE

REPORT No. 59055.

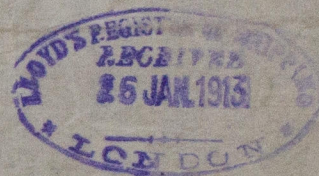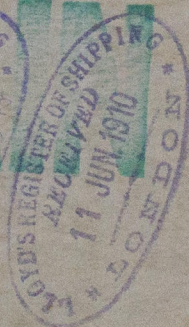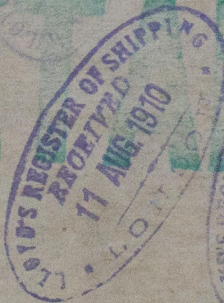

© 2020

Lloyd's Register  
Foundation

W570-0036