

S. S. Marengo

Trailing on
East Side
1st fence abt. 1.00



RETAIN





© 2020

Lloyd's Register
Foundation


W 570-00321/7

Fora Top

AFT

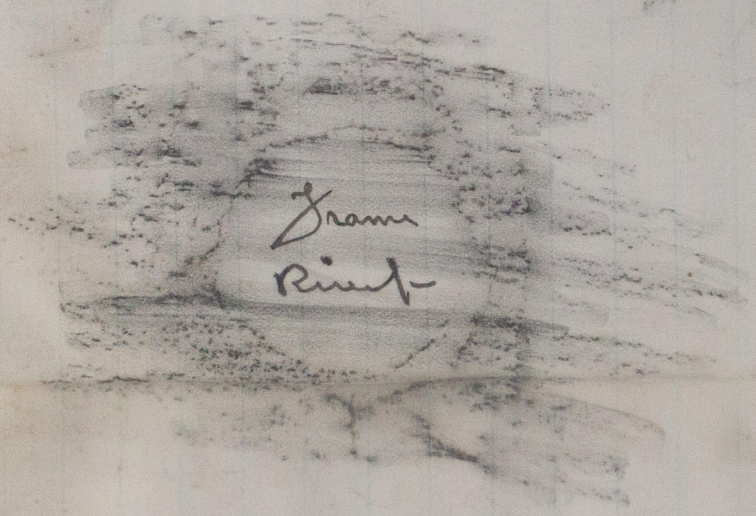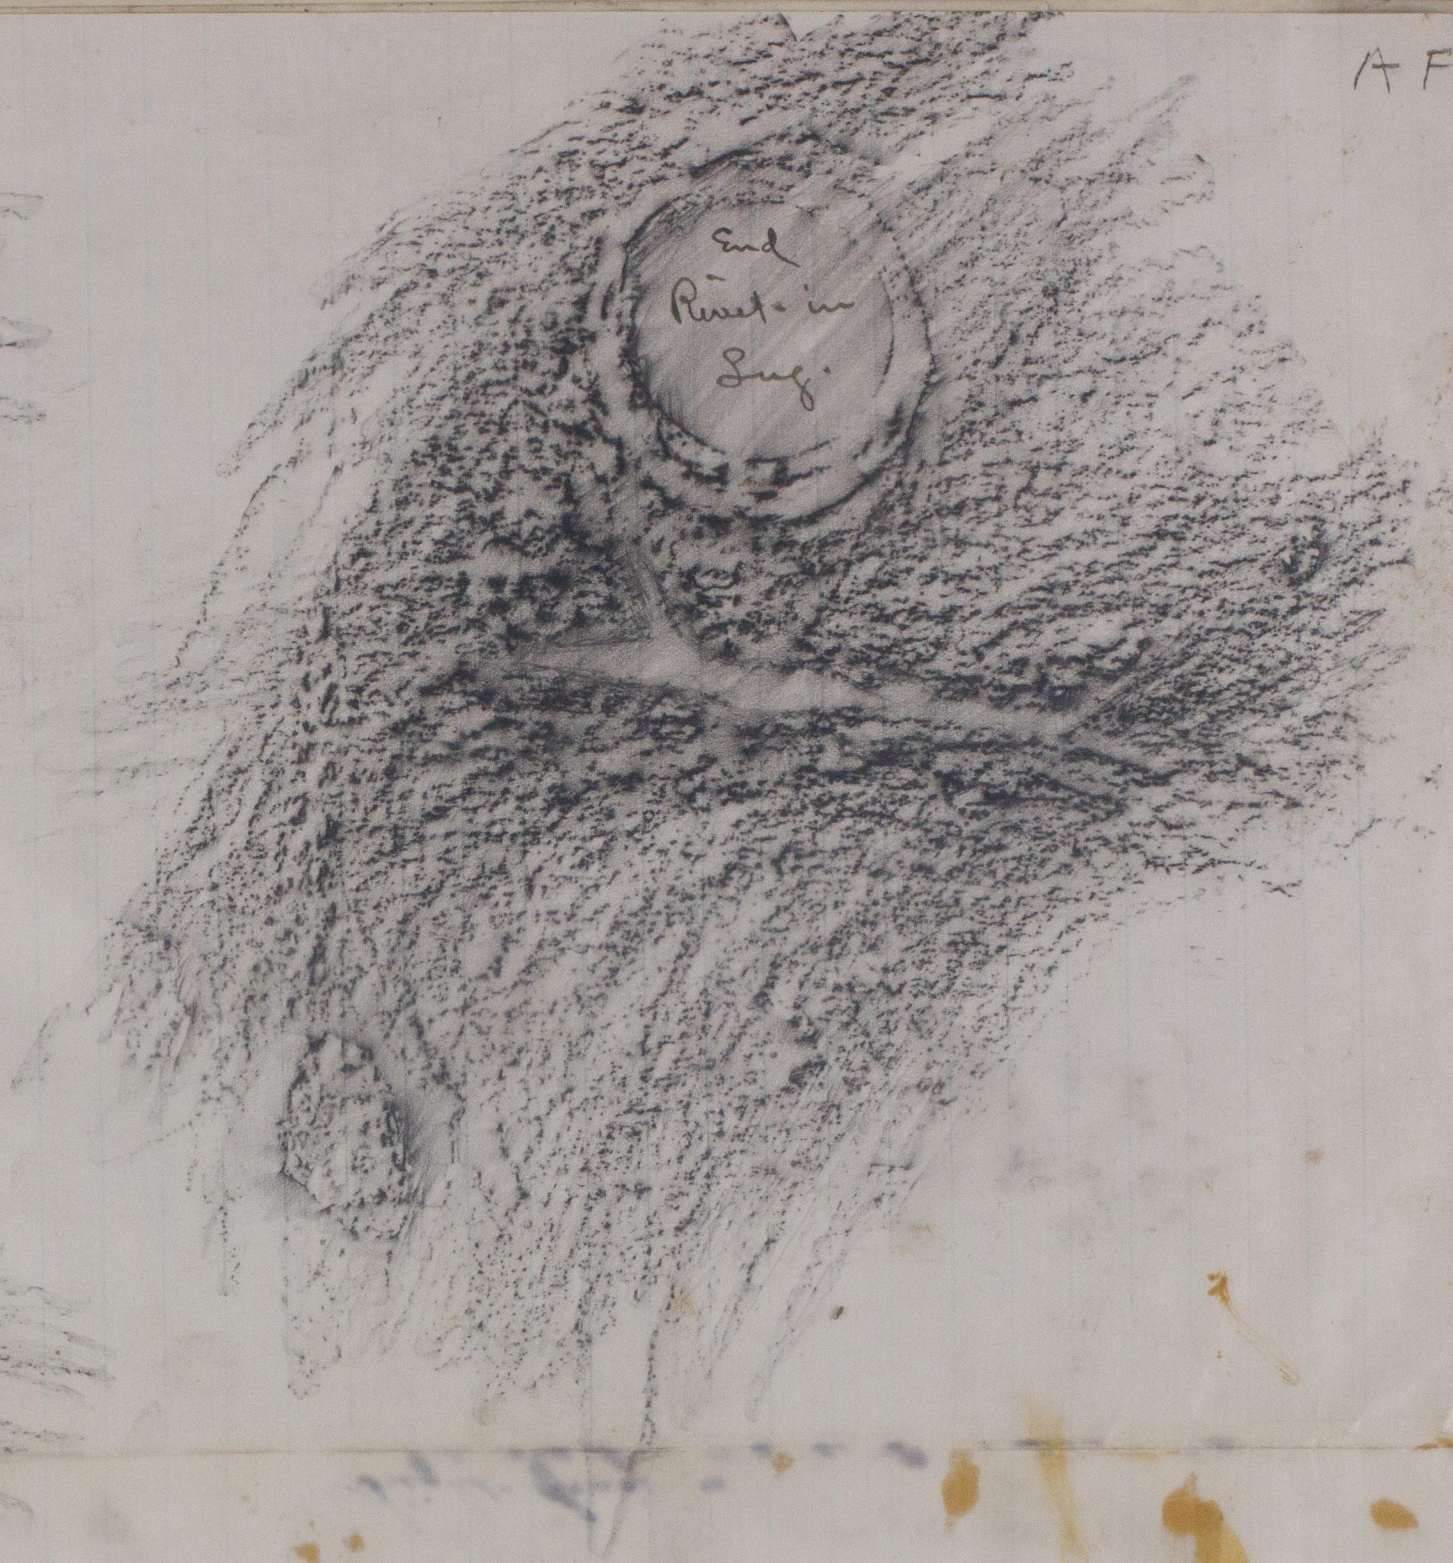

5th frame


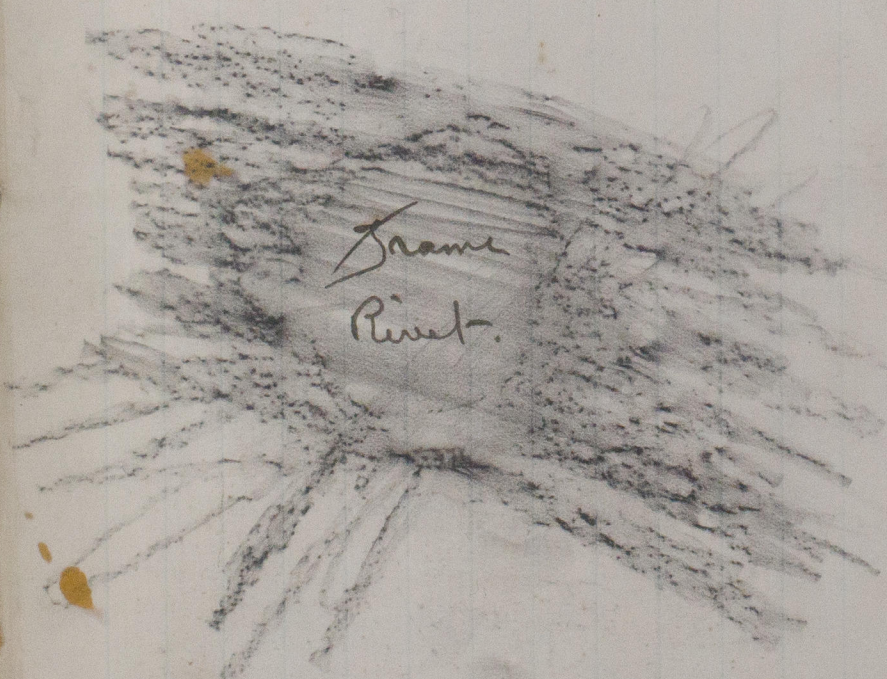


Rubbing from Portside
in 6th Space

Fracture in 6th Space abaft Collision Bulk
in E. strake No. 2 (Portside)

S. S. Marengo
at Hull
24/1/13.

AFT

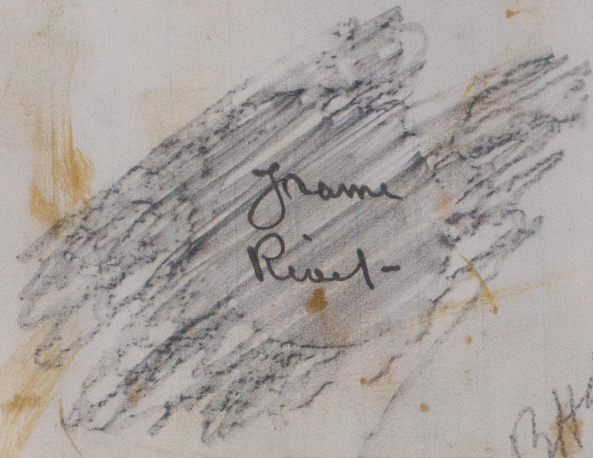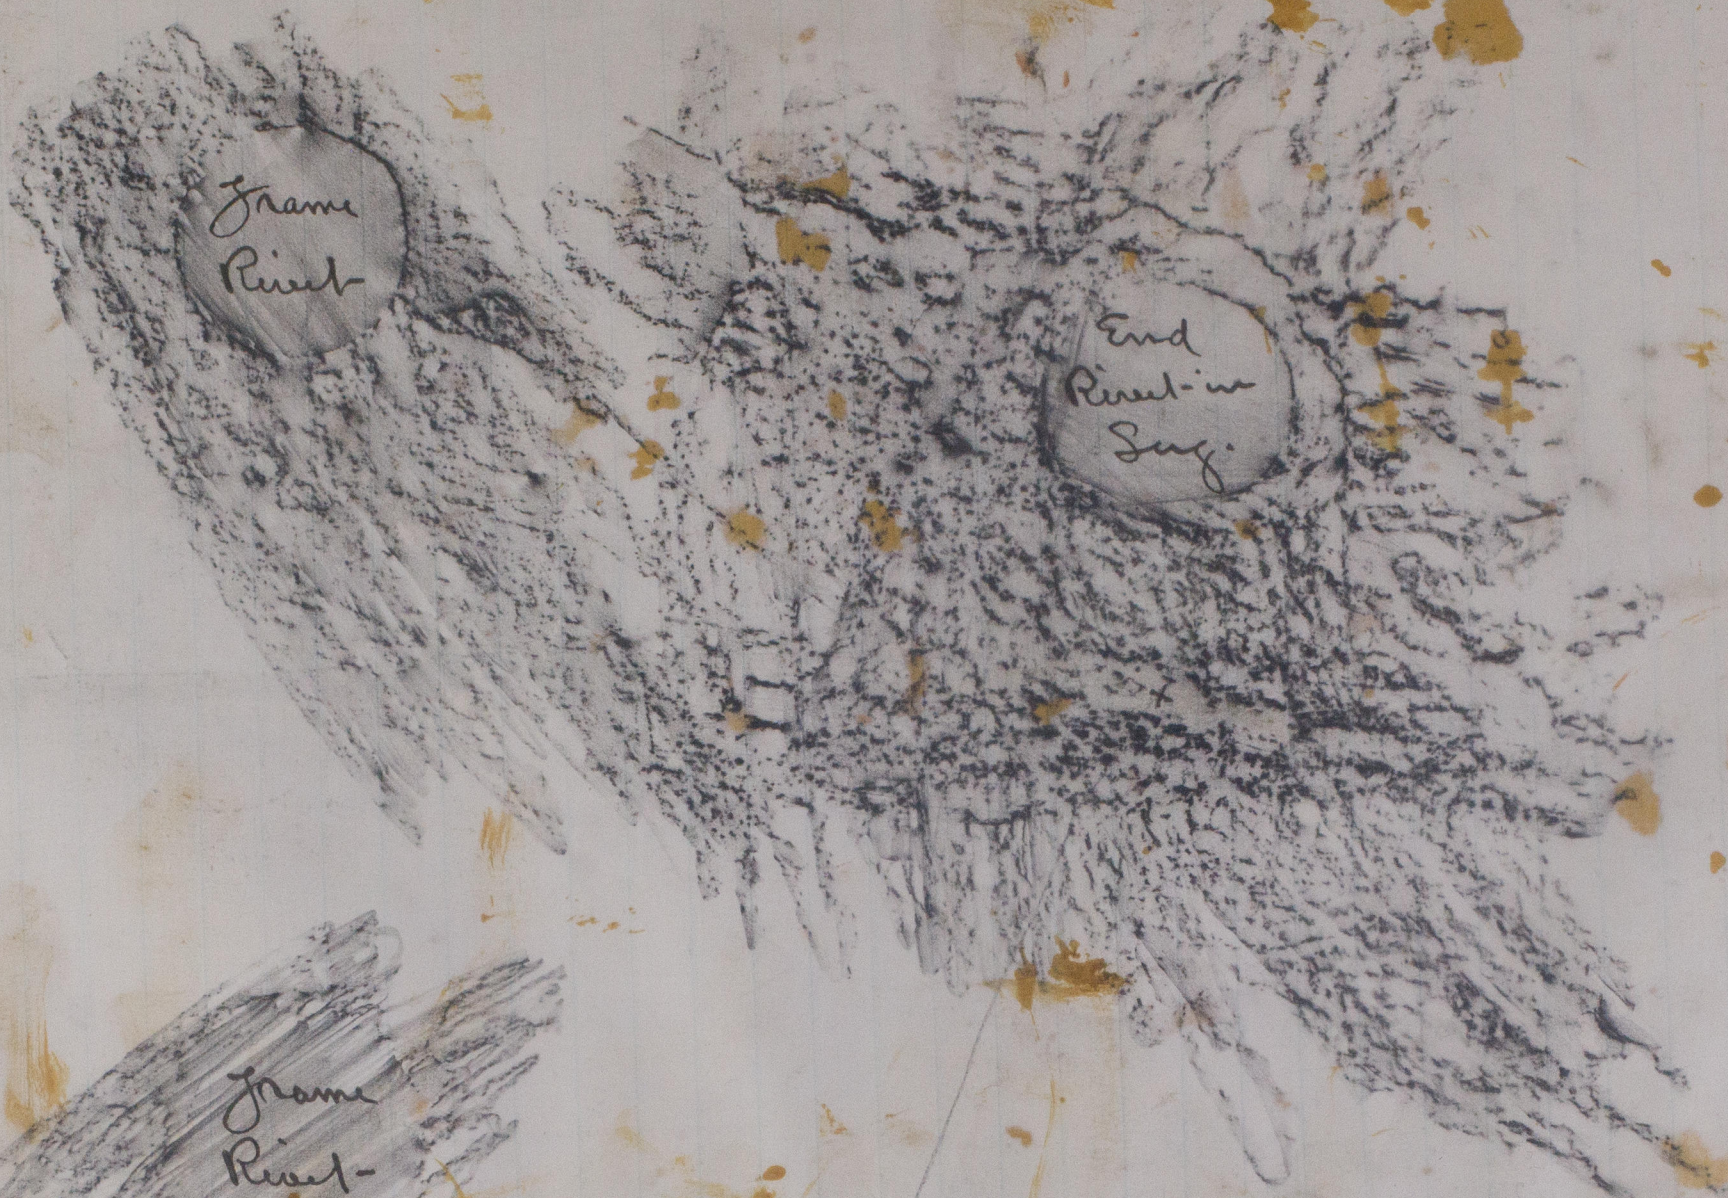


*Slight fracture
in 2nd space abaft Peak Wh. on Portside
in E. strake No. 2 from Stem.

Shell plates about 28 ft. in length.

1st frame
abaft coll.

2nd space
in 6th str. Portside

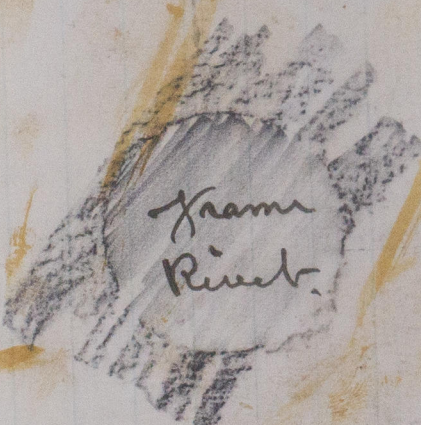

S. S. Marengo
at Hull

24/1/13.

MS10-00823/7

w570-0032 ^{4/7}



© 2010

Lloyd's Register
Foundation

AFT

End
Rivet-in
Sug

Frame
Rivet

Frame
Rivet

Rubbing on Port side

4th Space

Fracture in 4th Space abaft Collision Bulkhead
in E Strake No 2 (Port side)

S. S. "Marengo"
at Hull

24/1/13.

Frame
Rivet

W 510-0032 5/7



© 2010

Lloyd's Register
Foundation



March 10
Herbaceous
fracture in all space
Chalk Col. Blue



© 2020

Lloyd's Register
Foundation

apt. TOP

FOR²

Jaame
River-

Lower Sauting Strong rivets
End Rivet in
Gug

Jaame
River-

Rubbing from Starboard side

□ Stroke 2nd from Stem
5th space abaft Coll. BHC

Jaame
River-
abaft BHC

Fracture in 5th space abaft Collision BHC
in E Stroke No. 2 (Starboard side).

S. S. Marengo
at Hull

24/1/12

Jaame
River-

MS10-003271



© 2020

Lloyd's Register
Foundation