

3'-19 AT FRONT
72" BACK

2. 16" x 12" MANHOLES AT BACK

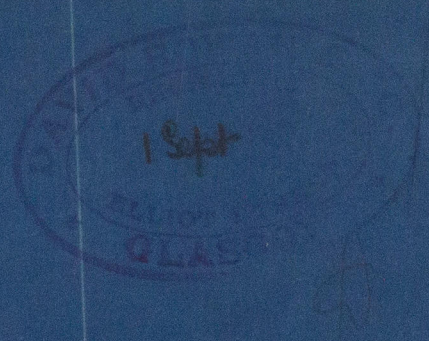


PLATE STAYS $2\frac{1}{2}"$ DIA = 8'-4 $\frac{1}{2}"$
HOLE $2\frac{1}{2}"$ = 12'-0 $\frac{5}{8}"$

Alteration to position of landings.
on wing fireboxes.
Main Boiler
Cont No 513.

O.T. 11691A

From DAVID ROWAN & CO., GLASGOW.

ENCLOSURE

FOR

Messrs Lloyds Survey.

WS73-0036 2/2

