

SCALE $\frac{1}{2}$ " = ONE FOOT

.62 ✓
Treble overlaps



Found

MIDSHIP SECTION

GRAY'S S.S. N^o 830

S.S. Orna

HPL. RPT. N^o 14783.

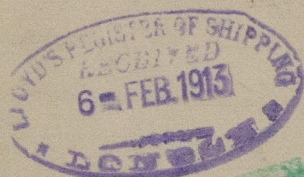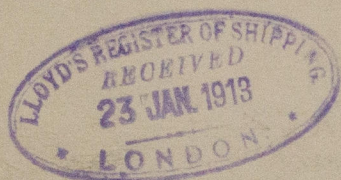


RETAIN



© 2020

W/S 78-001

Lloyd's Register
Foundation

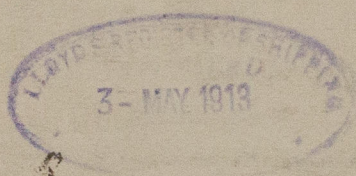

© 2020

Lloyd's Register
Foundation