


14.12.05
1.1.06

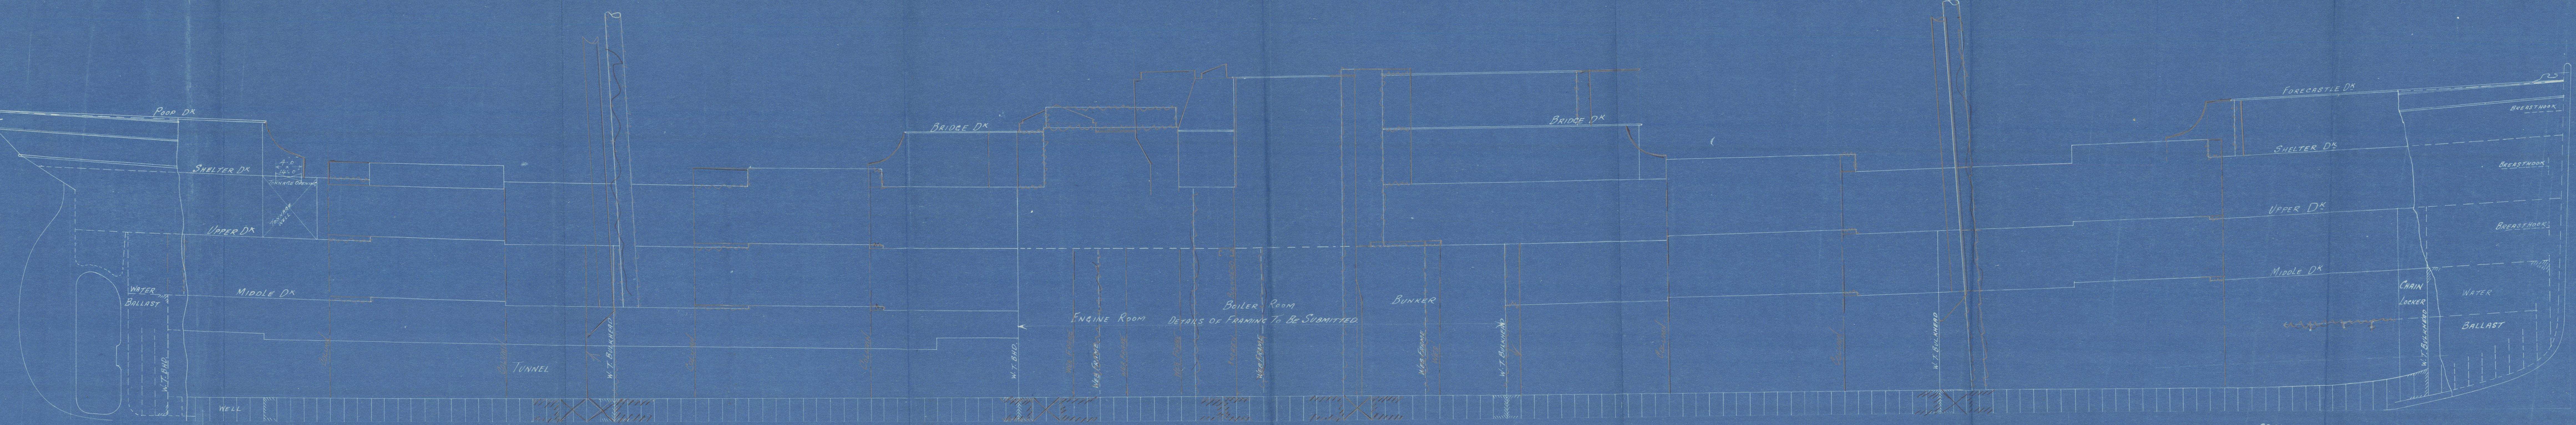

BULB ANGLE FRAMES
6 1/2 x 3 1/2 x 20

FRAMES BULB ANGLE
7 1/2 x 3 1/2 x 20

BULB ANGLE FRAMES
7 1/2 x 3 1/2 x 20

LONGITUDINAL ELEVATION
PROPOSED S.S. 370' x 49' x 25'-4" (KEEL TO BEAMS)

SCALE 1/8" = 1 FOOT

NOS 383 & 4

BULB ANGLE FRAMES
7 1/2 x 3 1/2 x 20

BULB ANGLE FRAMES 7 1/2 x 3 1/2 x 20

BULB ANGLE FRAMES 6 1/2 x 3 1/2 x 20

Messrs Harland & Wolff Ltd.

SS 384

Profile plan

Copy

S.S. Prabsu

Bel.

Duplicate of

SS Aburi

Bel 6240

S.S. Sierra Leone


Bel 6250

S.S. Hulani

Bel.



RETAIN

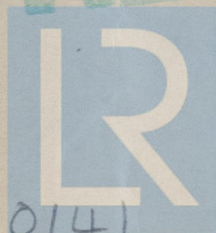

© 2020

Lloyd's Register
Foundation

W575-0141