



12.2.04
11.5.08

POOP. BRIDGE AND FORECASTLE.

REGISTRO ITALIANO
MODULA

$380'0'' \div 46'6'' = 8.125$
 $8.125 \times 30'3'' = 246'9'' = 4'6''$
 $46.5 + 4.08 = 50.58 \div 3.28 = 15.42 \text{ METRES} = \text{LONGITUDINAL MODULA}$
 $46.5 + 4.08 = 50.58 \div 3.28 = 15.42 \text{ METRES} = \text{TRANVERSE MODULA}$

PROPORTIONS		
BREADTHS	TO LENGTH	9.13
DEPTHS	UPPER DK	12.82

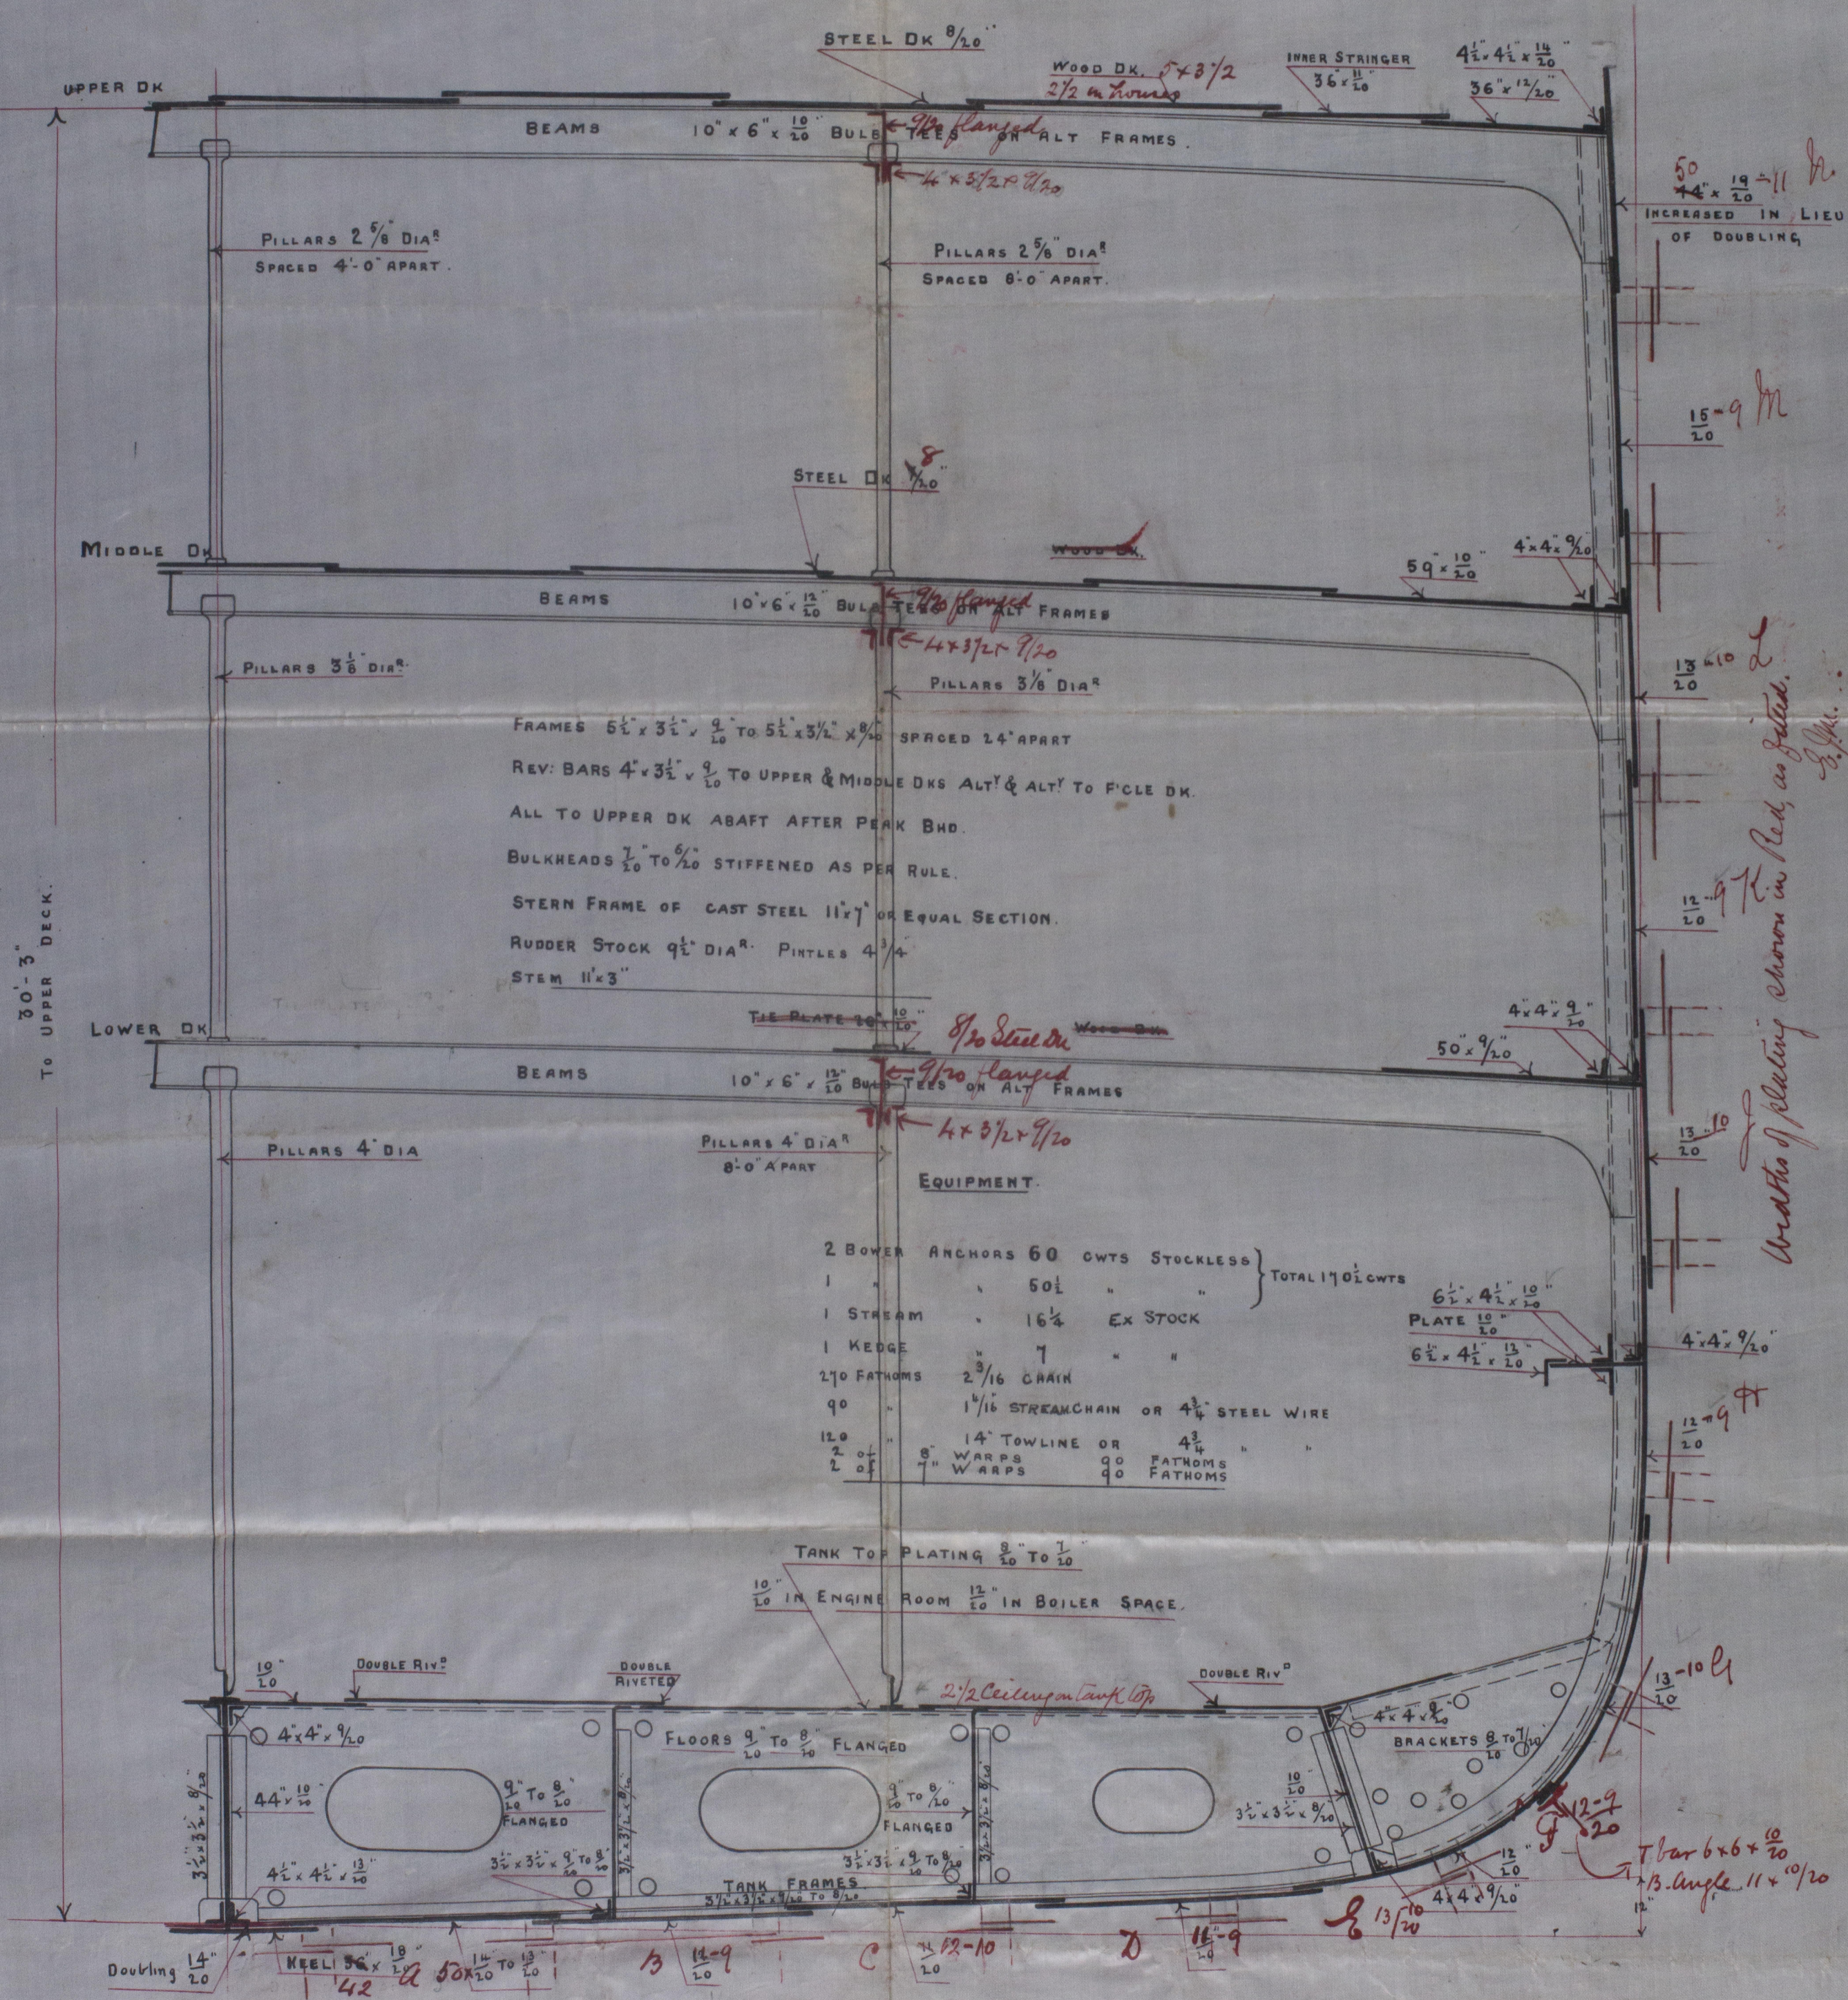

Methods of plating shown in Red, as before.
E. J. M.
2

J.H.L.
11/2/04

6/2/04

9 FEB 1904

9 FEB 2021
Lloyd's Register
Foundation
W577-0033

Belfast
Harland & Wolff's
S.S. 300 x 46.6 x 29.6
Midship Section

No. 368

S.S. Bologna

Bel 5915.

[Handwritten signature]

R

SECTION

© 2021

Lloyd's Register
Foundation

W577-0033