


PROFILE.

SCALE $\frac{1}{8}" = 1 \text{ FOOT}$

DIMENSIONS 395'-0" x 51'-0" x 30'-0" D.M.

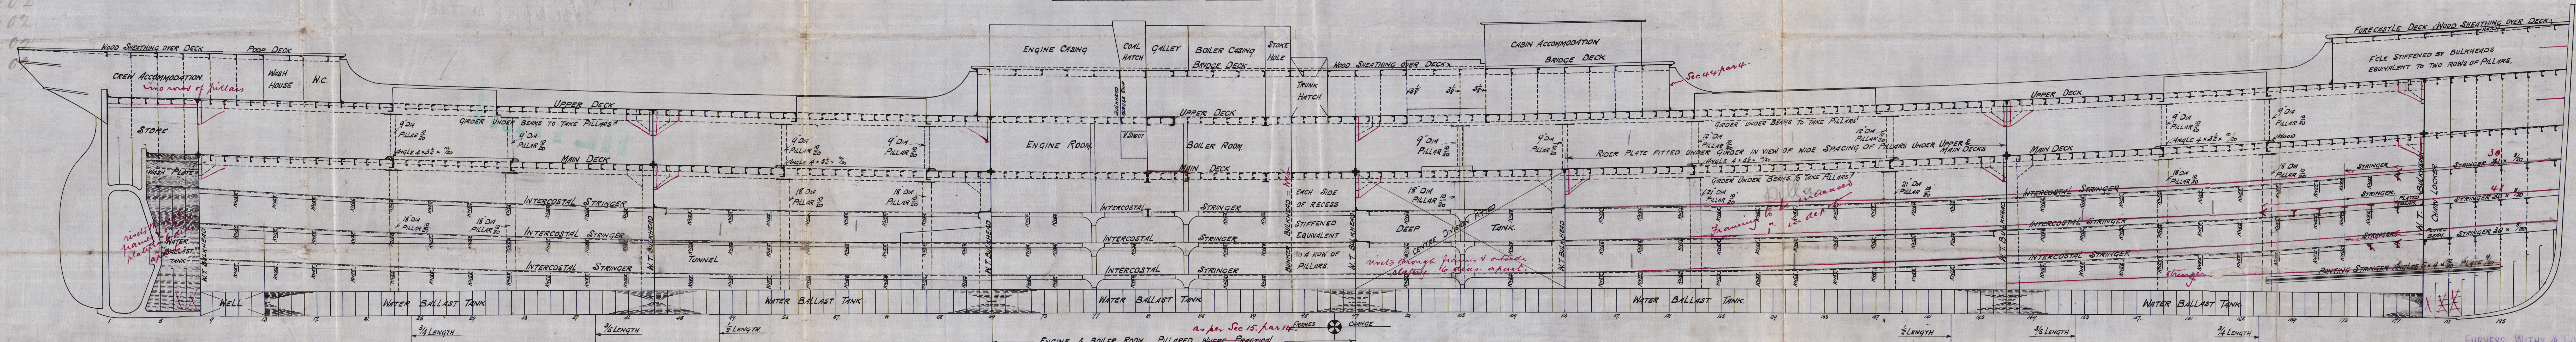

No 266. & 267.

No 266. & 267
FURNESS, WITHEY & CO., LIMITED.
SHIPBUILDERS & REPAIRERS,
WEST HARTLEPOOL.

10/10/02
19/6/02 29.8.02

Lloyd's Register
5178101020

Gurness, Wither & Co.

No 266. & 267


Profile.

No. 266 "Llan Macintyre"

Hpl Report No. 12194

No. 267 "Llan Macloed"

Hpl Report No. 12166

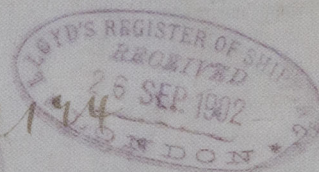

RETAIN



© 2021

Lloyd's Register
Foundation