


MIDSHIP SECTION

SCALE $\frac{1}{2}$ INCH = 1 FOOT
395'-0" x 51'-0" x 30'-0" D.M.

11.6.02
20.6.02
29.8.02 (A. 267)
30.9.02

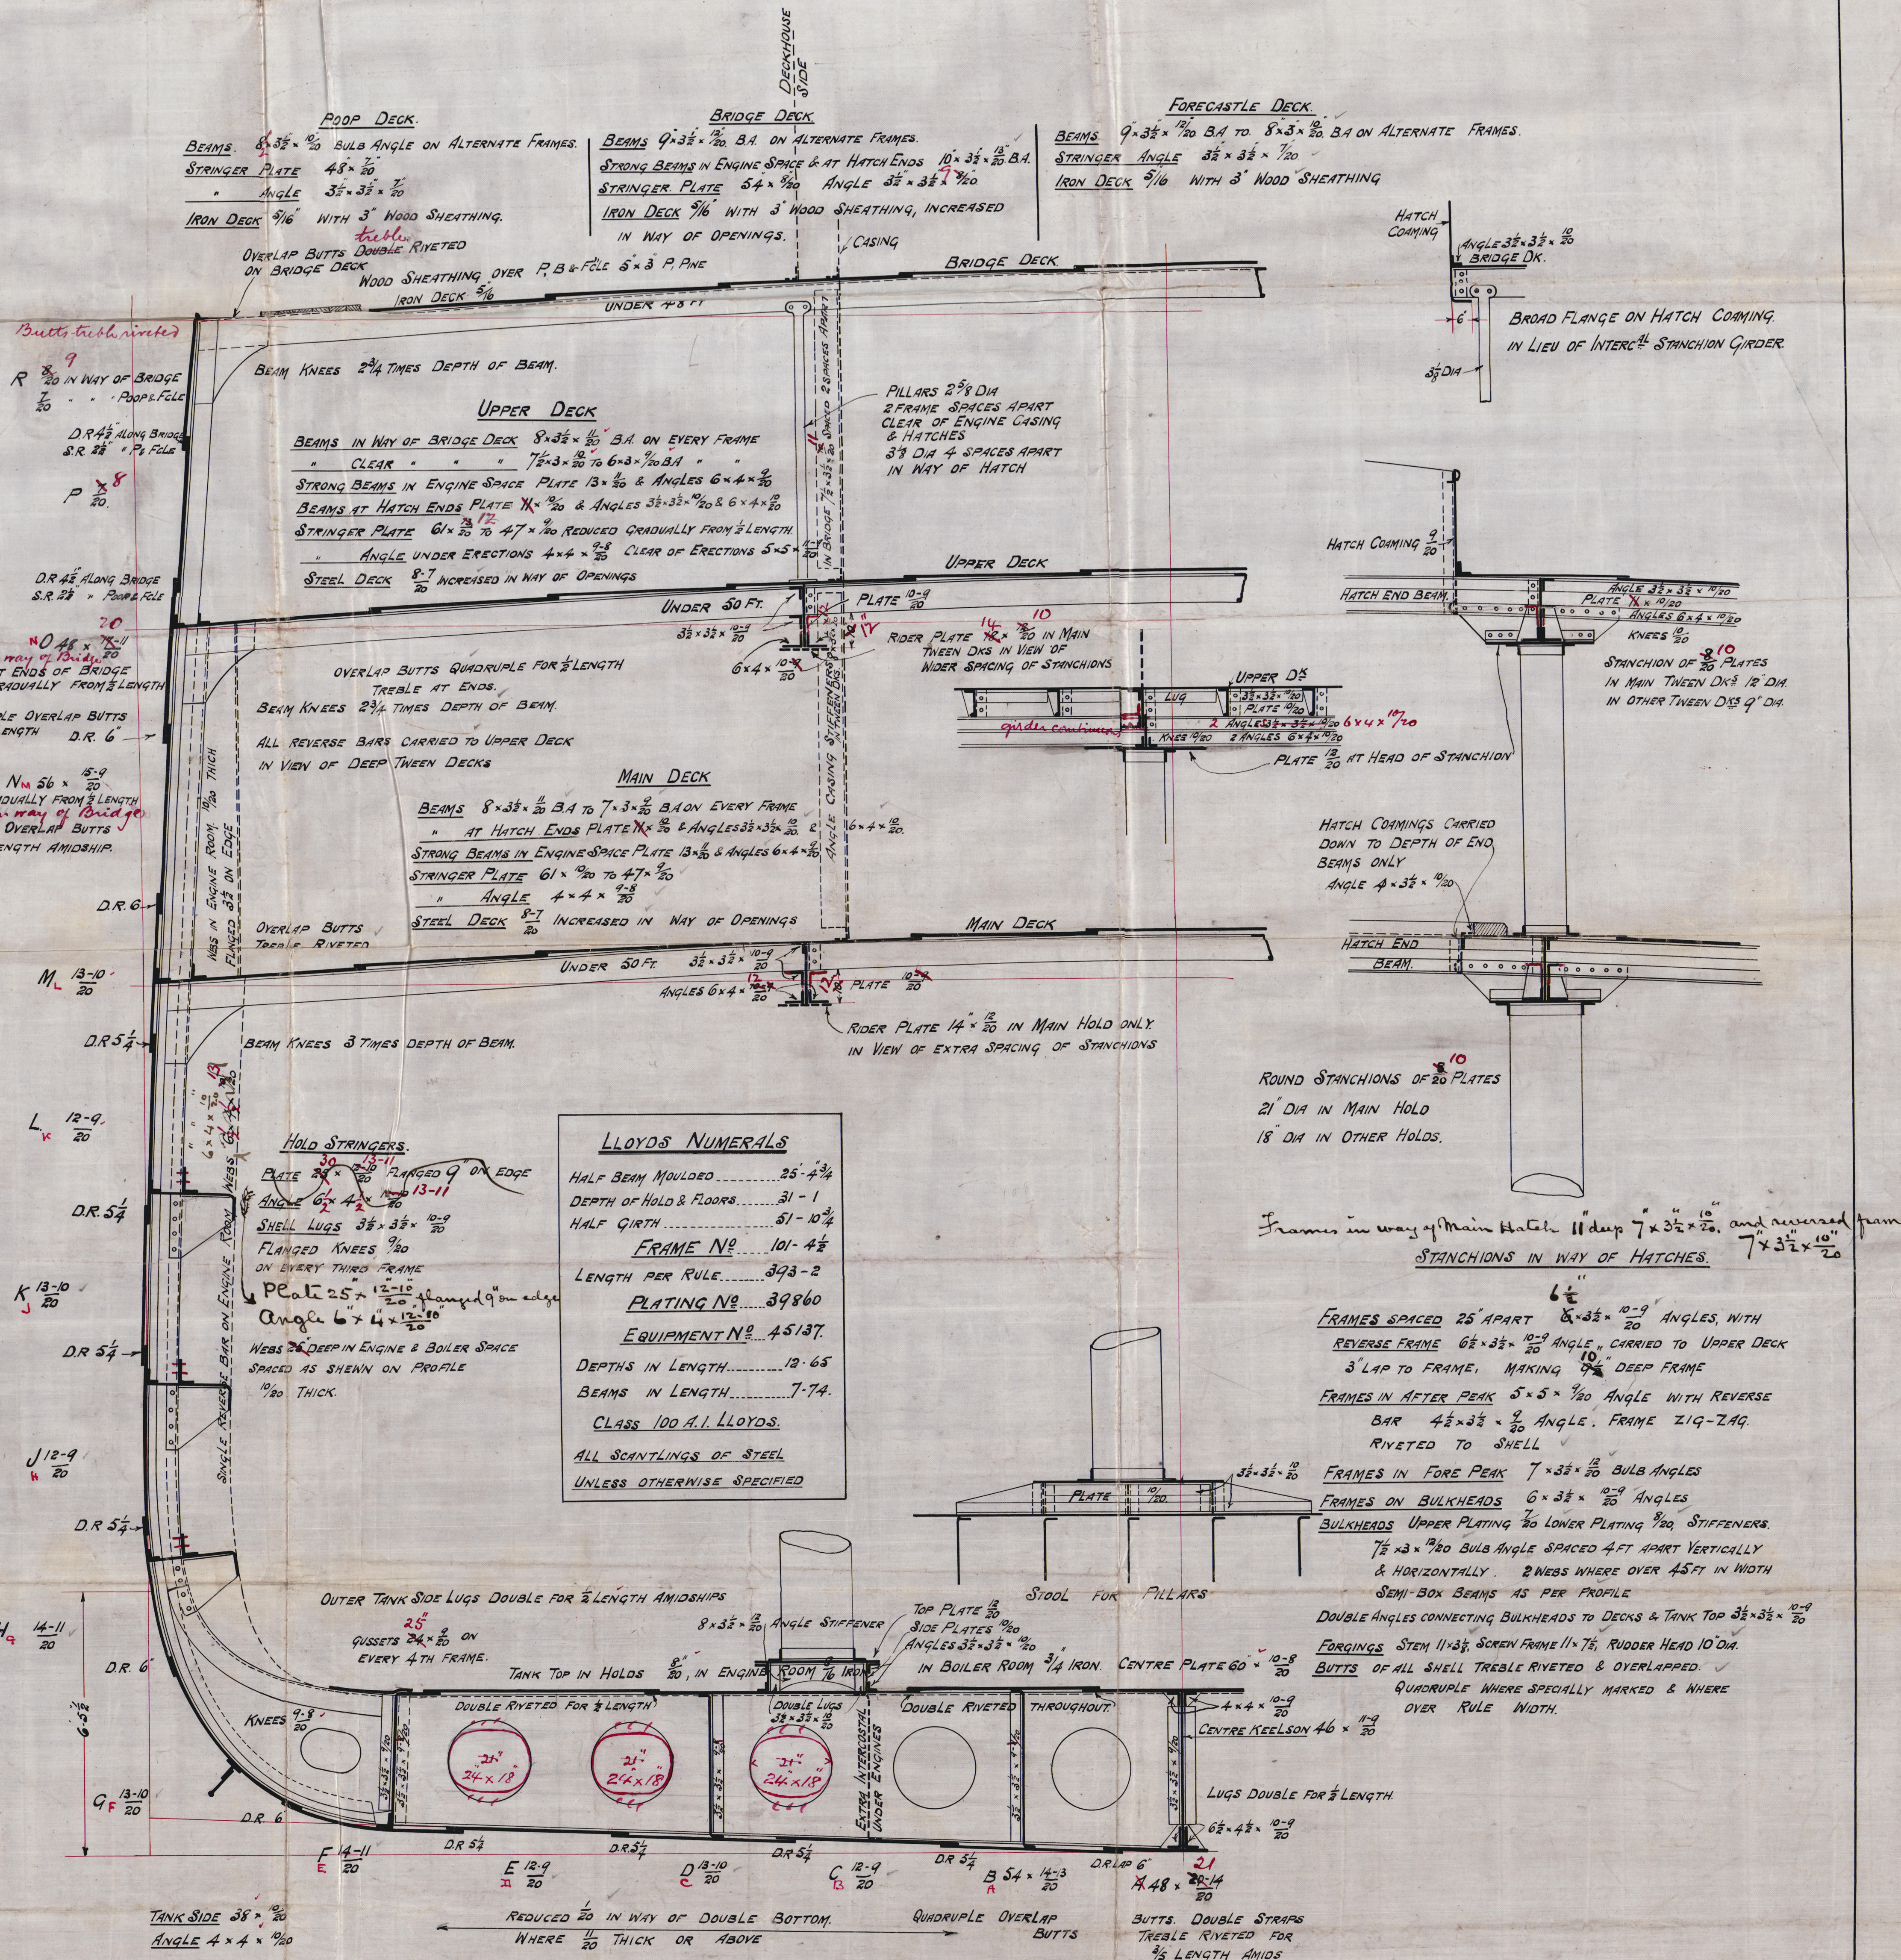

N^o 266
& 267

29.8.02

