



28.11.06
19.12.06

EQUIPMENT NUMERAL (ALTERED)		
1	31.50	
2	8.50	
3	4.00	
4	13.15	
5	751.2.2.3	
DECK ERECTION BELOW SHELTER DECK 547.92482-6875.04		
	ABOVE	2070.00
	FROM DECK	2772.00
	BOAT DECK	372.00
		12700.04

"TENYO MARU"

NOS 190-1
MIDSHIP SECTION.
SCALE $\frac{1}{2}$ " TO ONE FOOT.
TRIPLE SCREW TURBINE ENGINES.

PRINCIPAL DIMENSIONS.		
LENGTH BETWEEN PP	550'-0"	
BREADTH MOULDED	63'-0"	
DEPTH MOULDED TO UPPER DECK	38'-6"	38'-8" at Midships
NUMERALS		
1 B	31.50	
2 G	60.65	
D	40.00	
137 15		
130.15	181 N.	
L	547.92	
71311.79	210 N.	
PROPORTIONS		
50 TO UPPER DECK = 13.70	50 TO SHELTER DECK = 11.42	50 TO 8.70

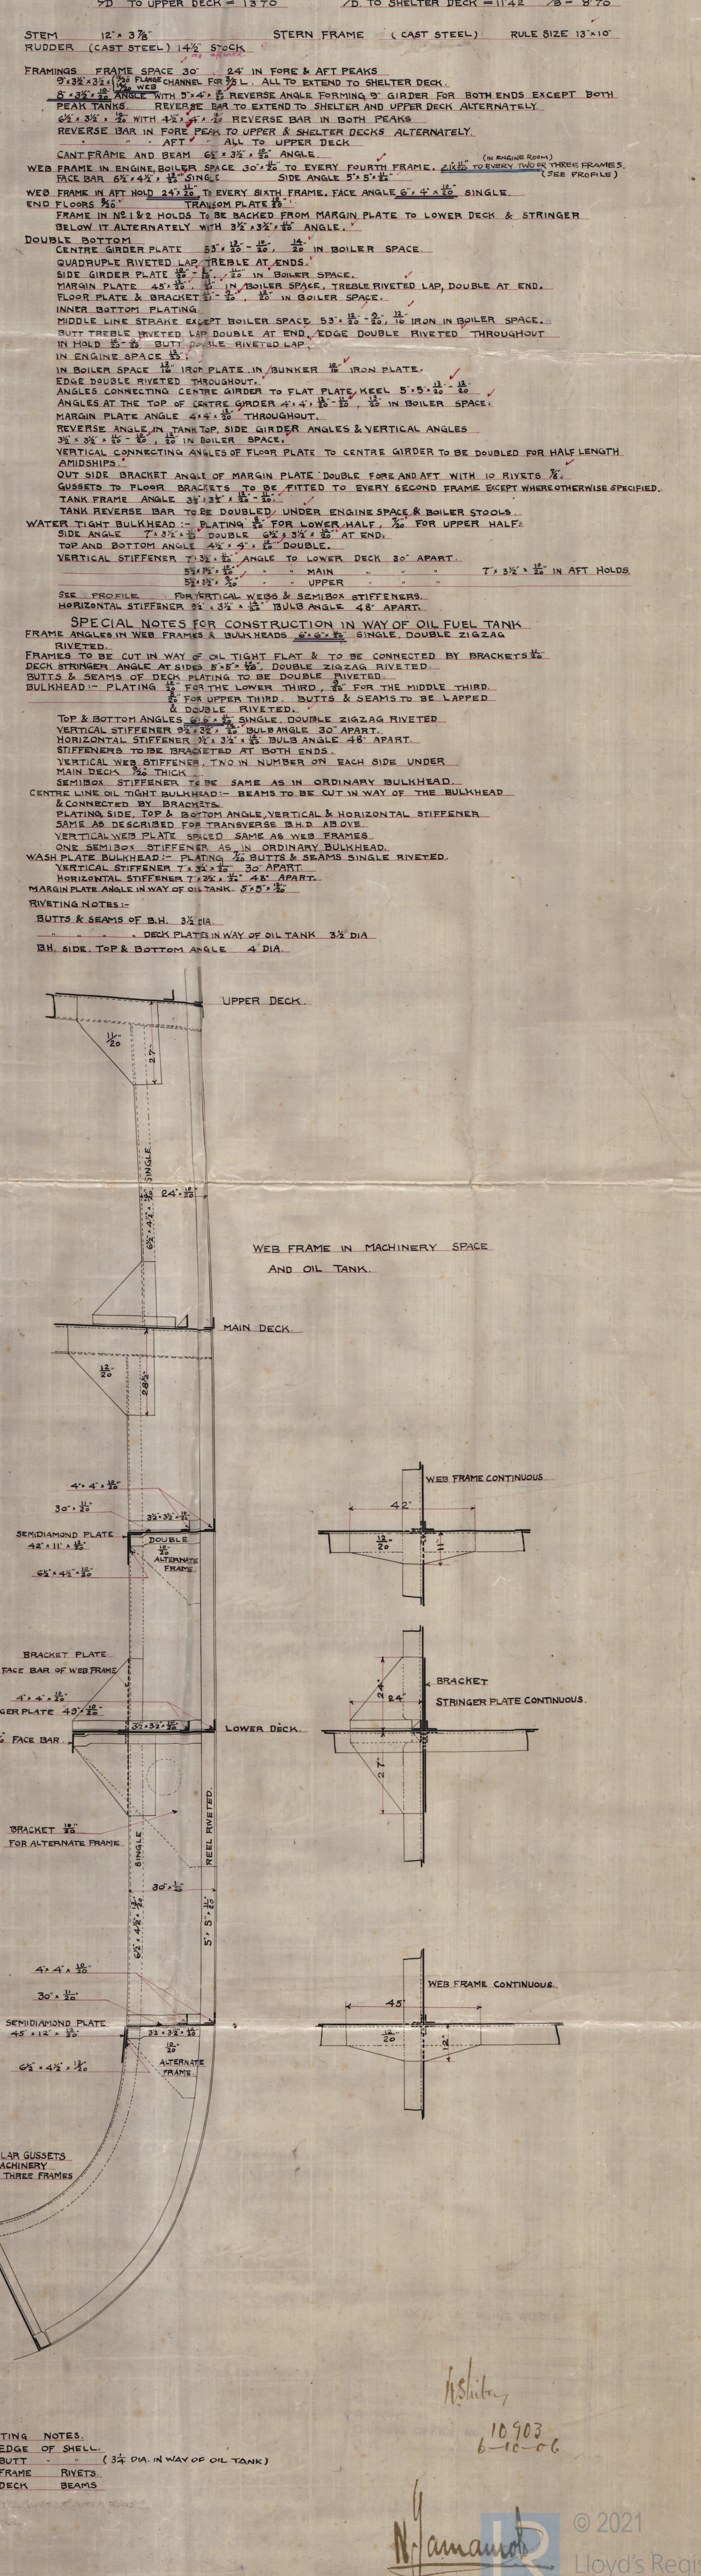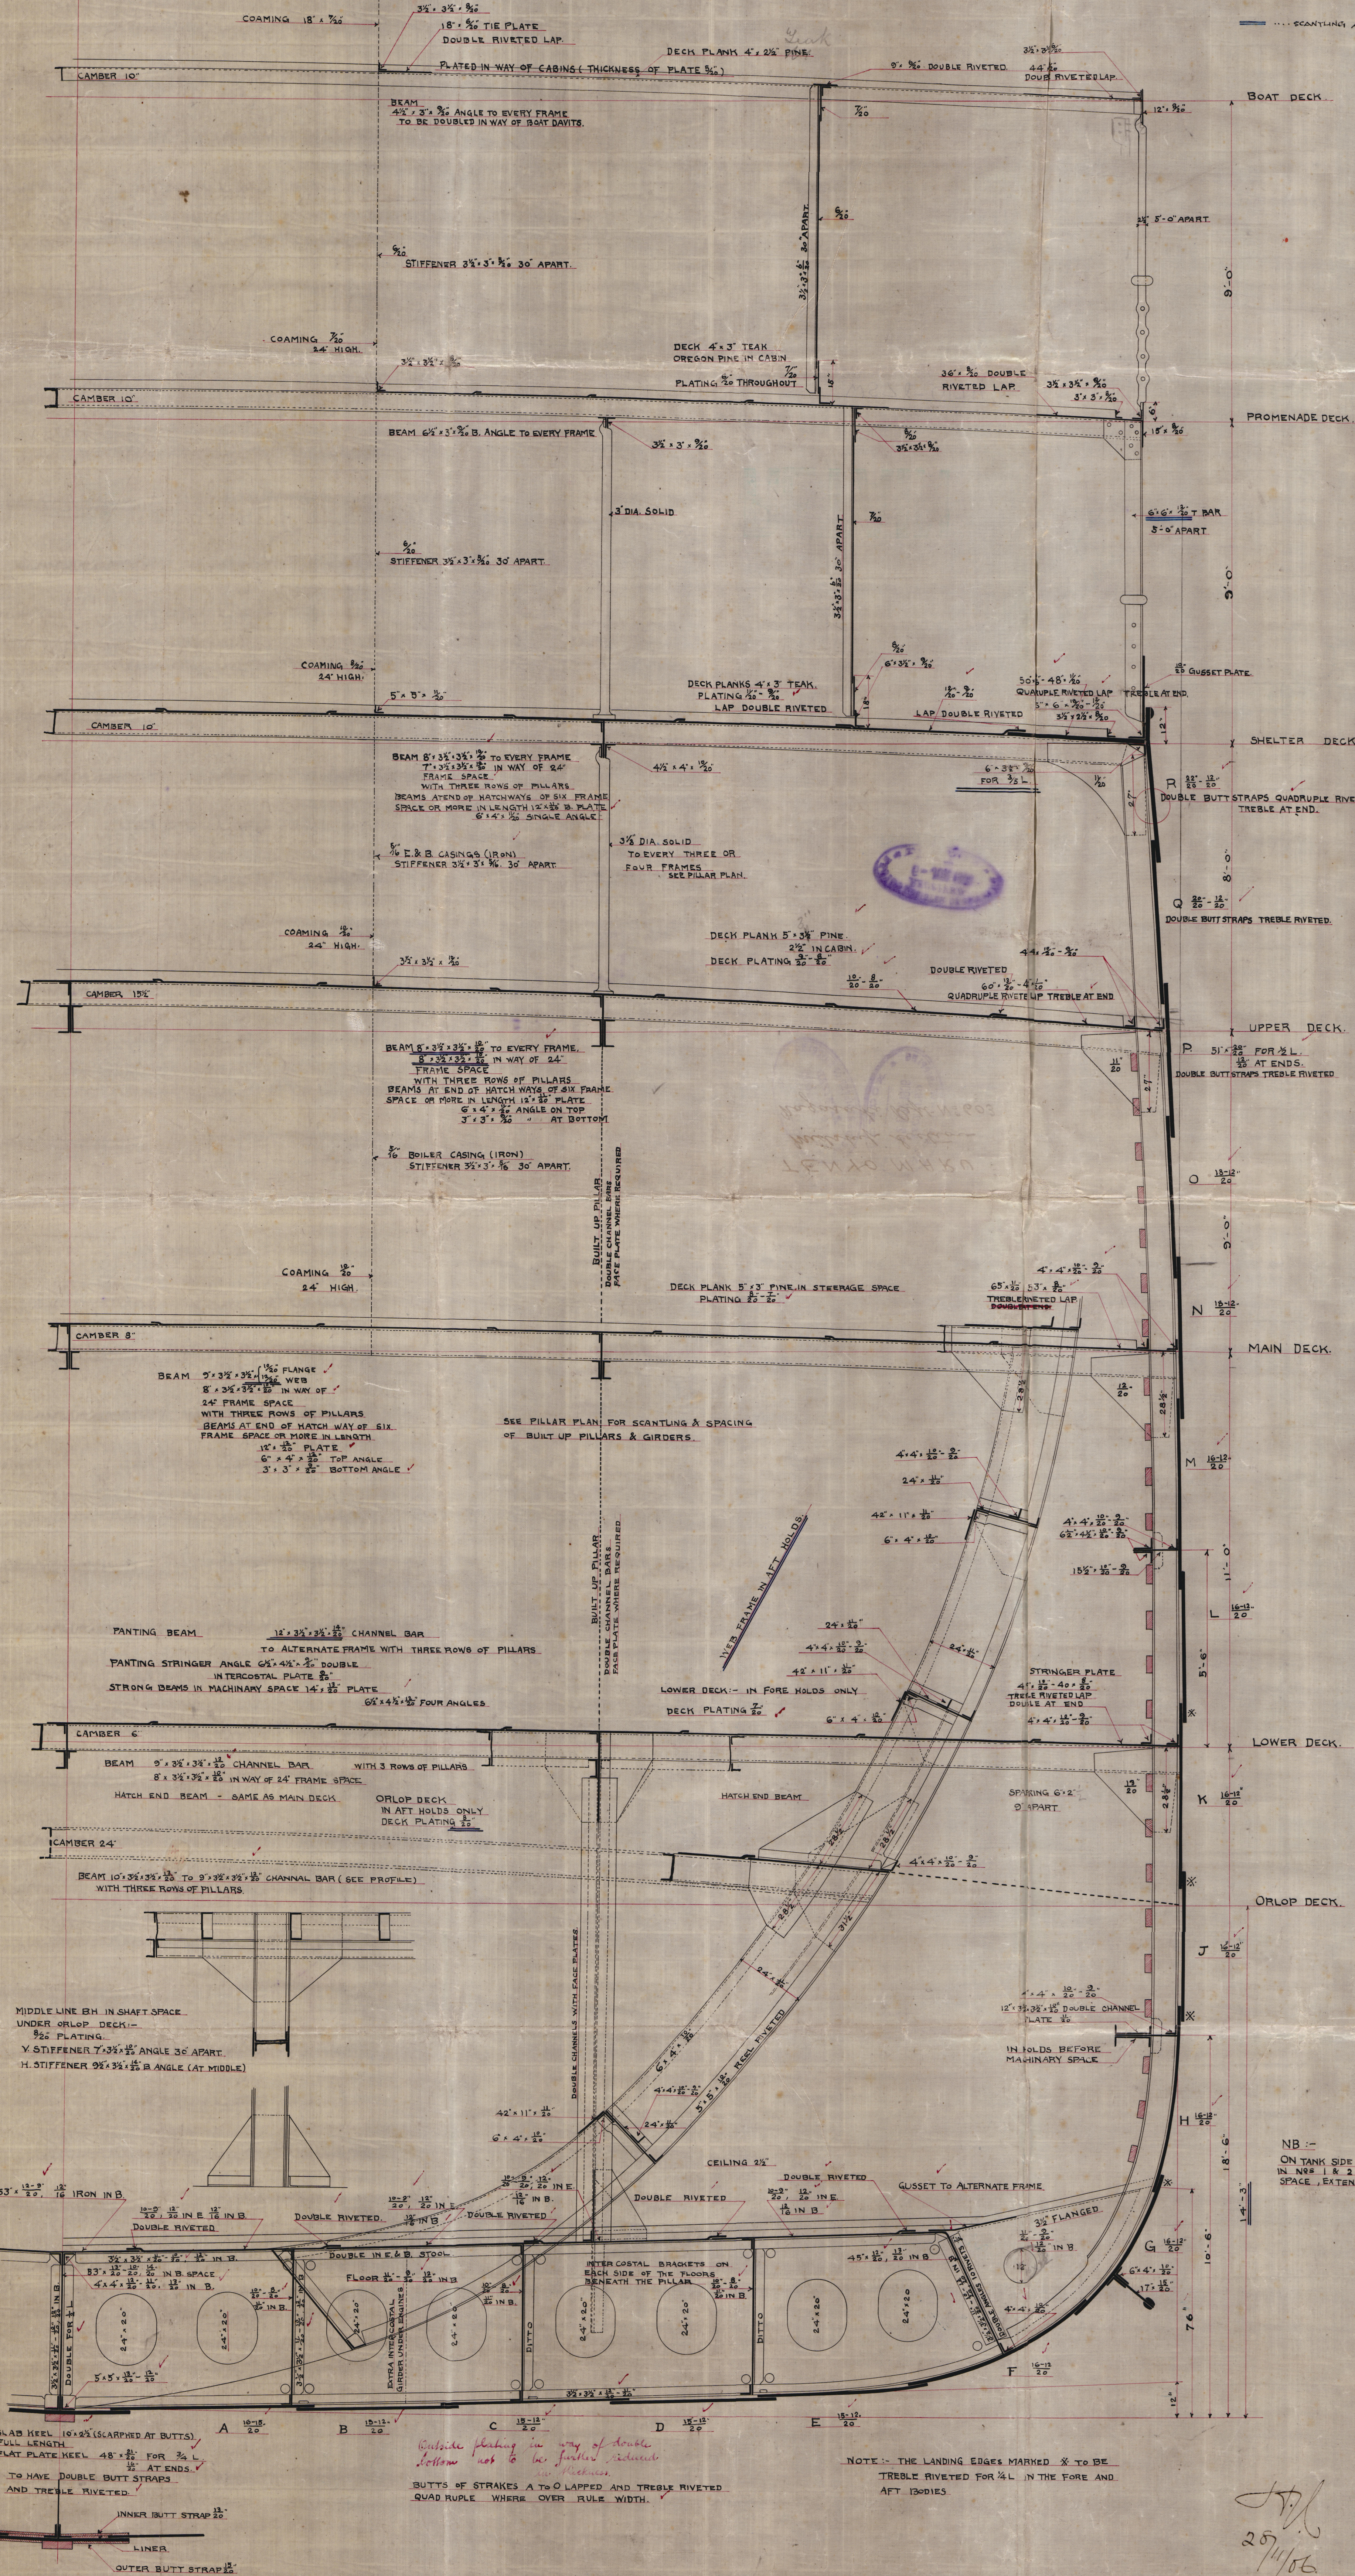

NOTE: THE LANDING EDGES MARKED X TO BE TRIPLE RIVETED FOR 1/2 L IN THE FORE AND AFT 1300 LBS.

10903
6-10-06

Madship Sect
Nagasaki Rept N



Lloyd's Register
Foundation