

~~18-12-01~~

N^{OS} 190 & 191.
UPPER DECK PLAN.
SCALE 1/4" TO ONE FOOT.



MITSU-BISHI
 DOCK YARD & ENGINE WORKS
 NAGASAKI
 DRAWN BY
 TRACED BY *S. Kido 28 May 56*
 CHECKED BY *W. S. Liba*
 APPROVED BY
 DRAWING OFFICE No. *10906*
 DATE *6-1-56*

NB:-

THICKNESS ALTERS

28/11/06

"TENYO MARU"
Upper deck
Nagasaki Rept N:603

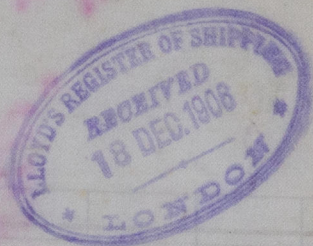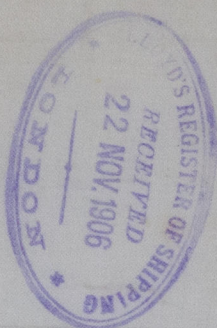

© 2021

Lloyd's Register
Foundation

W578-0175