


28.11.06  
18.12.06


TRIANGULAR WEBS TO BE  
FITTED ON BOTH SIDES OF  
SH. AT MIDWAY OF  
MAIN & UPPER DECK

MAIN PLATES TO BE  
FITTED ON BOTH SIDES OF  
SH. AT MIDWAY OF  
MAIN & UPPER DECK

 

# N<sup>o</sup> 190-I. MAIN DECK PLAN. SCALE 1/4" TO ONE FOOT.



NO: \_\_\_\_\_  
THICKNESS ALTERED

 

MTSU-BISHI  
DOCKYARD & ENGINE WORKS  
NAGASAKI  
DRAWN BY: [Signature]  
CHECKED BY: [Signature]  
APPROVED BY: [Signature]  
DRAWING OFFICE No. 10-107  
DATE: 6-15-06



Main deck  
Nagasaki Rept. N<sup>o</sup> 603

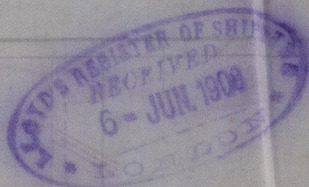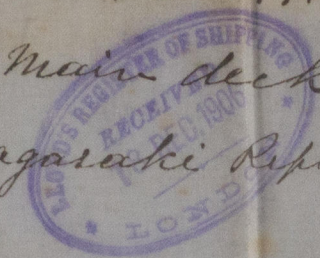

Lloyd's Register  
Foundation

W578-0176