


N^{OS} 190 & 191. SHELTER DECK PLAN. SCALE 1/4" TO ONE FOOT

28.11.06
 18.12.06


WATER WAY ANGLE 32° 28' 30" THROUGHOUT
 STRINGER ANGLE TO BE DOUBLED WITH 6 1/2" X 3/8" ANGLE FOR 3' L. DE.

N.B.: - - - - - ALTERATIONS

 


TENYO MARU
Shelter deck

Shelter deck

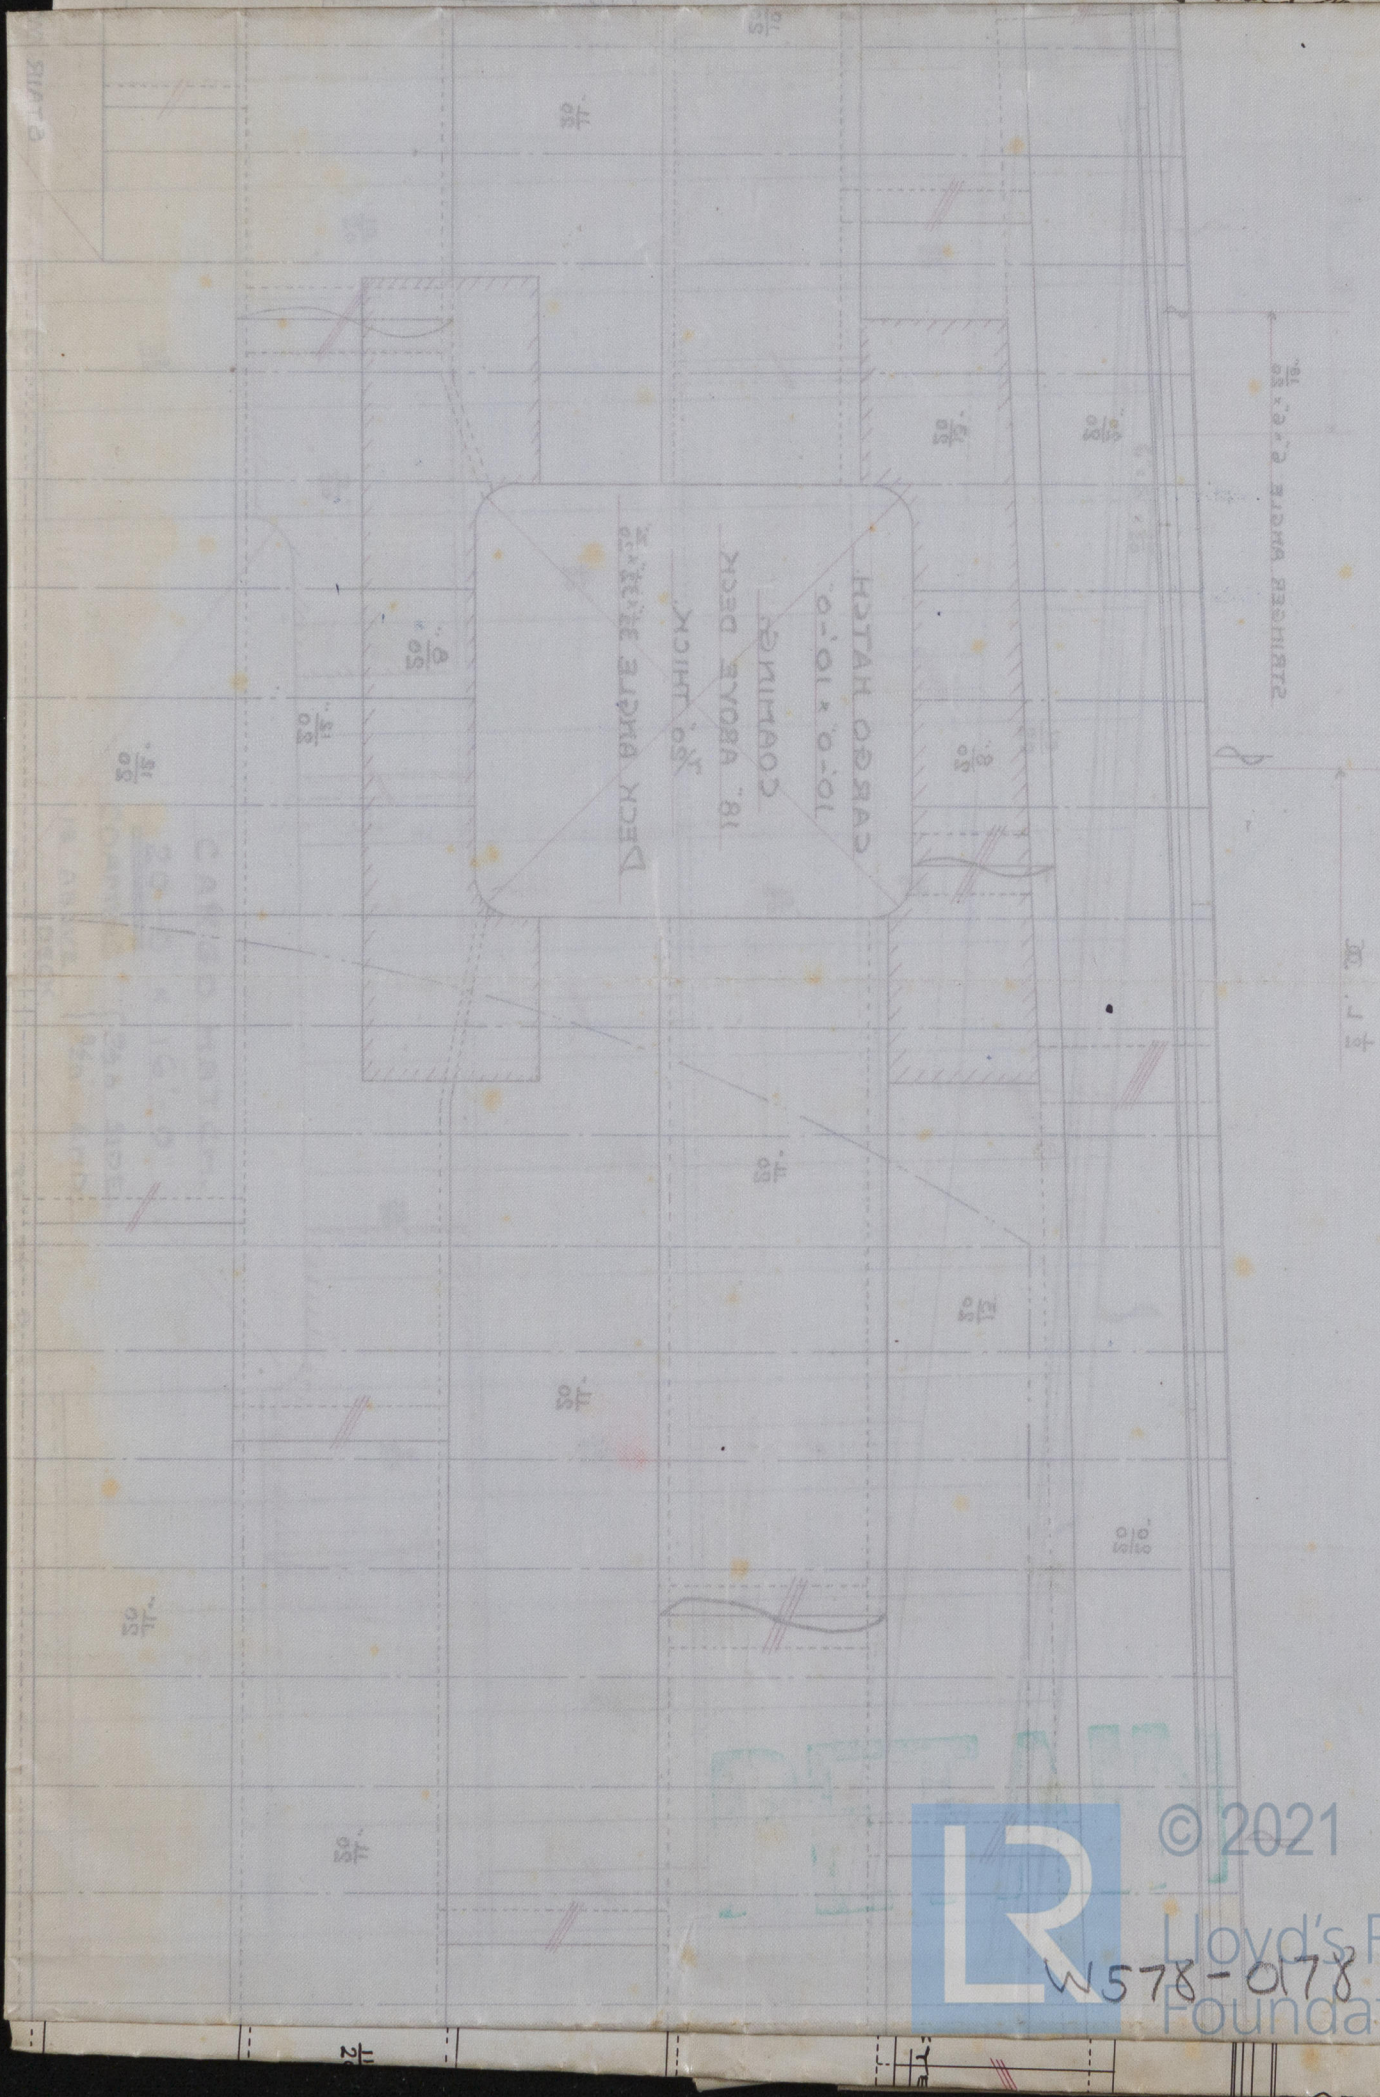

TENYO MARU
Shelter deck
Nagasaki Rept. N°603

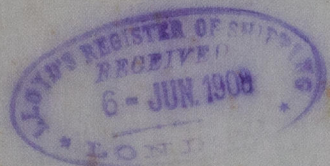




© 2021

Lloyd's Register
Foundation