


S. S. STEAMER No 391.
 IRONWORK PROFILE AND STEEL DECKS
 DIM^s 150' 0" B.P. x 24' 0" x 12' 0" MLD
 SCALE 4" = ONE FOOT

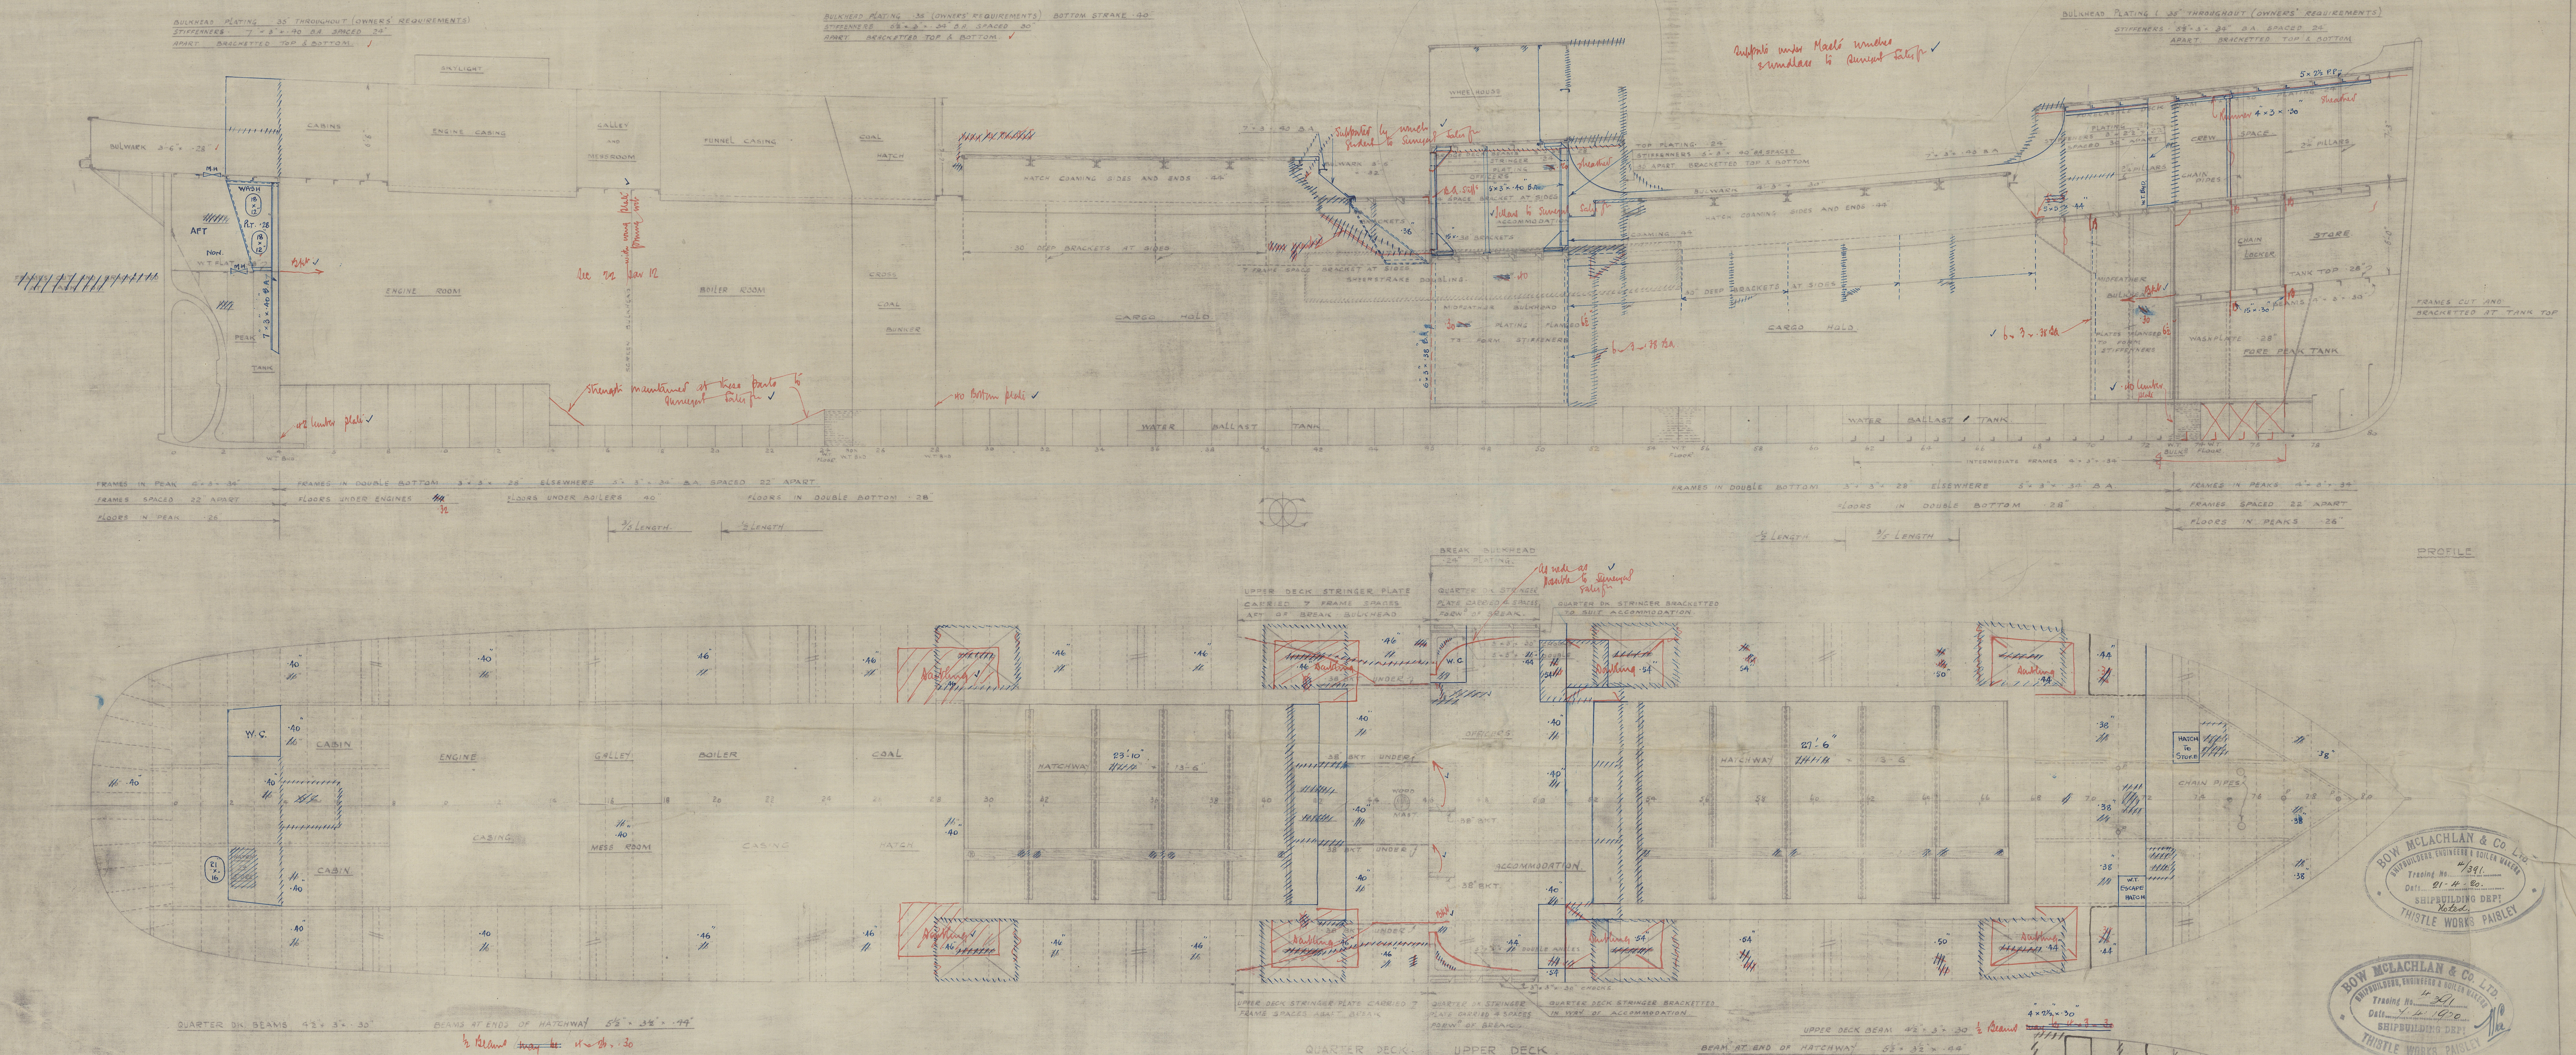

APPROVED
 LLOYD'S REGISTER OF SHIPPING
 [Signature]
 DATE 15. 4. 20

BOW McLACHLAN & CO. LTD.
 SHIPBUILDERS, ENGINEERS & BOILER MAKERS
 TRADING NO. 391
 DATE 21. 4. 20
 SHIPBUILDING DEPT.
 THISTLE WORKS, PAISLEY


BOW McLACHLAN & CO. LTD.
 SHIPBUILDERS, ENGINEERS & BOILER MAKERS
 TRADING NO. 391
 DATE 21. 4. 20
 SHIPBUILDING DEPT.
 THISTLE WORKS, PAISLEY

FO'CLE DECK

BOW. McLACHLAN & Co.
PROFILE & DECK PLAN
No 391.
S/S. "CULMORE"

GLASGOW REPORT No.

41244.

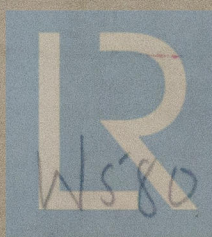

© 2020

Lloyd's Register
Foundation