


SCALE  $\frac{1}{2}$  = ONE FOOT

76. 6. 04  
9. 7. 04  
30. 9. 04

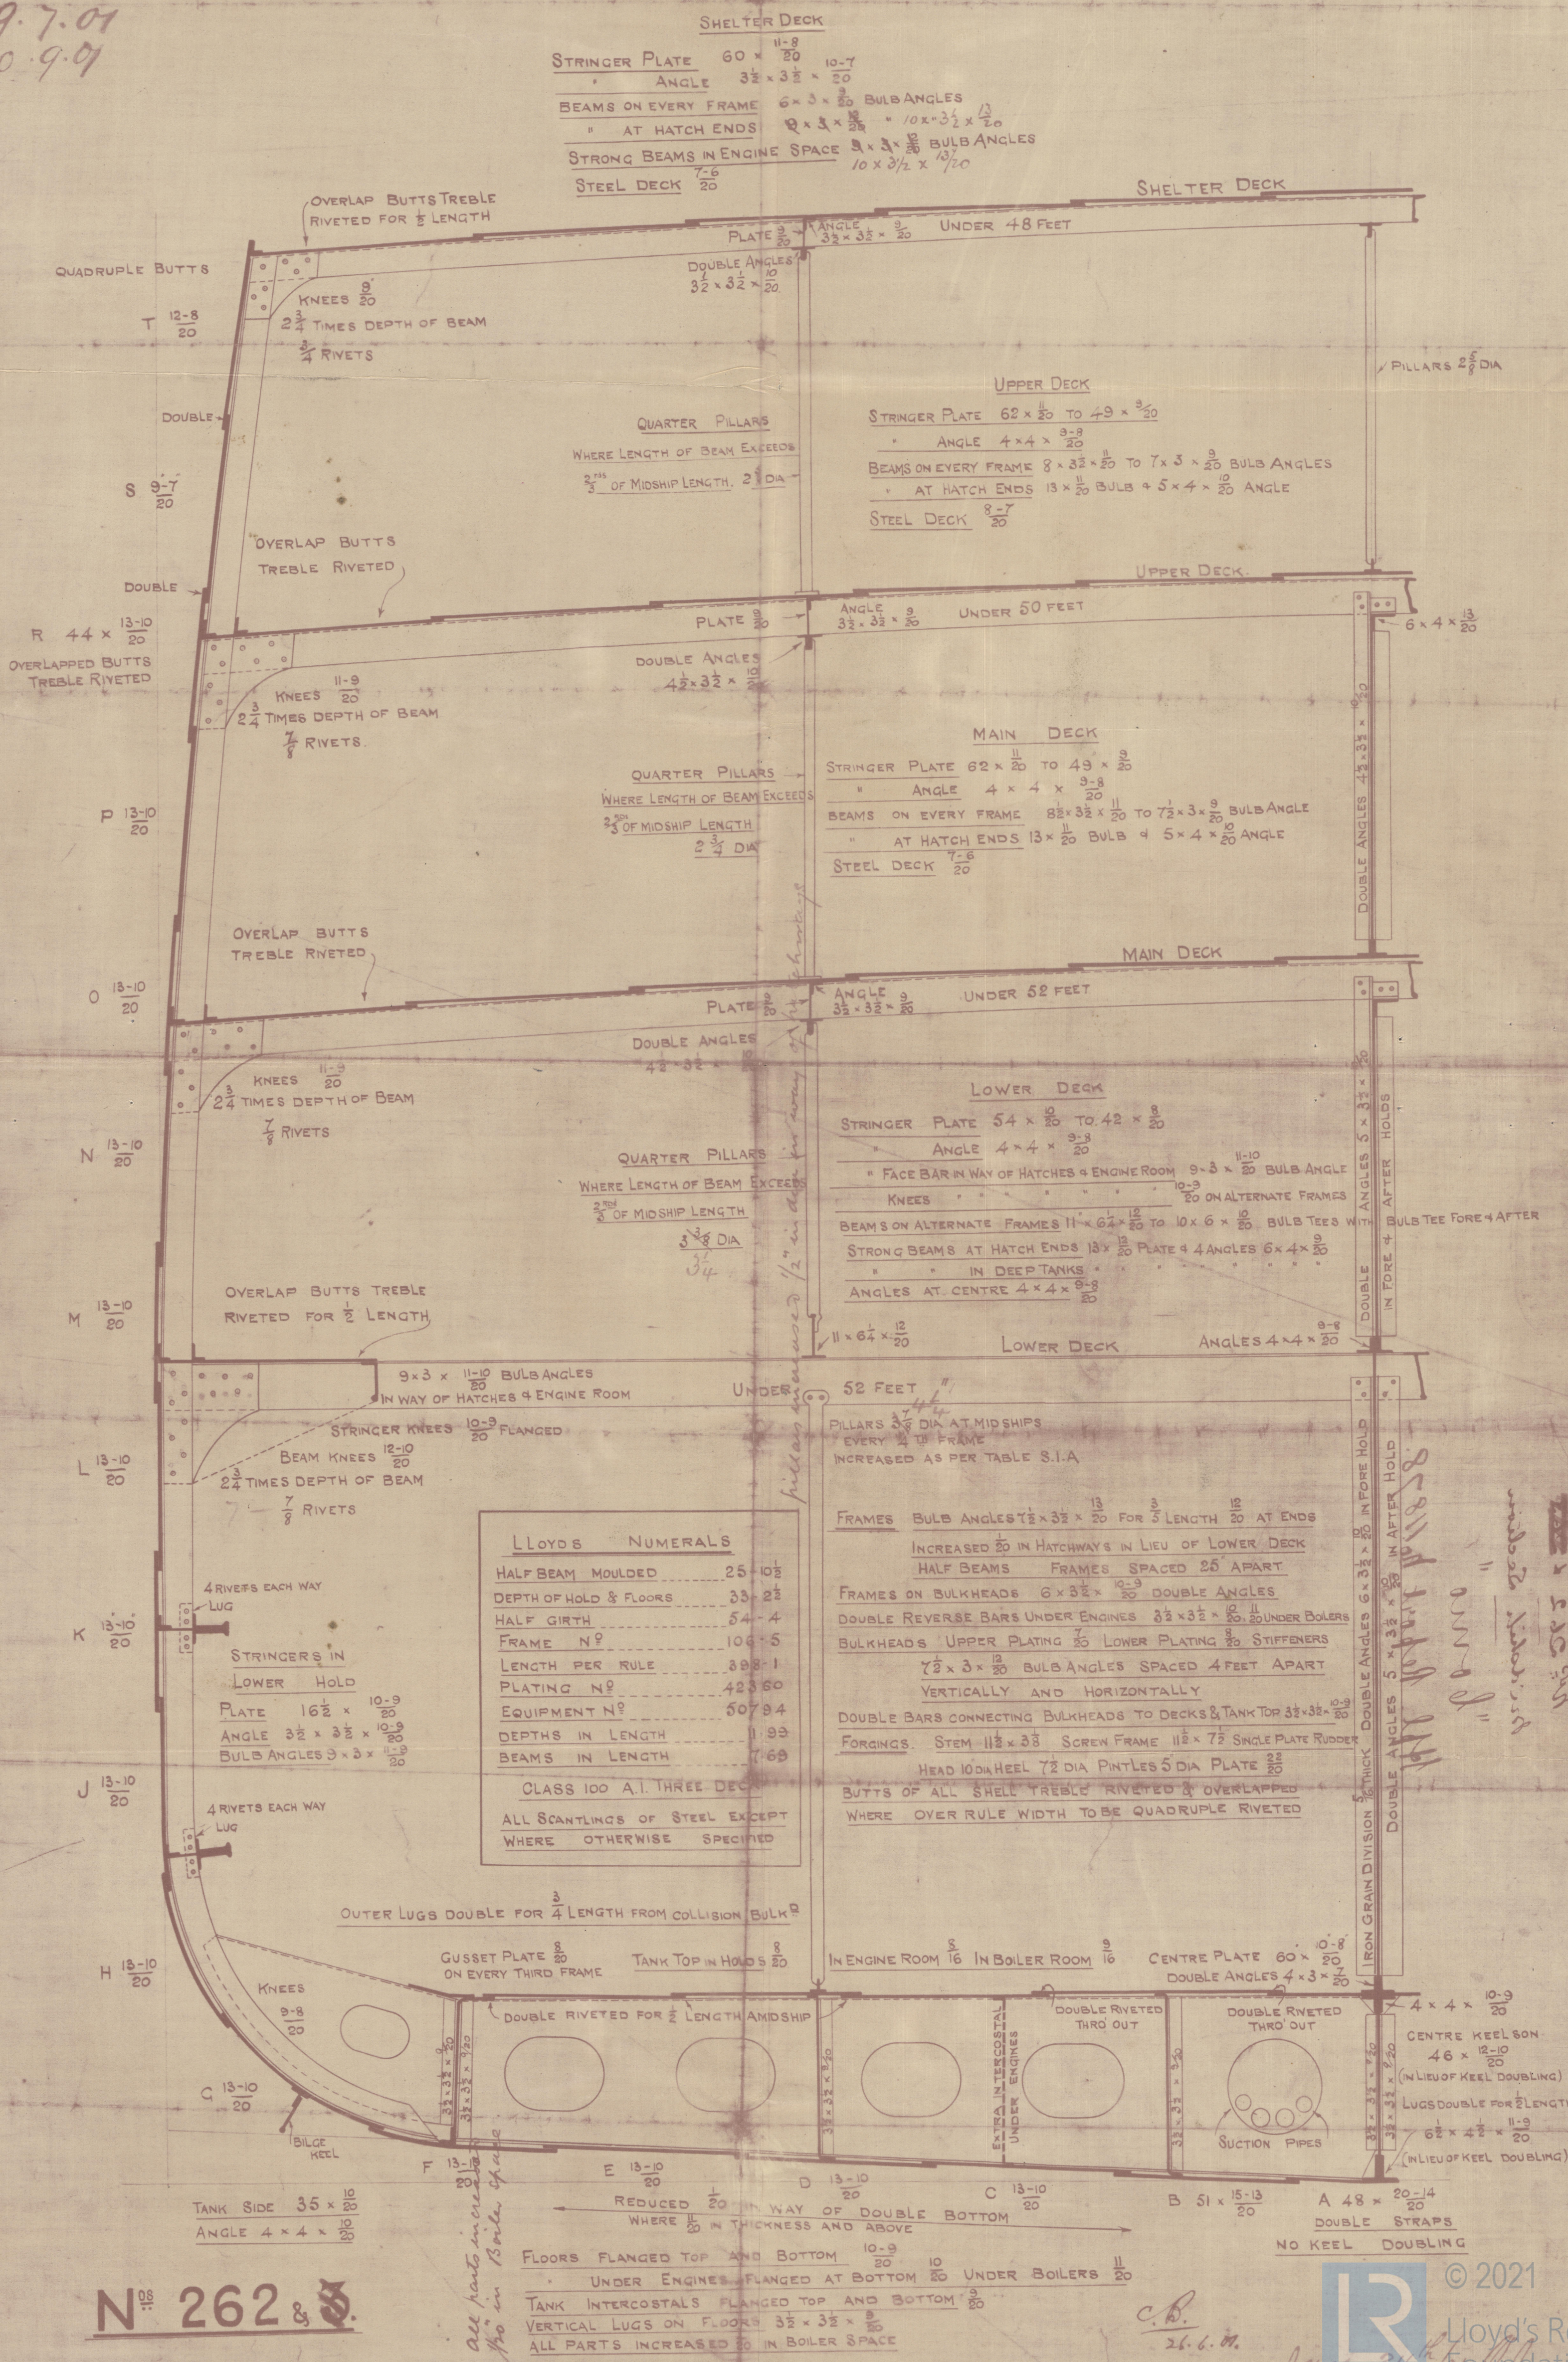

N<sup>os</sup> 262 & 263

W582-0124



STEEL Sec. "BENMACDHUI"

EX "COMO"

MIDSHIP SECTION.

RETAIN



© 2021

Lloyd's Register  
Foundation

W 582-0124