

RICHARDSON, WESTGARTH & CO. LIMITED				
DRAWING OFFICE, HARTLEPOOL.				
NO. OF DRAWING	-	-	-	B.1112.
NO. OF TRACING	-	-	-	13784.
WHERE SENT	-	-	-	Messrs. LLOYD SURVEYORS
EXAMINED BY	-	-	-	<i>g. l. n.</i>
DATE	-	-	-	18-9-01.



Main Boilers

Gurness Nisby & Co

N^o 262 Vessel

Richardsons N^o 1134
(Hartlepool) 180 lbs.

" bonno "
Hpl. Report No. 11878

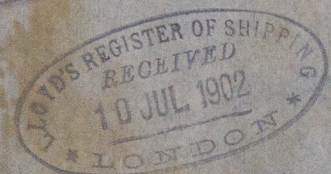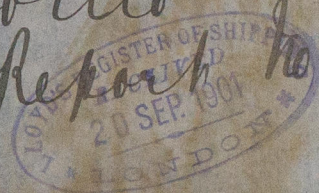

N^o 2852

Lloyd's Test
360 lbs.

N.L.S. 11.4.02

© 2021

Lloyd's Register
Foundation

W582-0125