

410

Belfast

Harland & Wolff's





~~No 336 & No 337~~

Midship Section
Turn S.S. Ryndam

Del 5374

also S.S. Noordam

Repat No 5405

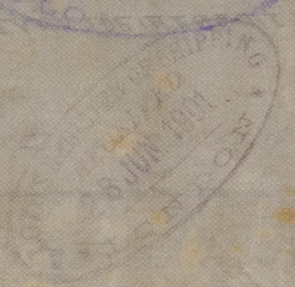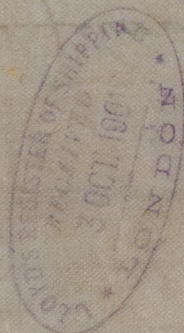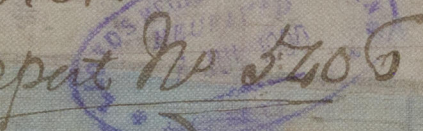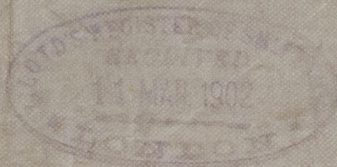

© 2021

Lloyd's Register

WS8 Foundation