

S.S. N^o 256.

PROFILE & DECK PLAN.

LENGTH B.P. 331'-0"; BREADTH EXT: 47'-9"; DEPTH ML^o 24'-3 1/2".

— SCALE 1/8" = 1 FT. —


After Peak W.T. H. 12.2.
PLATING .36 TO .26 FLOOR .38, FLOOR .42 ON 7 FRAME.
STIFFS 7 1/2" x 36 B.A. & 6 1/2" x 42 & 35 B.A.
8 3/4" x 50 B.A. SPACED 24" APART.
BKT'S 18" x 36, 3" x 34 RIVS.
FRAME ANGLE 5" x 5" x 46 SINGLE.

W.T. BULKHEAD N^o 65 FR:
PLATING .46 TO .26
STIFFS 9 1/2" x 52 B.A. SPACED 30" APART.
BKT'S 28 1/2" x 44 FLANGED 7" x 3/4" RIVS.
FRAME ANGLE 3 1/2" x 3 1/2" x 46 SINGLE.

W.T. B^o N^o 8 FR: SAME SCANTLINGS AS 65 FR.
EXCEPT STIFFS 7 1/2" x 36 B.A. & 5 1/2" x 64 B.A.
& FRAME ANGLE .44.

W.T. B^o N^o 128 FR:
PLATING .46 TO .26
STIFFS 11 3/8" x 58 B.A. SPACED 30" APART.
BKT'S 33" x 44 FLANGED 8" x 1/8" RIVS.
FRAME ANGLE 3 1/2" x 3 1/2" x 44 SINGLE.
DOUBLE FR: 5" x 5" x 46 BELOW 24' BELOW UP DECK.

COLLISION B^o N^o 153 FR:
PLATING .36 TO .26 FLOOR .48.
STIFFS 7 1/2" x 44 B.A. SPACED 24" APART.
BKT'S 21" x 44 & 5" x 3/4" RIVS.
FRAME ANGLE 3 1/2" x 3 1/2" x 44 SINGLE.
DOUBLE FR: 24" x 24" BELOW UPPER DECK.

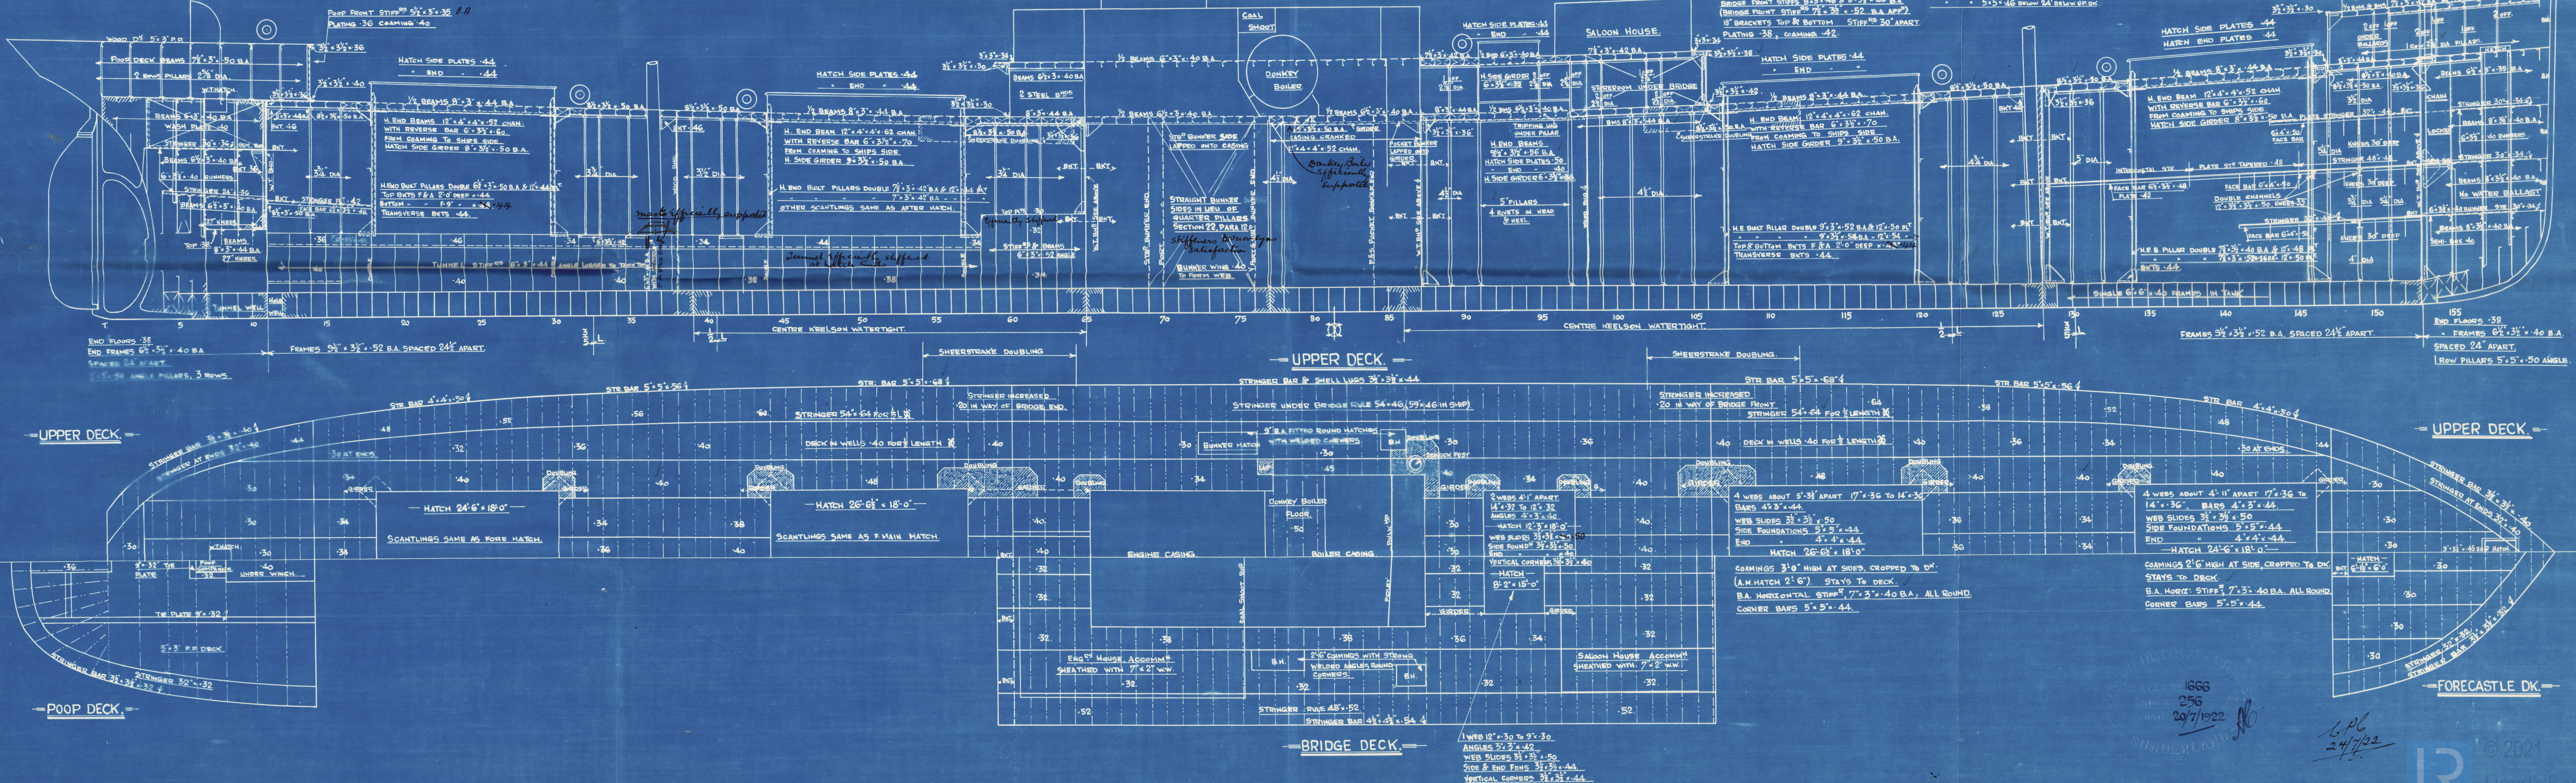

1666
256
29/7/1922

24/7/22

SUNDERLAND

J. BLUMER + C^o LTD

Nº 256

PROFILE + DECKS

(AS BUILT)

S.S. IXIA

SUNDERLAND, Nº 28385

RETAIN

RETAIN

W583-0087



© 2021

Lloyd's Register
Foundation