


S.S. WARWICKSHIRE.  
HEIGHT OF MASTS AND FUNNEL  
FOR  
SHIP CANAL AS CARGO VESSEL

SCALE:  $\frac{1}{2}$ " = 1 FOOT 14-10-27  
EPP

NOTE: BANDS ON MASTS TO RE-ARRANGE  
FOR DERRICKS  
DERRICKS TO RE-RIG.



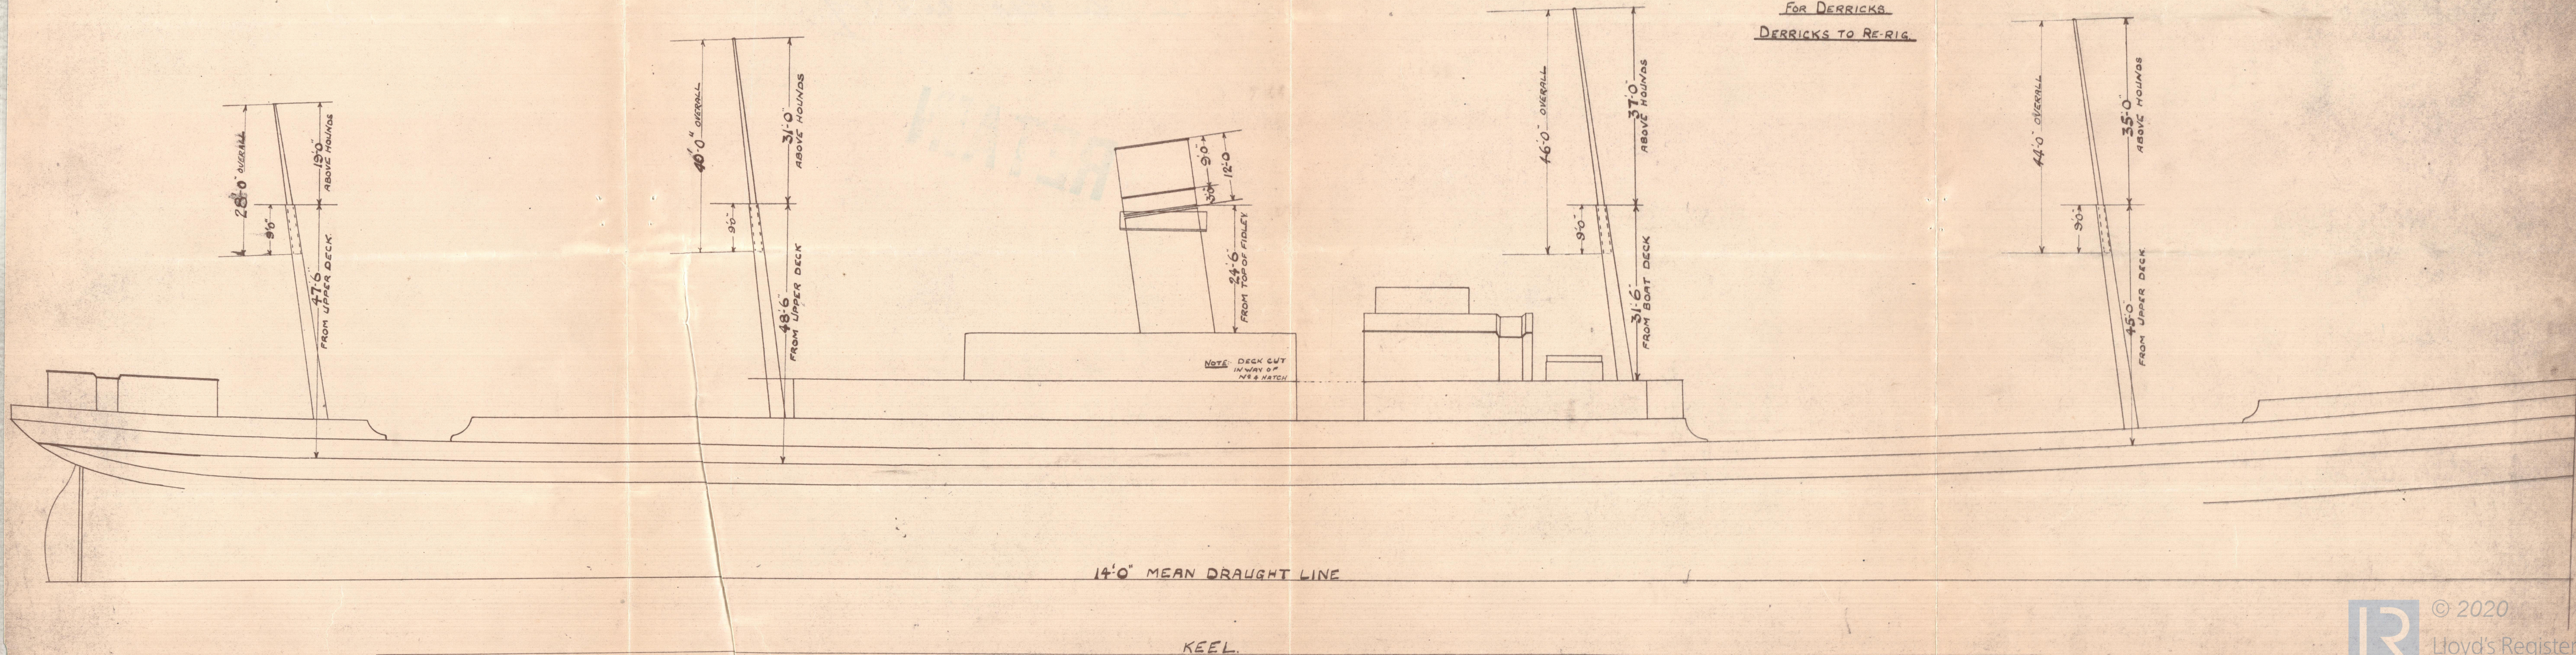

S. S. Harwood  
now altered for a passage  
to the Congo basin.

See See Rpt No 93129

RETAIN

W584-0144



© 2020

Lloyd's Register  
Foundation