



3/8/11

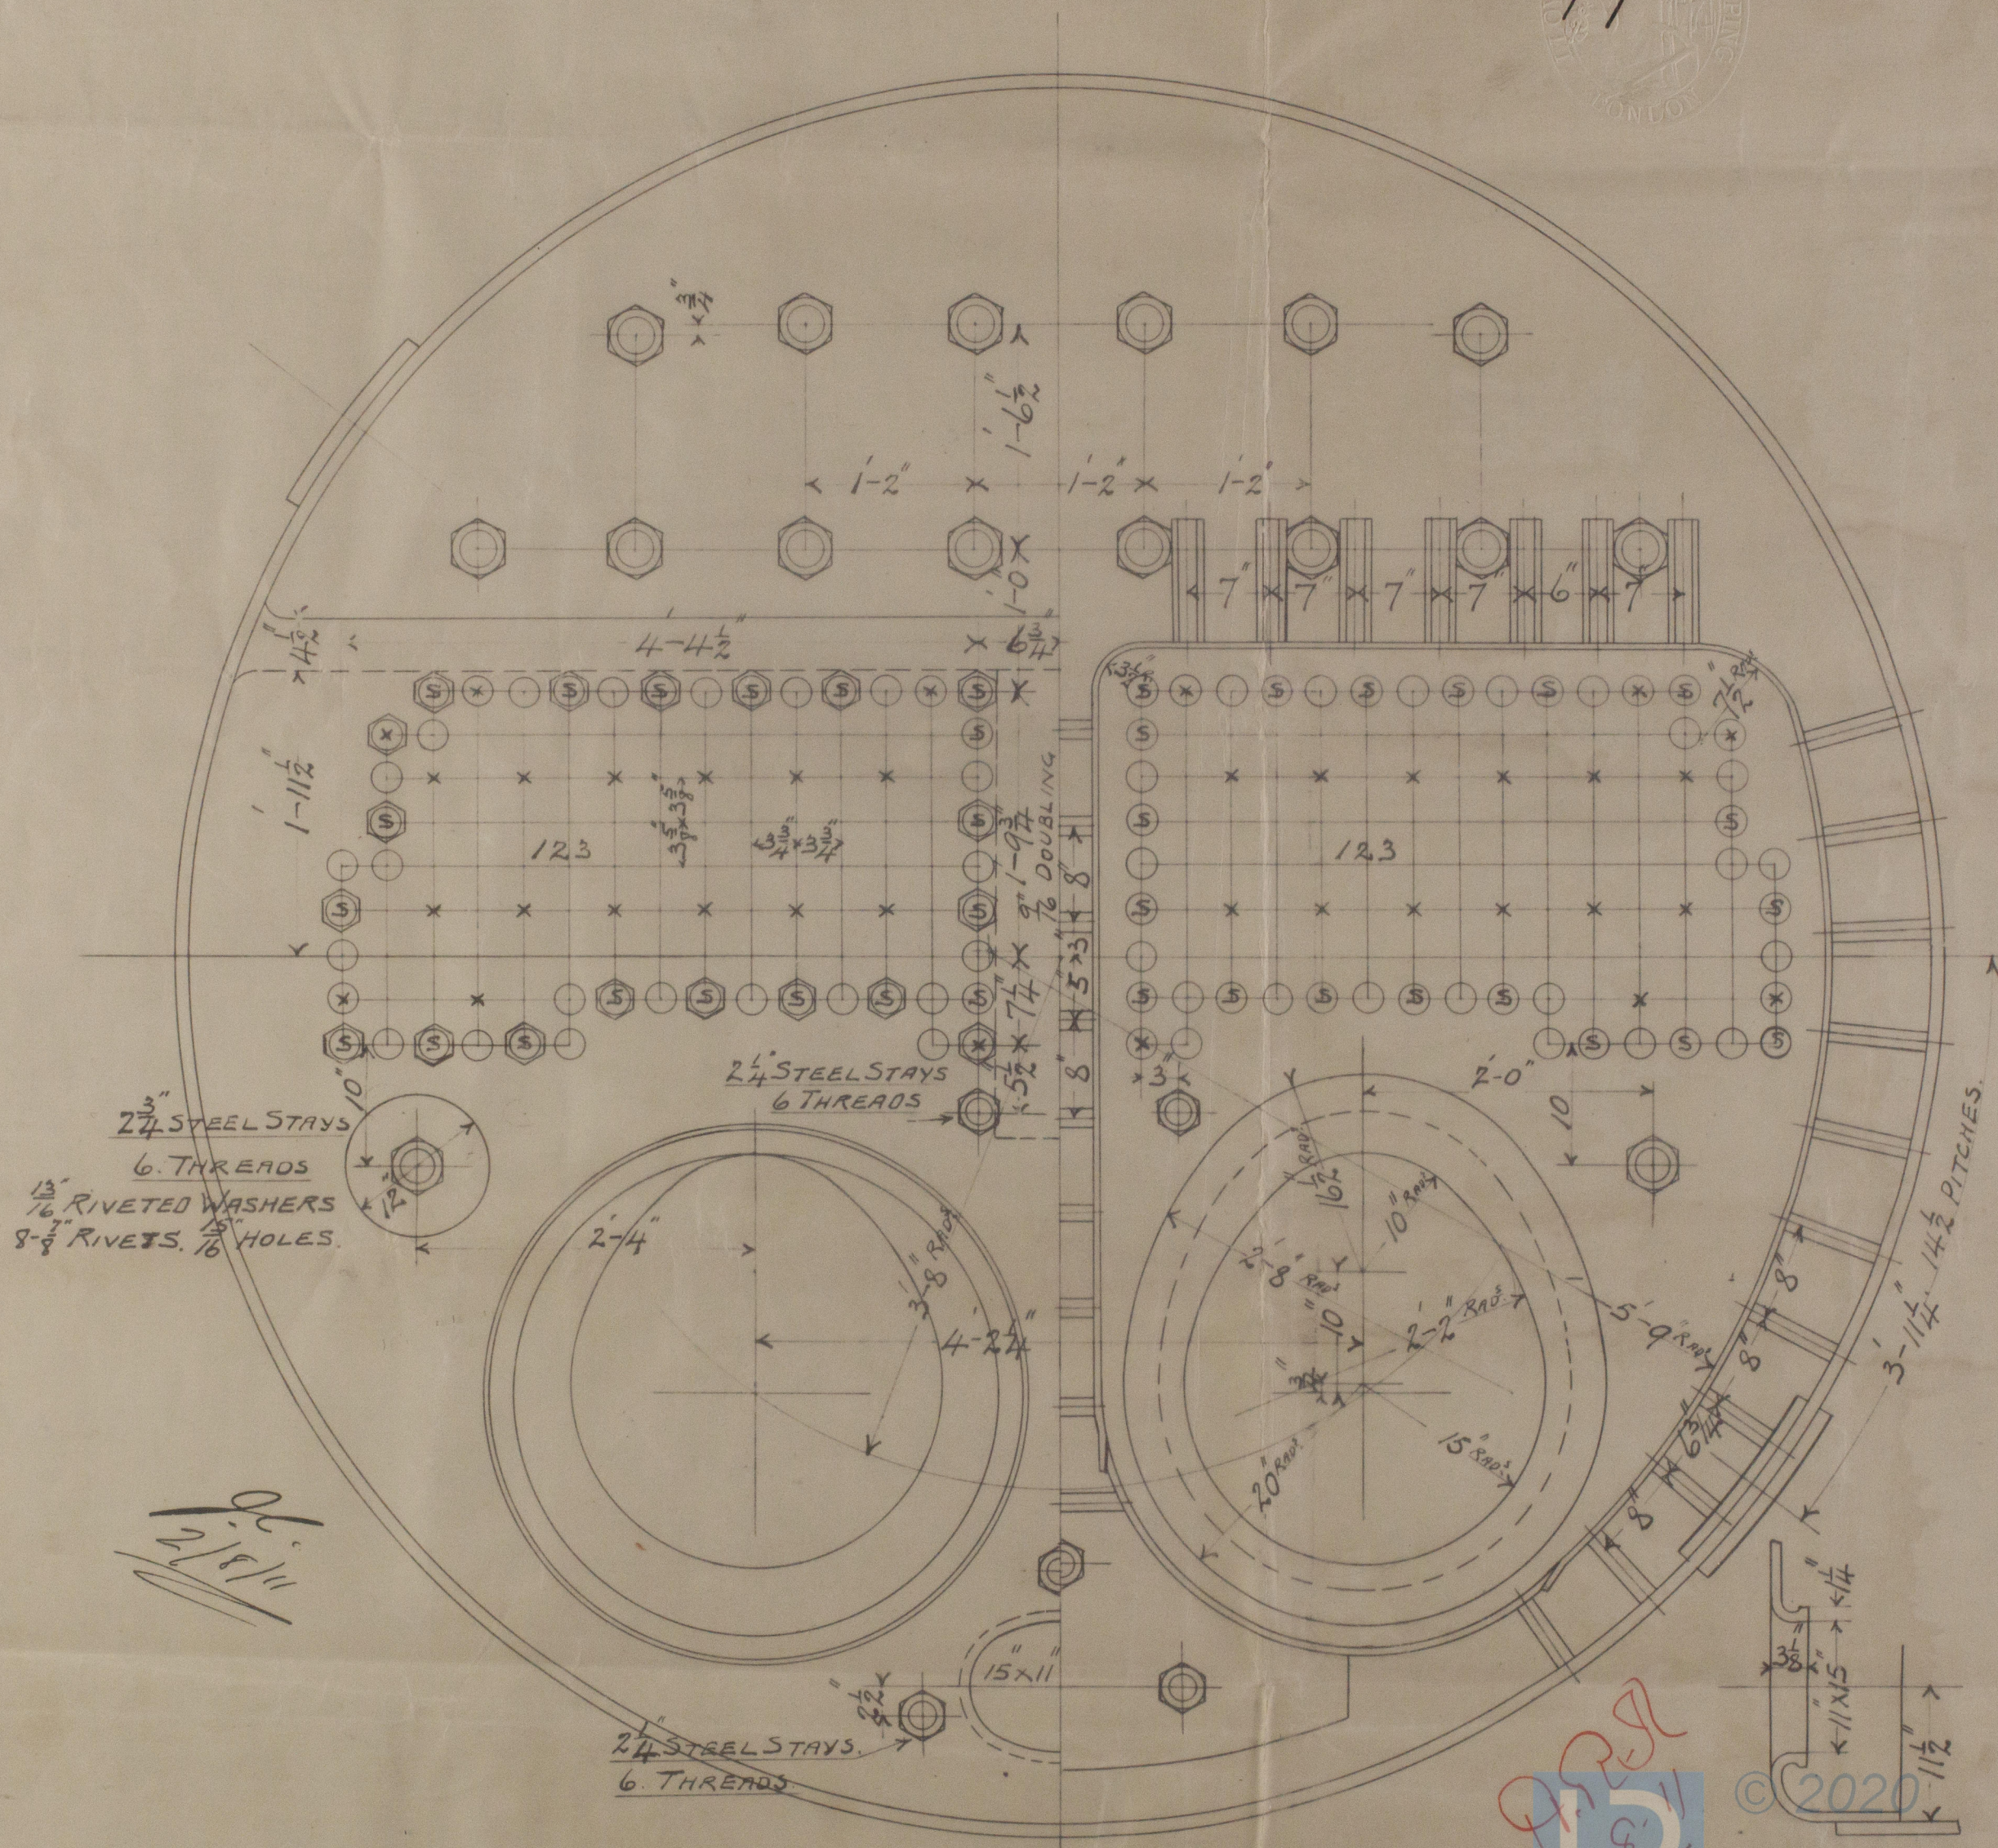

2/8/11

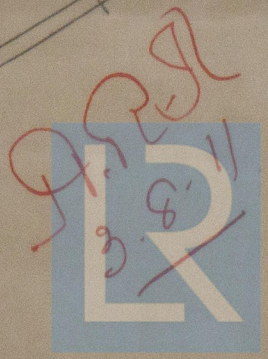

© 2020
Lloyd's Register
Foundation
W585-0038