


SPAR & MAIN DECK PLATING PLANS.

NO 317 S.S. 3/8

SCALE 1/8" = ONE FOOT


Bridge deck plan to be submitted

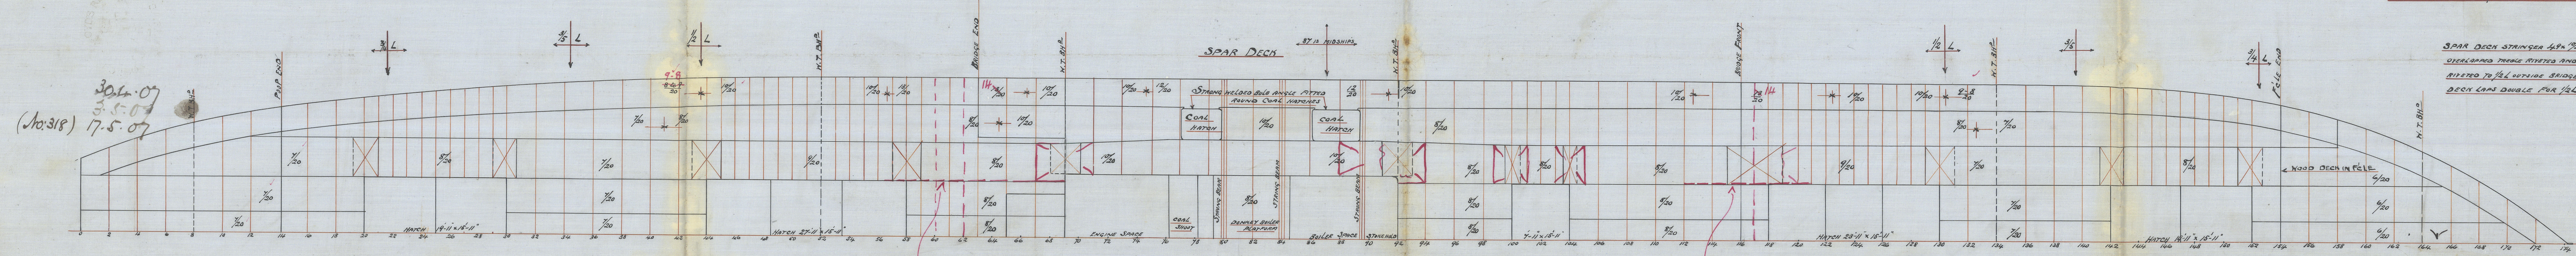

SPAR DECK STRINGER 4 1/2" x 1/2" G 4.3 x 1/2"
OVERLAP TREBLE RIVETED AND QUADRUPLE
RIVETED TO 1/2" L OUTSIDE BRIDGE.
DECK LAPS DOUBLE FOR 1/2" L SINGLE AT ENDS

with steel girder
not fitted

in braced girder
not fitted

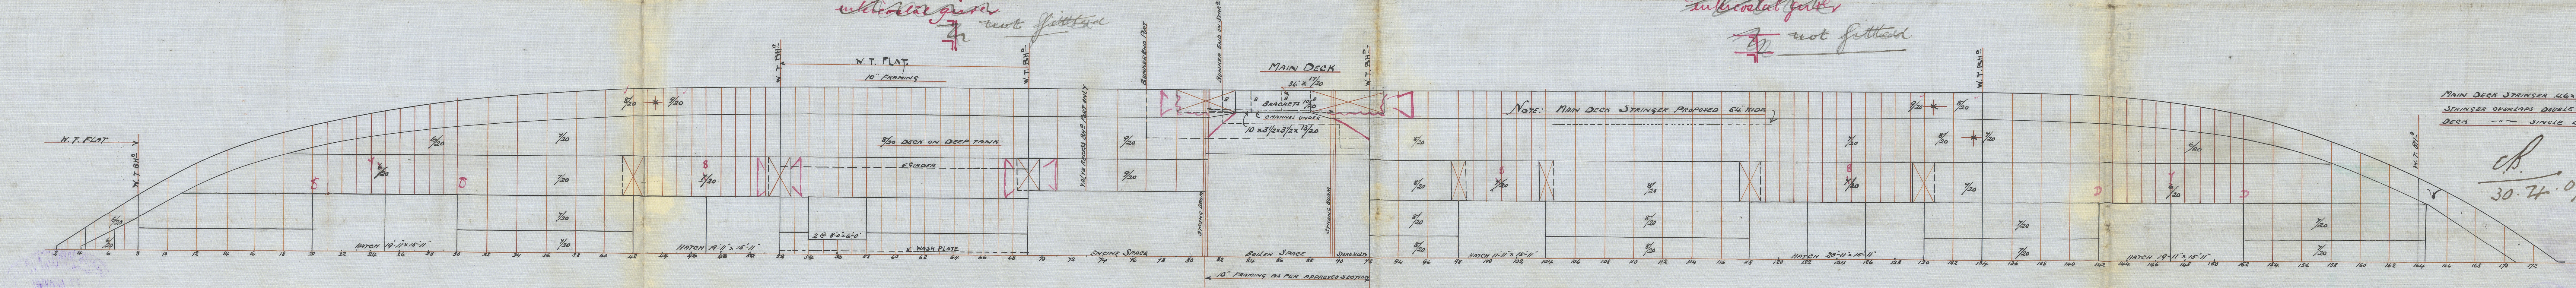

MAIN DECK STRINGER 4 1/2" x 1/2" G 4.3 x 1/2" PROPOSED 5 1/2" WIDE
STRINGER OVERLAPS DOUBLE
DECK " " SINGLE EXCEPT AT OPENINGS

30.4.07

Handwritten notes and signatures on the right side of the page, including '30.4.07' and various initials.

2310-2822

C. Cunnell & Co

Dech & Plans

Vintail No 317 8/5


Killin No 318

No 318. Mr. "Killin"

Glasgow 1st No 265 7/4

To
K
L

DECH
PLANES
VINTAIL

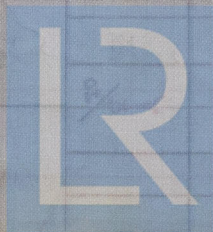

© 2020

Lloyd's Register
Foundation

W585 - 0155