


18.4.07.  
30.4.07.  
3.5.07.  
17.5.07 (18/8)  
27.6.07

Freeboard Particulars		1/2
Length on load line	348'-4"	
Depth mid. to spar deck	28'-2 1/2"	
Under deck tonnage	3360 tons	
Length of erections, poop	28'-11"	114'-11"
Bridge	106'-0"	
File (incl. M.L.)	40'-0"	
Sheer Forward	102'	
" aft	52'	
" 1/8 length from Stem	55'	
" " " Stern	28'	29
Main Sheer 1/8 length	11 3/4'	42

# Profile No 317 S. S. 3/8. Scale 1/8" = One foot.

To Class 100 A.1. Lloyd's. Spar D<sup>3</sup> Rule. Strengthened.

Note: helms are in connection with  
dispensing with trees bar. 52

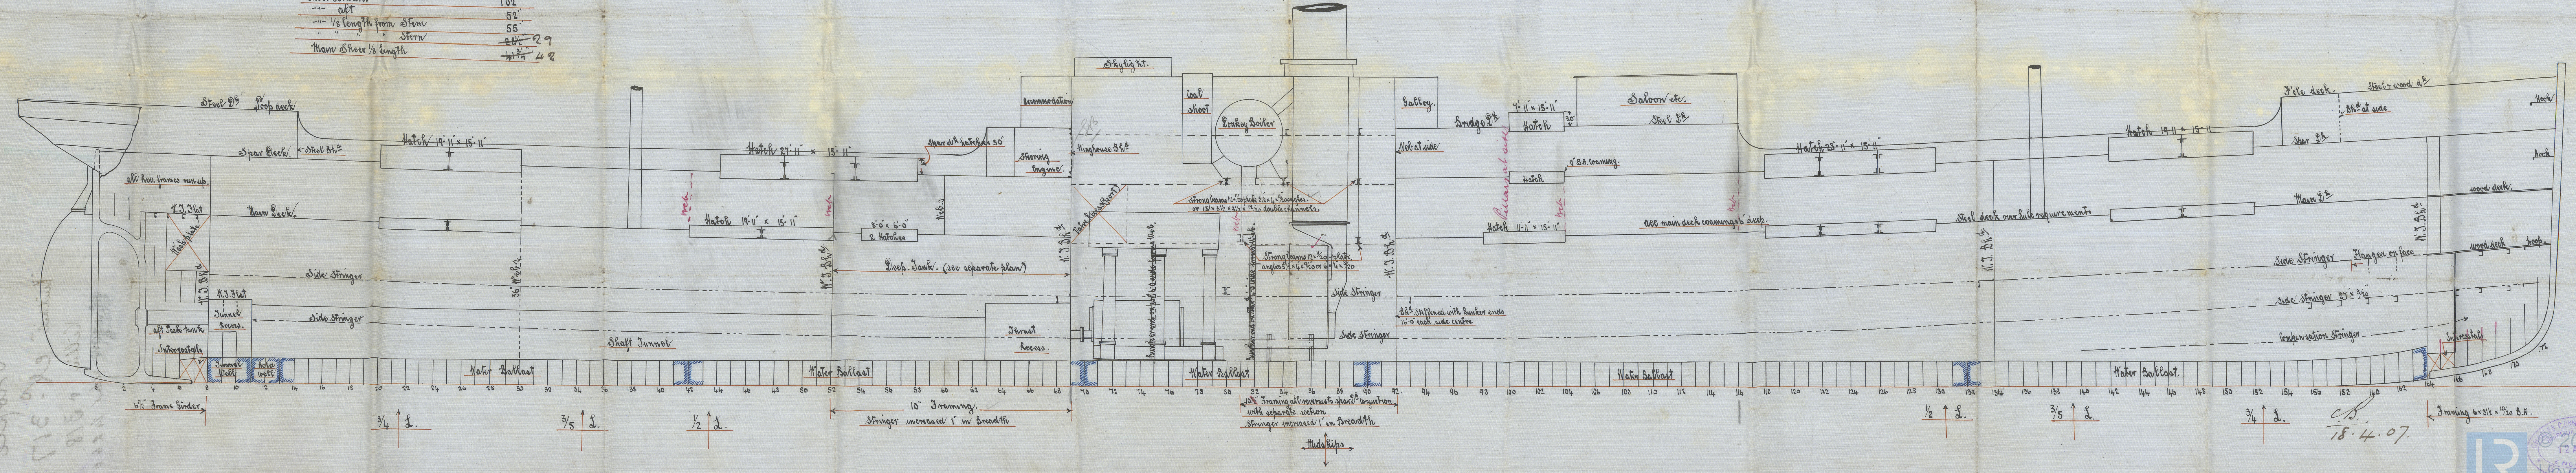



9510-585M

Journal of  
Profile  
Kuitale  
Kellie + 318  
Kuitale  
Kuitale