


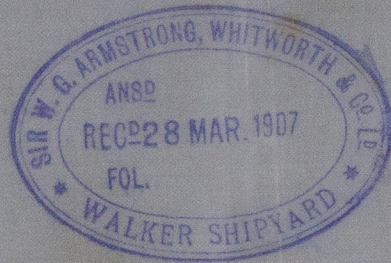

Messrs. Sir W. G. Armstrong Whitworth & Co.,

S.S. No. 801 ~~806~~
Profile. ~~Cancelled~~
30/11/07.



"OBERON"

Length Overall 308-0
Length between Perpendiculars 305-0
Breadth 20-6
Depth 31-10
Draft 22-23

54.026

Scale 1/1000

S/S Jolyot Mare

No. 55.487.

W587-0016



© 2021

Lloyd's Register
Foundation