

BUILDING NO 88 & 89.
MIDSHIP SECTION
 — SCALE 1/2" = 1' —

NUMERALS


18.10.10
 $B+D = 15.17 + 34.0 = 49.17$
 $L(B+D) = 215 \times 49.17 = 10572$
 EQUIPM. NO = $10572 + 1210 + 390 + 240 + 120 = 12532$
 $L/D = 9.5$ TO AWNINGDECK. $1/8 = 6.32$
 $d = 12-7/8$

LENGTH AS PER RULE 215'-0"
 BREADTH MOULDED 34'-0"
 DEPTH MOULDED TO MAINDECK 15'-2"
 ——— AWNINGDECK 22'-8"
 HEIGHT OF BRIDGE 7'-6"

CLASS: BRITISH LLOYDS 100A.1. SPECIAL SURVEY
 TYPE: AWNINGDECK WITH BRIDGE (FREEBOARD).


EQUIPMENT

2 STOCKLESS ANCHORS a 25 1/2 CWT.
 1 ——— ANCHOR a 22 ———
 1 STREAM ——— a 6 1/2 ——— EXCL. STOCK
 1 KEDGE ——— a 3 1/2 ———
 210 FATH. 1 3/8" STUD CHAIN CABLE.
 75 ——— 3" EXTRA FLEXIBLE STEELWIRE *Owners consent to be obtained for steel wire*
 90 ——— 2 3/4" ———
 90 ——— 6" MANILLA.
 90 ——— 5" ———

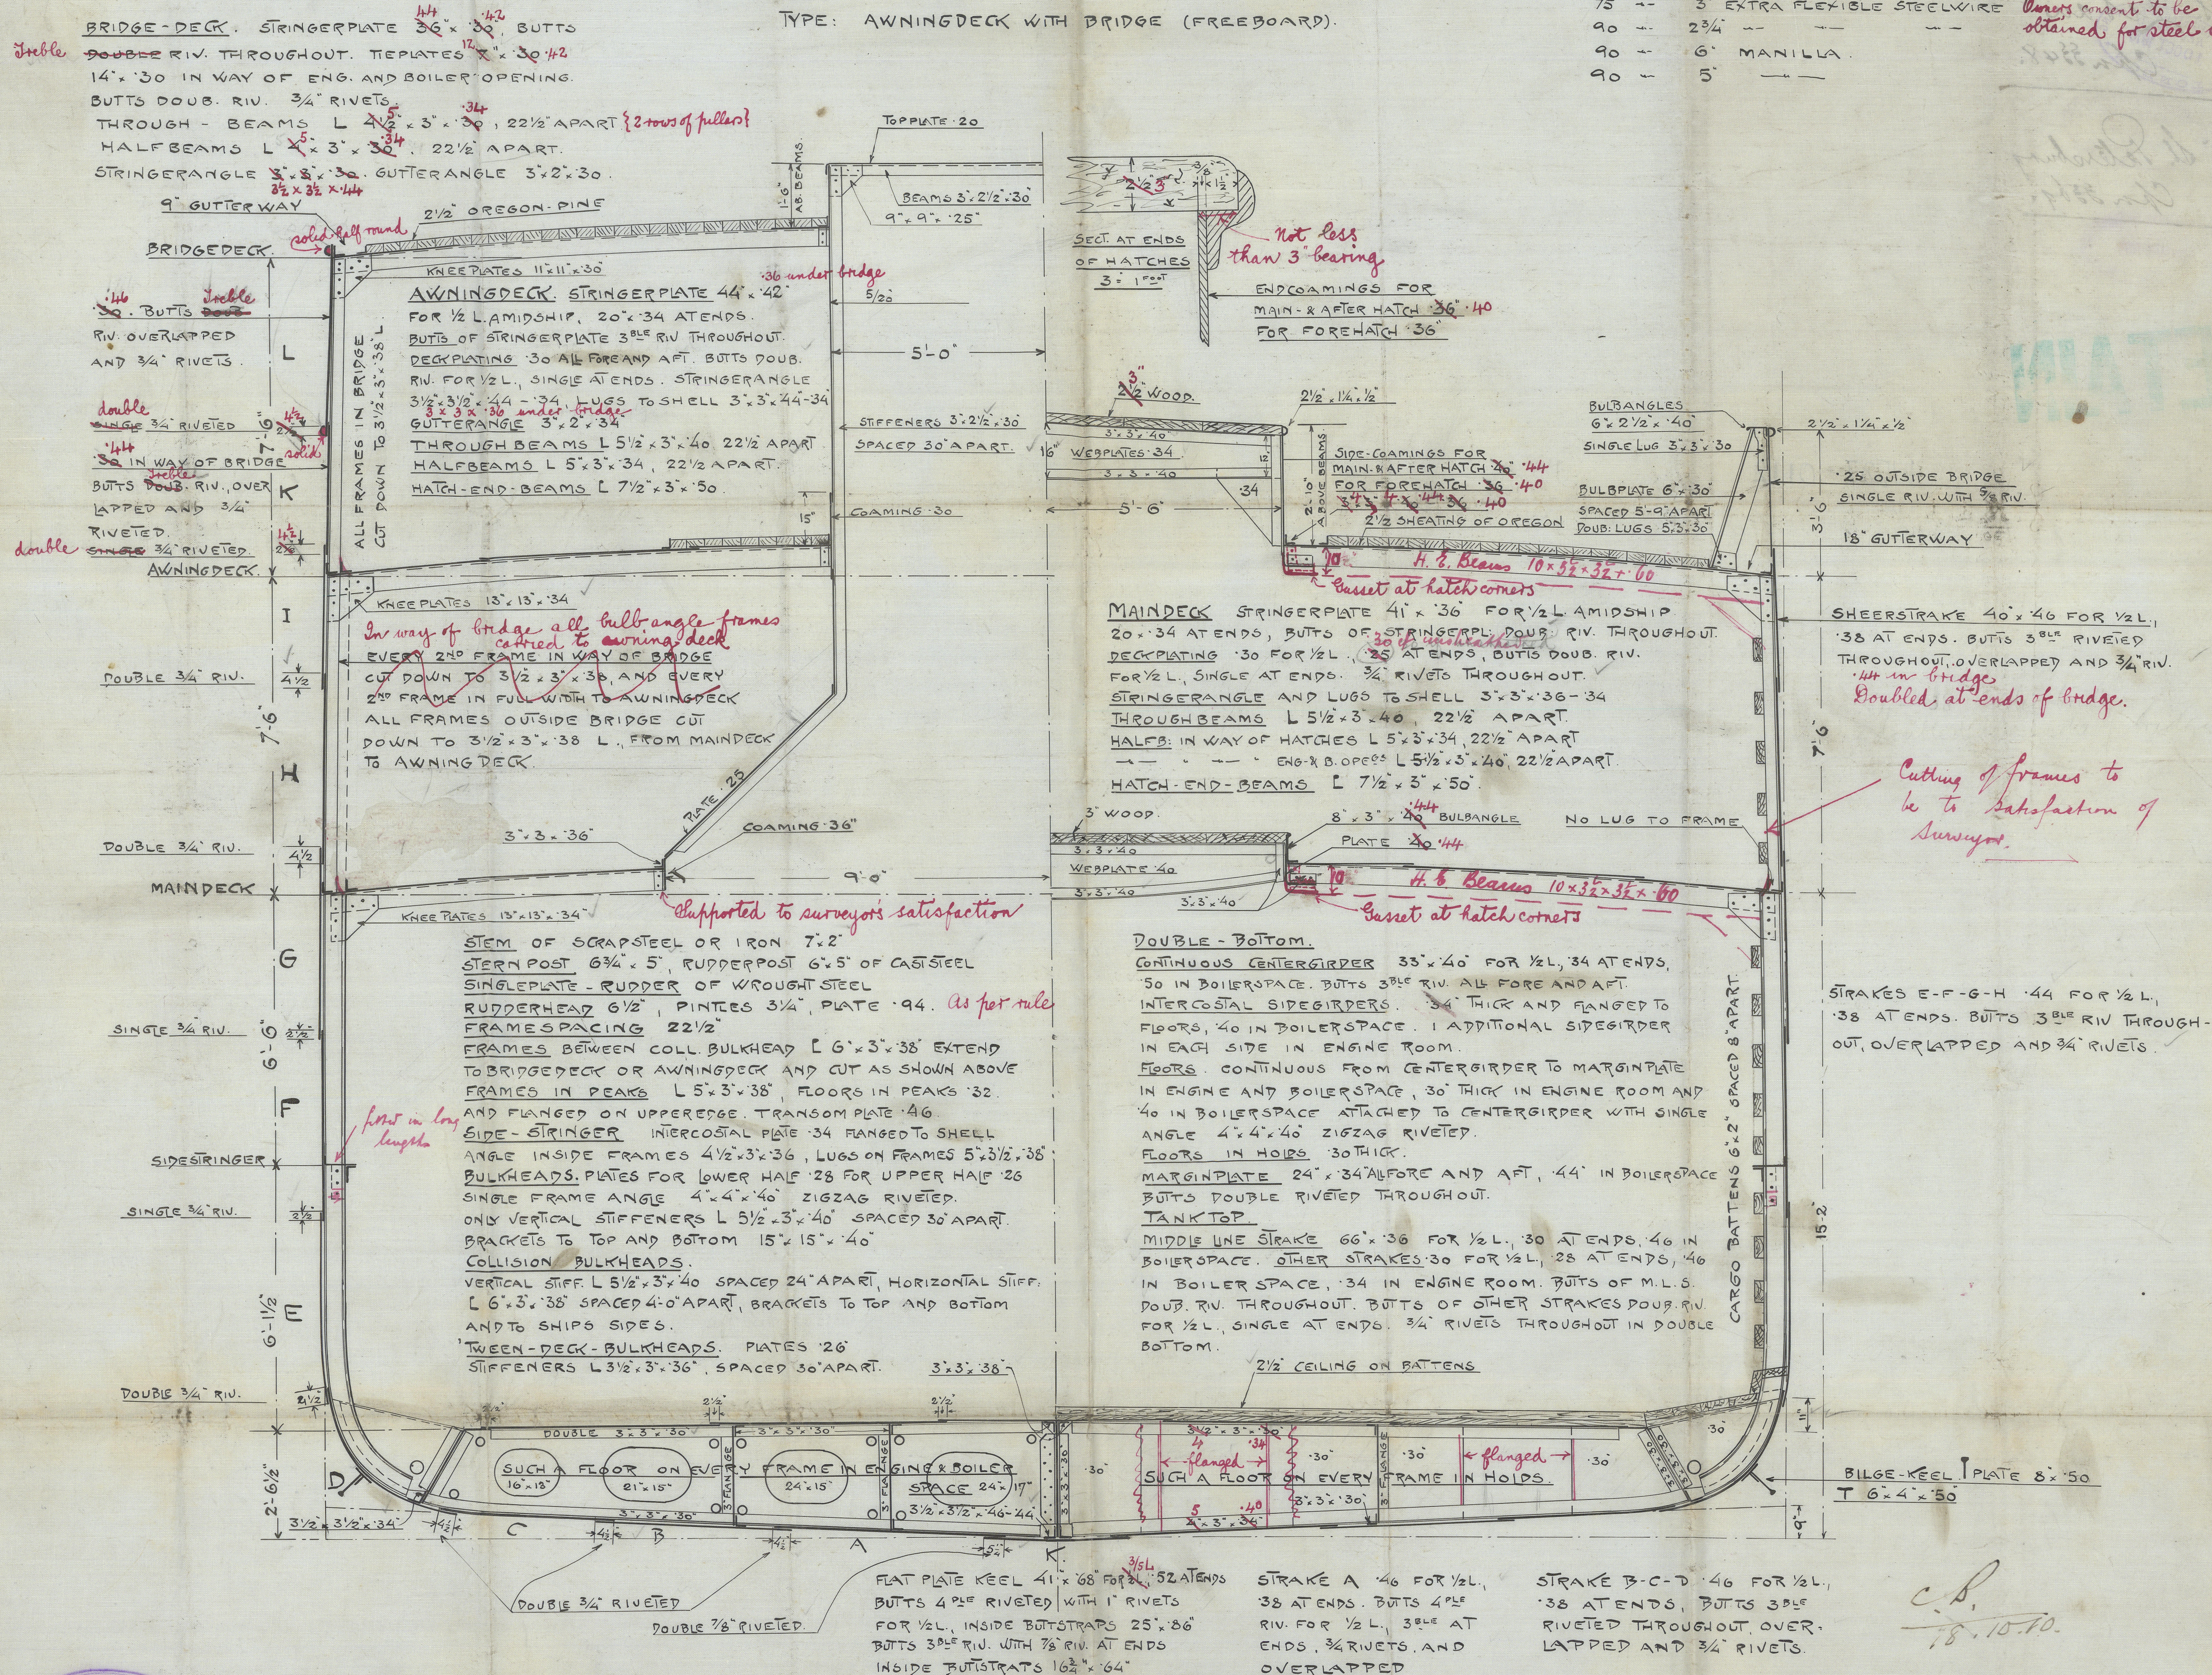


EQUIVALENT SECTIONS

BULB ANGLES	7 1/2" x 3" x 50"	180.80 x 12 1/2"
"	6" x 3" x 38"	150.70 x 10"
ANGLES	5 1/2" x 3" x 40"	130.75 x 11"
"	5" x 3" x 38"	120.75 x 10"
"	5" x 3" x 34"	120.75 x 9"
"	4 1/2" x 3" x 30"	110.75 x 8"
"	4" x 3" x 30"	110.75 x 7"

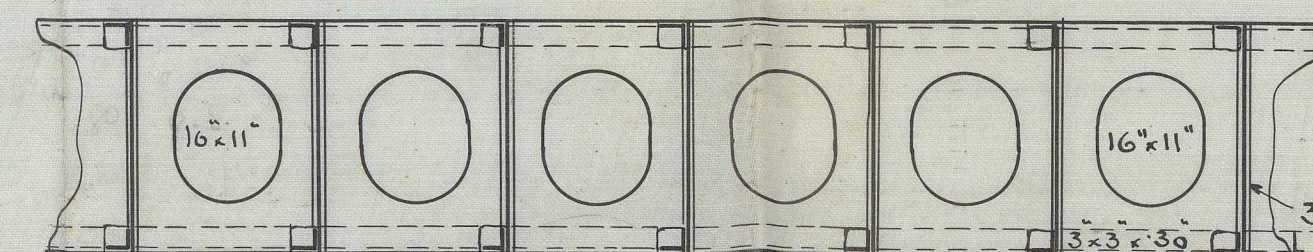

SKETCH SHOWING THE CONNECTION OF SIDE INTERCOSTALS TO FLOORS AND BOTTOMS. SCALE 1/2" = 1'.

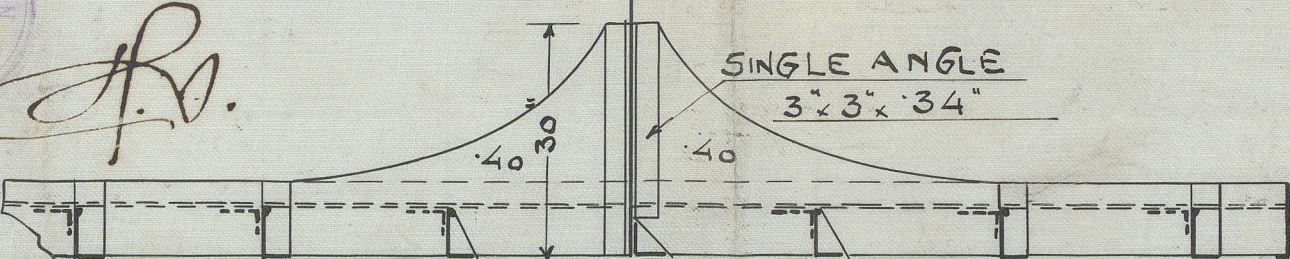

SKETCH OF SIDESTRINGER AND THE CONNECTION TO BULKHEADS (NO BULKHEAD LINERS TO BE FITTED).



8/10-10


Midship-Section
for
Kjöbenhavn Flyddesk &
Skibsværft.
Yard No. 88-89
Eng. No. 82-83.



St. Liban
Cpn 3348.

St. St. Petersburg
Cpn 3369.

St. Liban
Cpn 3348.

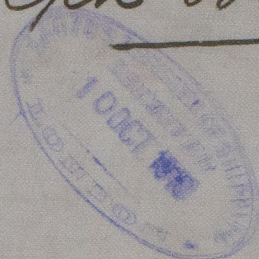

RETAIN



© 2021

Lloyd's Register
Foundation

10 OCT 1810