


— BUILDING NO 88 & 89. —
— LONGITUDINAL SECTION —

215'-0" - 34'-0" - 15'-2" MOULDED

- SCALE $\frac{1}{8}$ " = 1' 00"

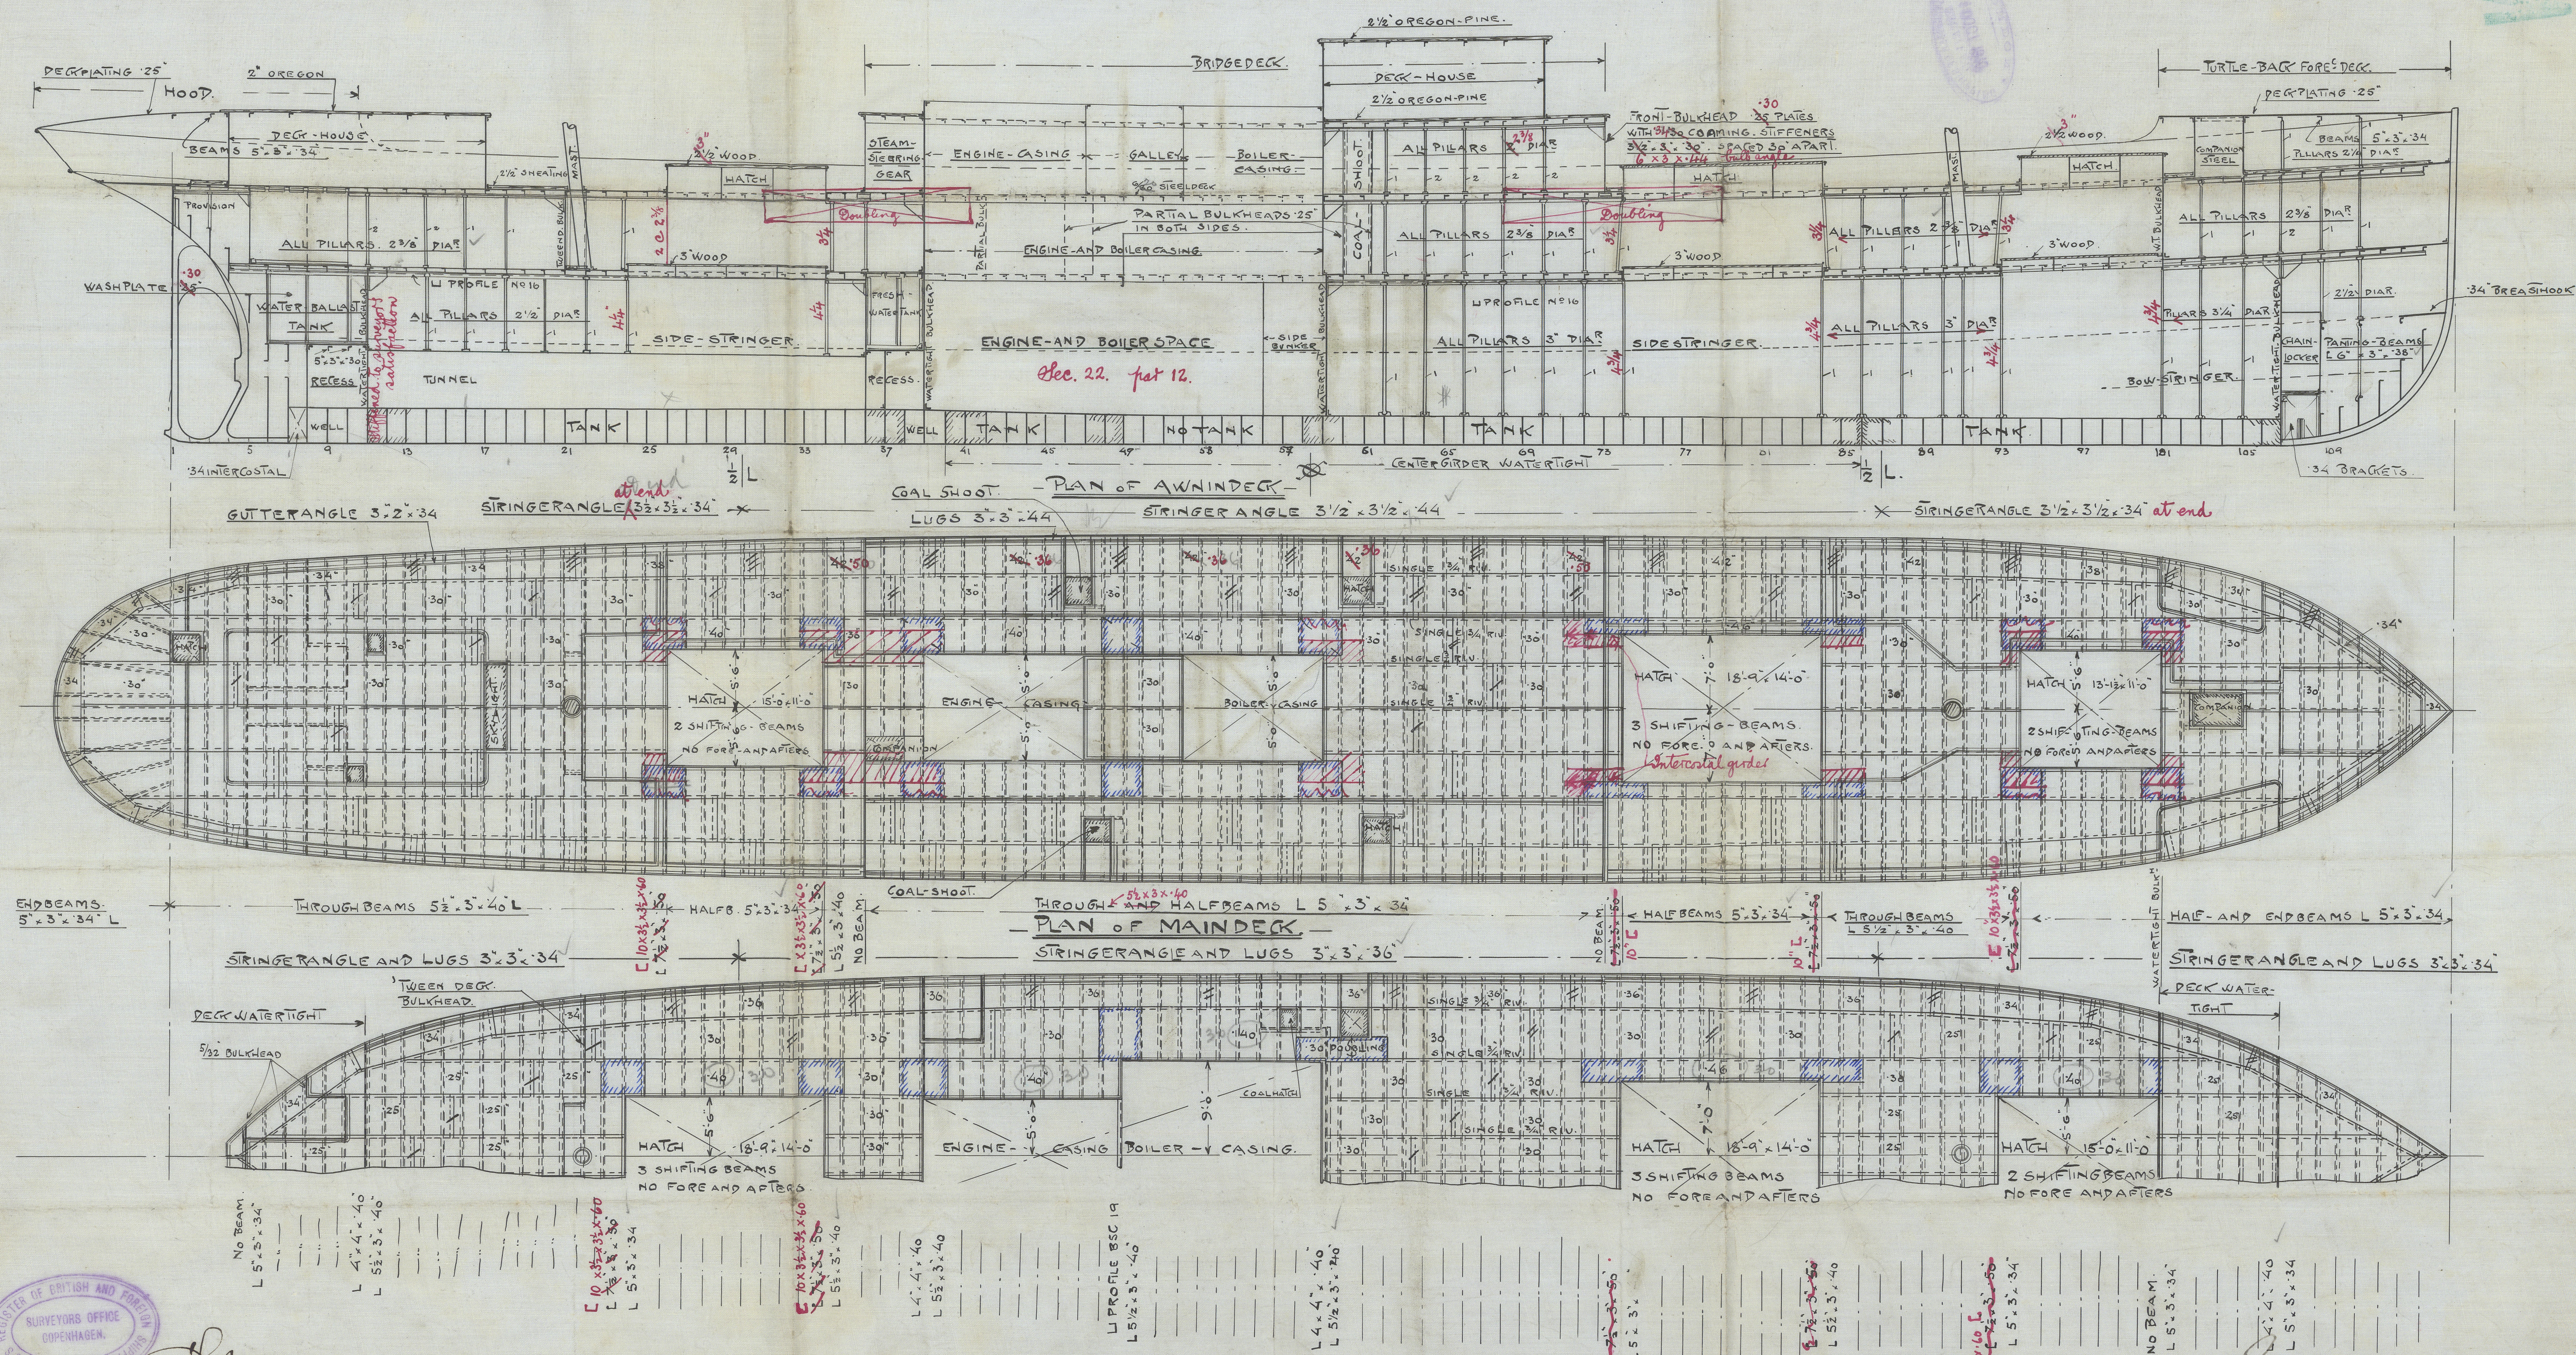

8/10-10

G.A.



7-10-10

Plan of Elevation
for

Kjöbenhavn's Flydedde & Skibsværft

Yard No. 88-89.

Eng. No. 82-83.

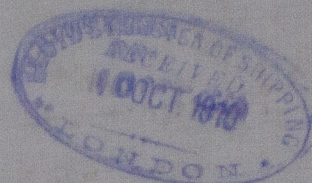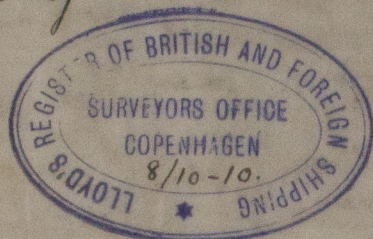

St. Liban
Cpn 3348.

St. St. Petersburg
Cpn 3369.

RETAIN



© 2021

Lloyd's Register
Foundation