


No 363 & 364 S. S. Pardo

3.7.03
13.7.03
17.7.03
30.12.03
18.4.04

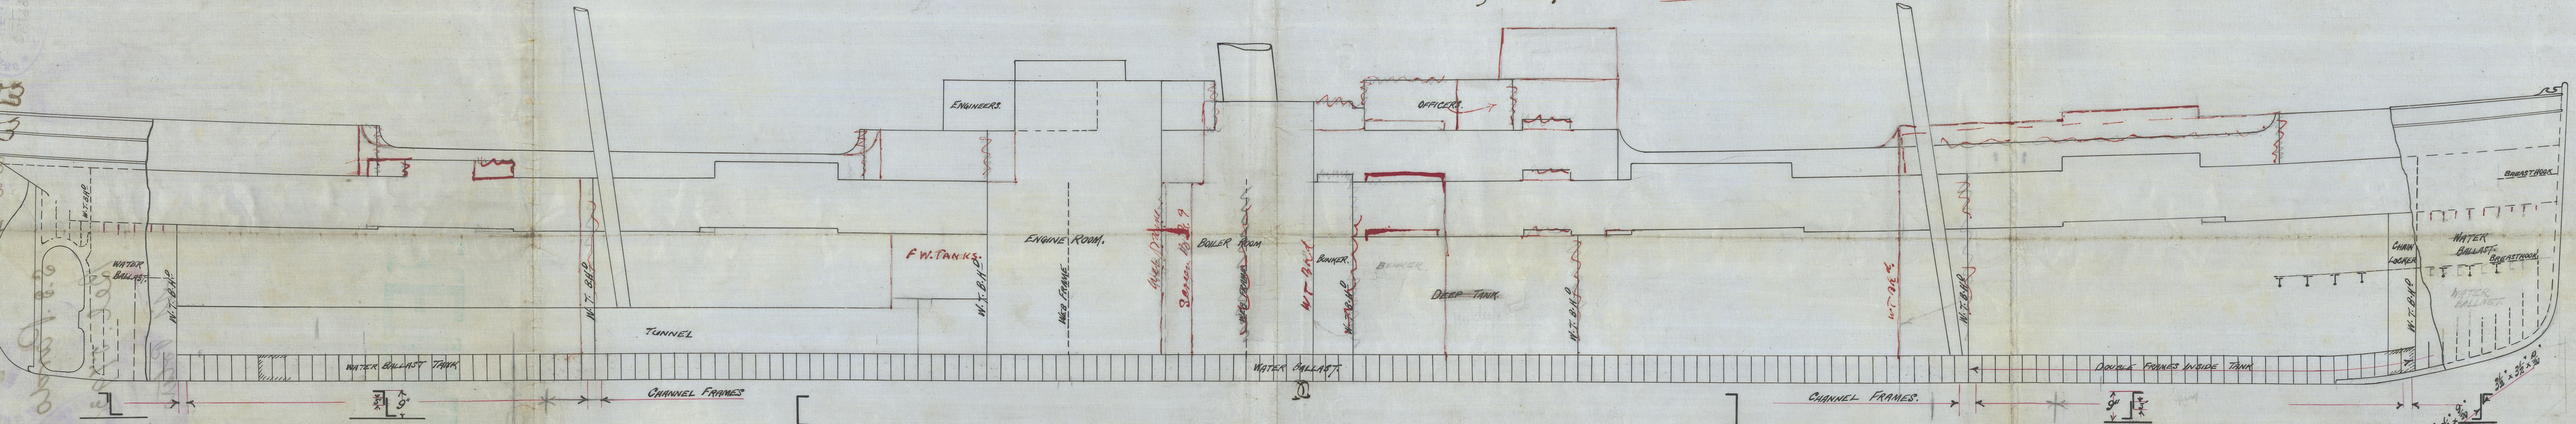

LONGITUDINAL ELEVATION
S. S. 375'-0" x 48'-0" x 29'-6" KEEL TO BEAMS
SCALE 1/16" = 1 FOOT

3/7/03



Belfast
Stanland Wolff
S. S. 373.14 x 48 x 29.5
Longitudinal Section
No 363 & 364.

S.S. Pardo
Bel. 5793


S.S. Potaro Bel 5828.




© 2020

Lloyd's Register
Foundation

W588-0020

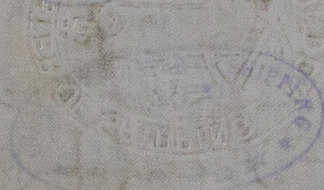


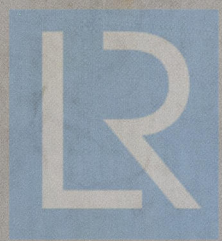

© 2020

Lloyd's Register
Foundation