

Nos 363 & 364


SCALE $\frac{1}{2}$ INCH = 1 FOOT

$$24.0 + 29.5 + 49.66 + .4 - 7 = 96.56 \text{ FRAMING No}$$

$$96.56 \times 373.17 = 36033.29 \text{ PLATING No}$$

$$103.56 \times 373.17 + 2917 = 41563.18 \text{ EQUIPMENT No}$$

BREADTH TO LENGTH = 7.79
DEPTH TO " TO UPPER DECK = 12.81
" " " " LOWER DECK 17.3

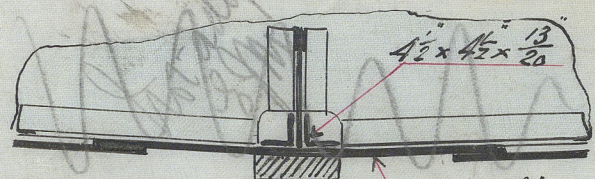

KEEL 10'x3'
ALTERNATIVE ARRANGEMENT
OF FLAT KEEL PLATE



Belfast
Harland & Wolff:

S.S. 373.17 x 40 x 29.5

Midship Section

No 363 & 364

S.S. Pardo

Bel. 5793

S.S. Potaro


Bel. 5828.

REF
R

© 2020

Lloyd's Register

W588- Foundation

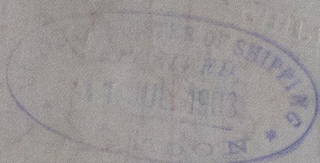

2.2.03

WIDSHIP REGISTER



© 2020

Lloyd's Register
Foundation