





SHEER FORWARD 190°
 " 181° 06'
 " AFT 60°
 " 161° 33'
 LONGITUDE COR. ABOUT 78°
 RADIUS OF DECK 15°

S.S. MARSLER
 No. 780

LONGITUDINAL & DECK

SCALE 1/8" = ONE FT.
 DIMENS - 385' 0" B.P. x 52' 0" E.C. x 51' 9" M.M. x 29' 6" M.M. TO UPPER DECK.

NOTE
 THE SCANTLING & DETAILS OF CONSTRUCTION NOTED HEREON
 ARE SUBMITTED ON THE UNDERSTANDING THAT THEY ARE THE
 MINIMUM WHICH WILL BE ACCEPTED FOR CLASS, & IT NOT BEING
 INTENDED TO BE REMEDIED, ERRORS & OMISSIONS EXCEPTED
 PLAN OF HATCHES, BULKHEADS, TUNNEL,
 DECK GIRDERS & BOTTOM STRENGTHENING FOR
 WILL BE SUBMITTED LATER

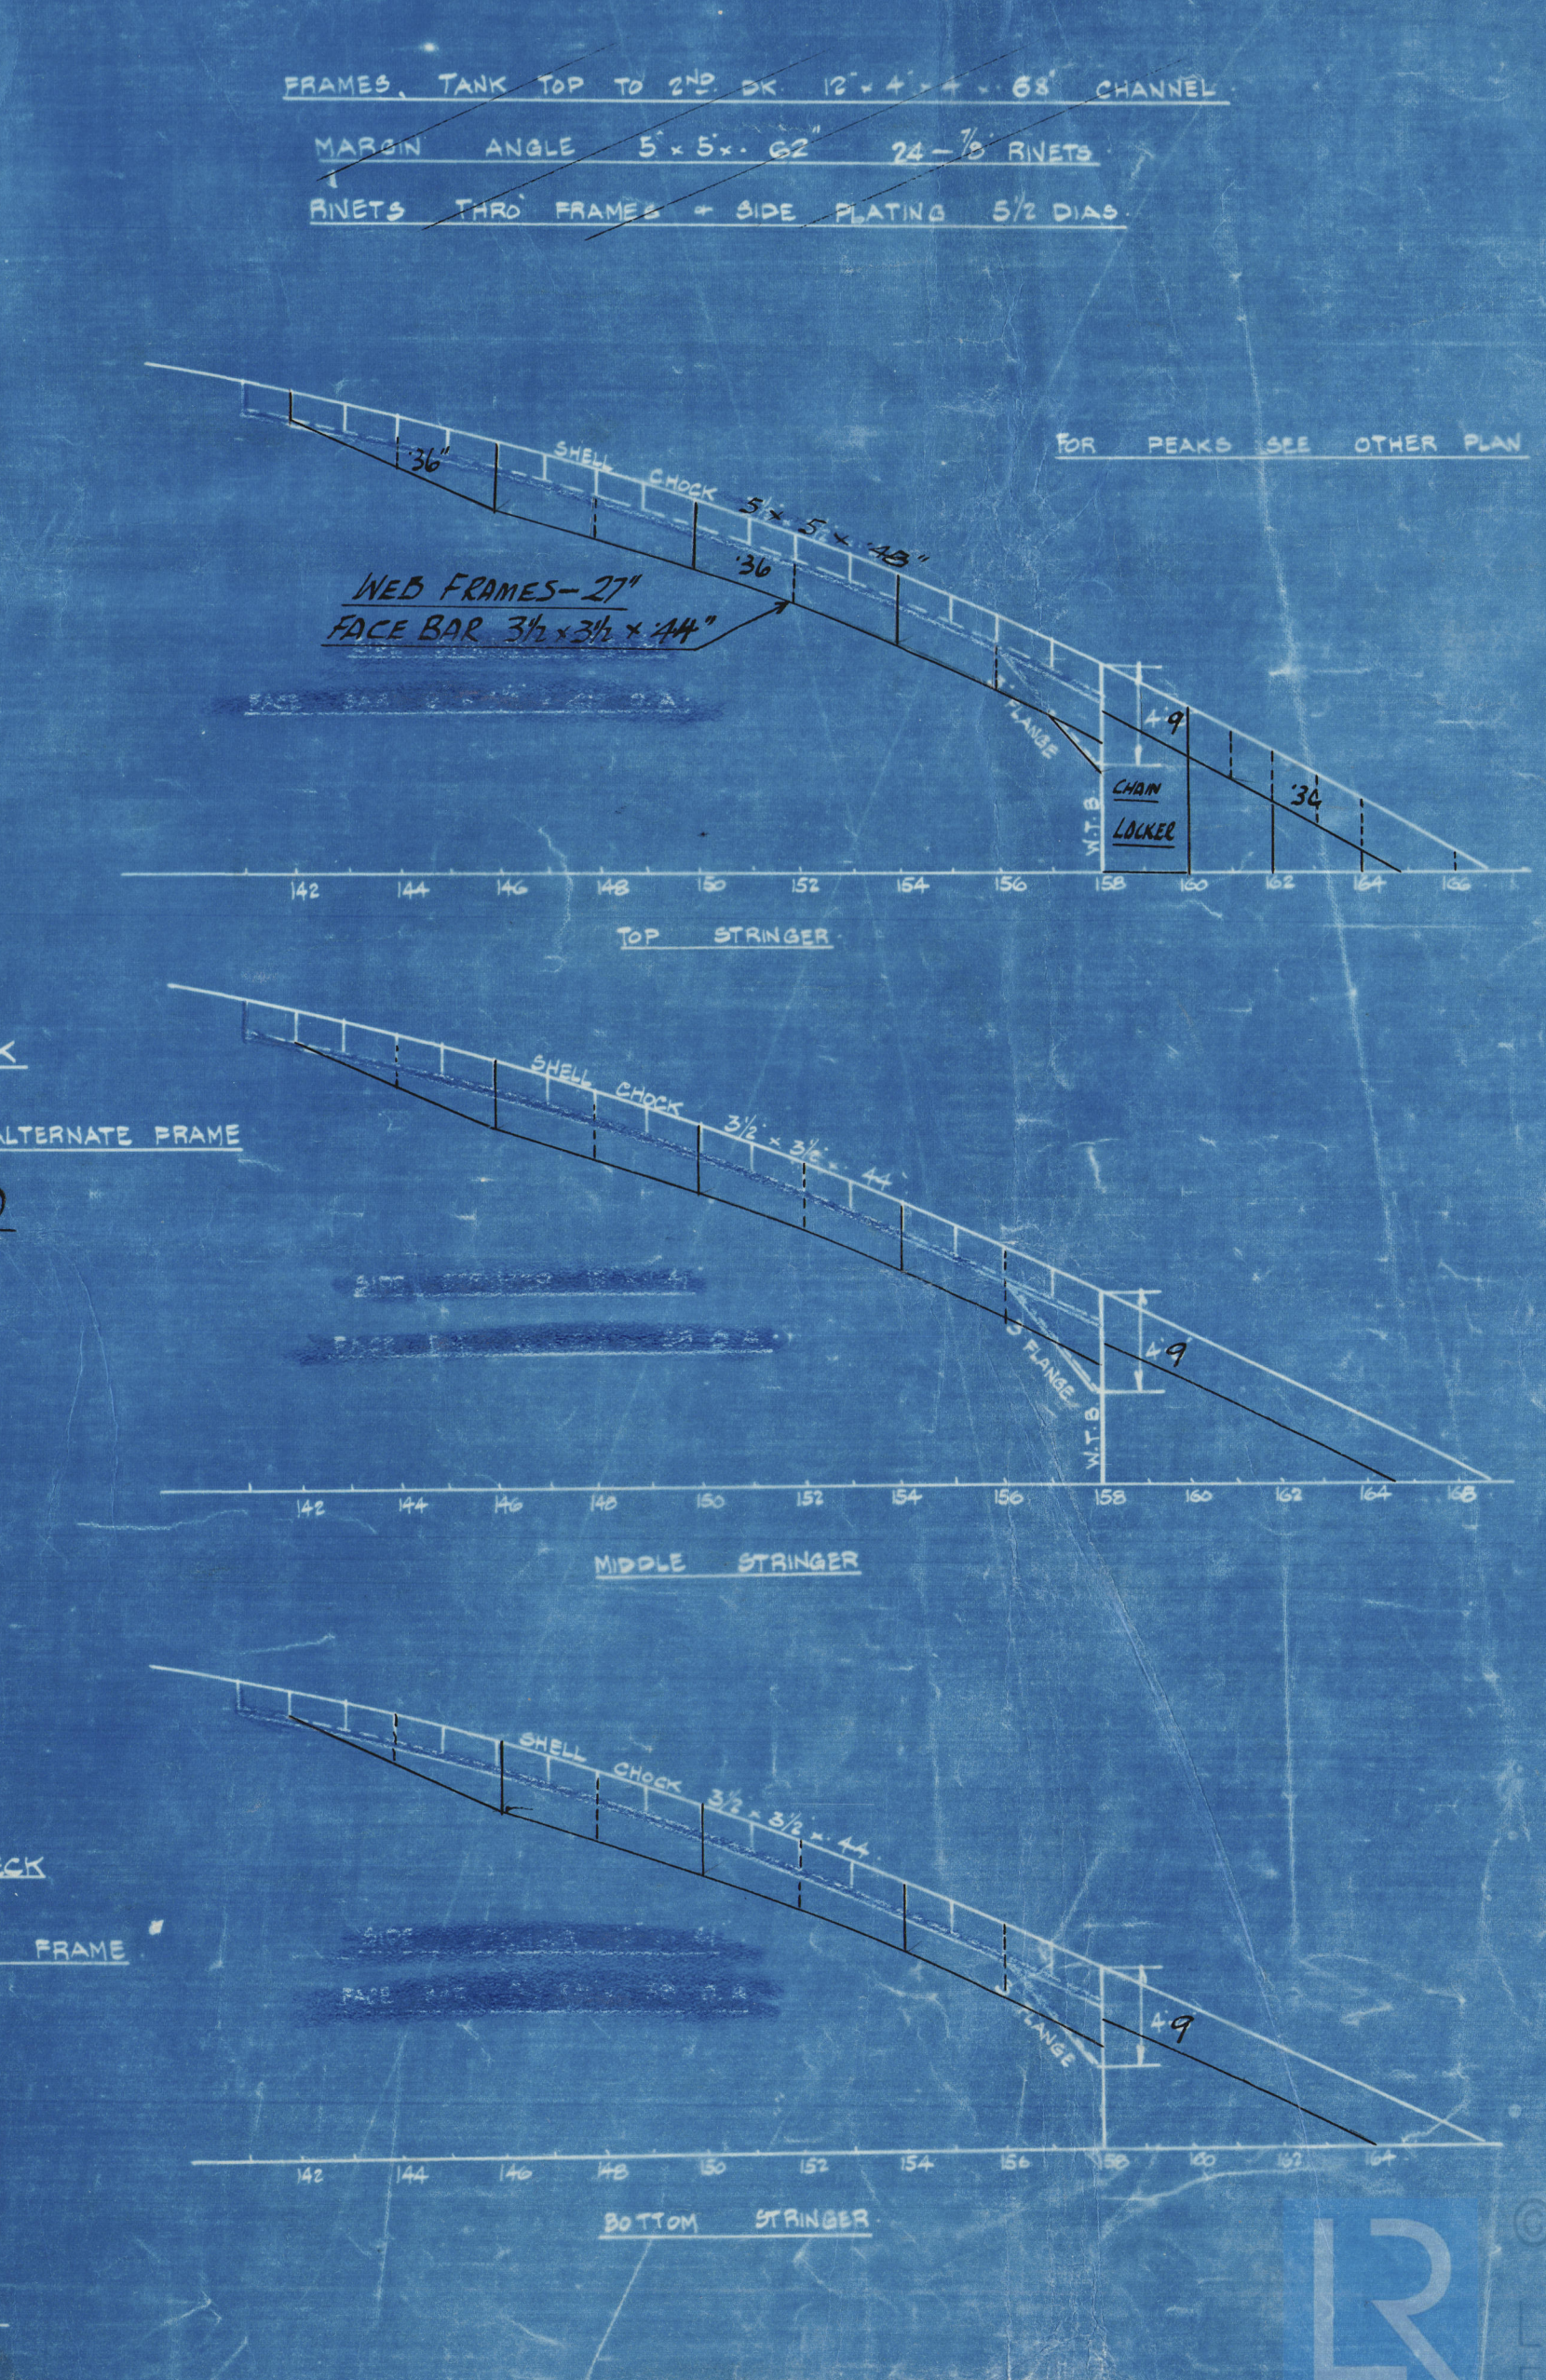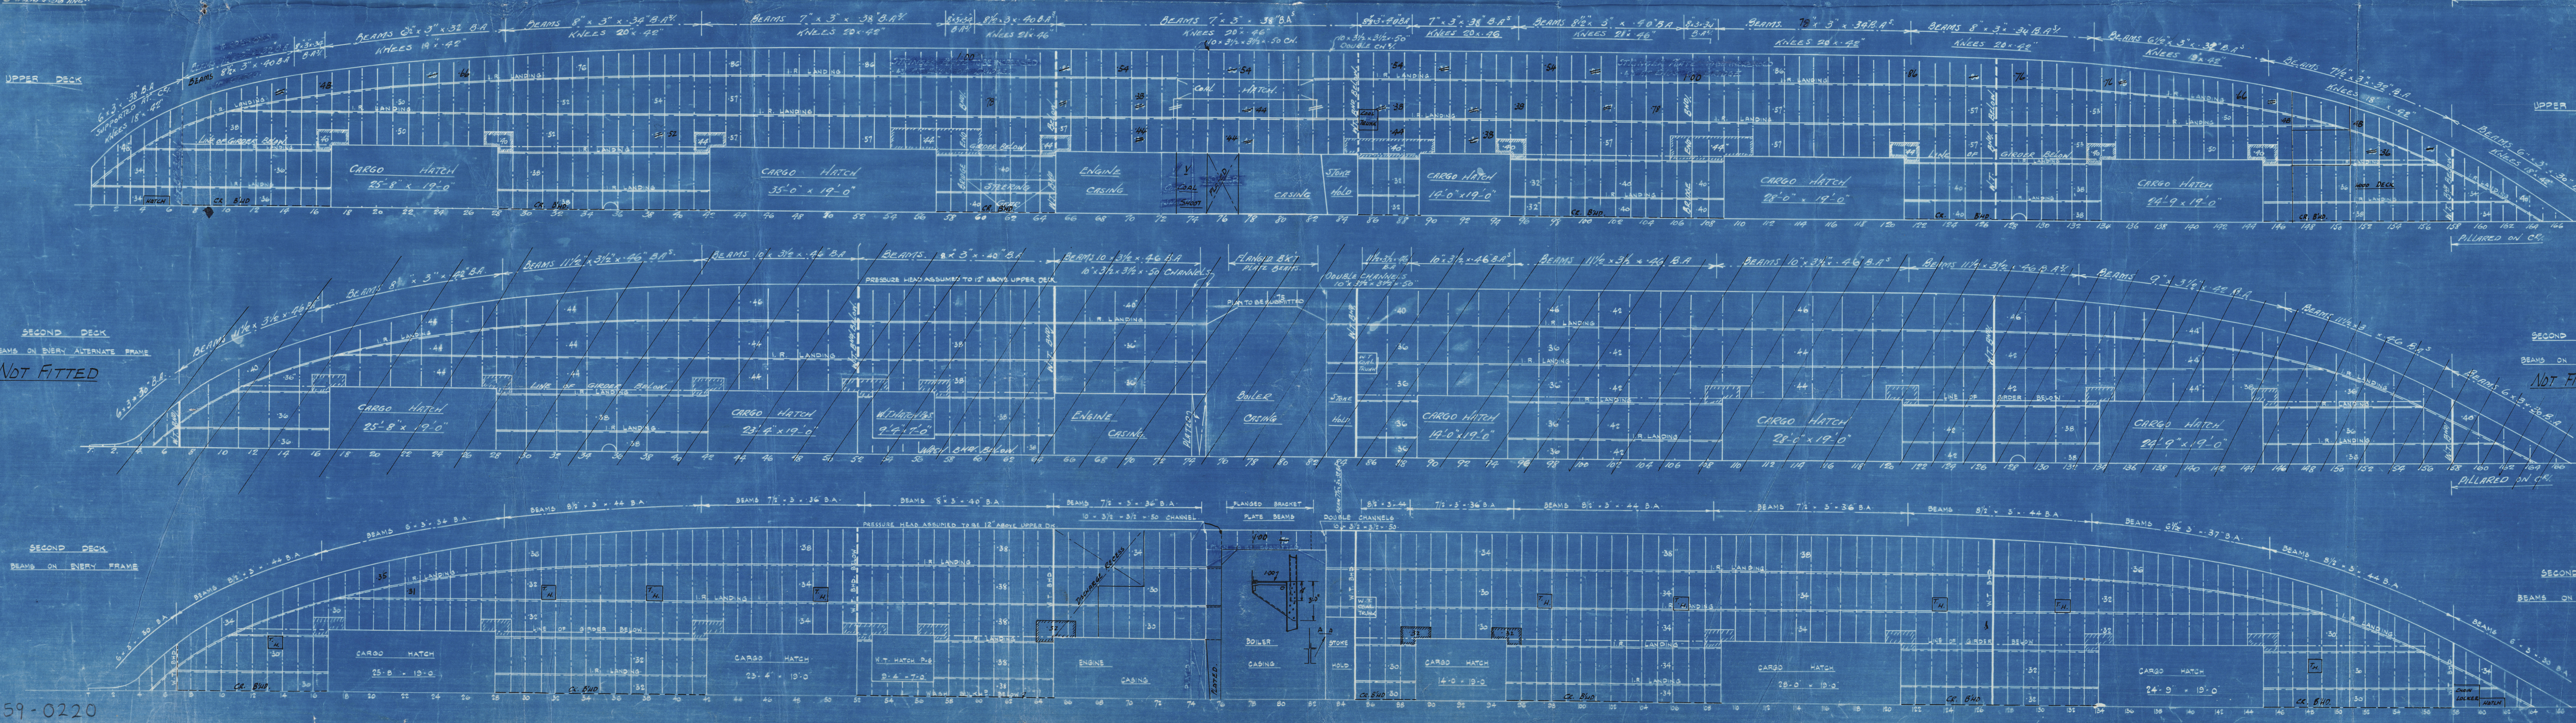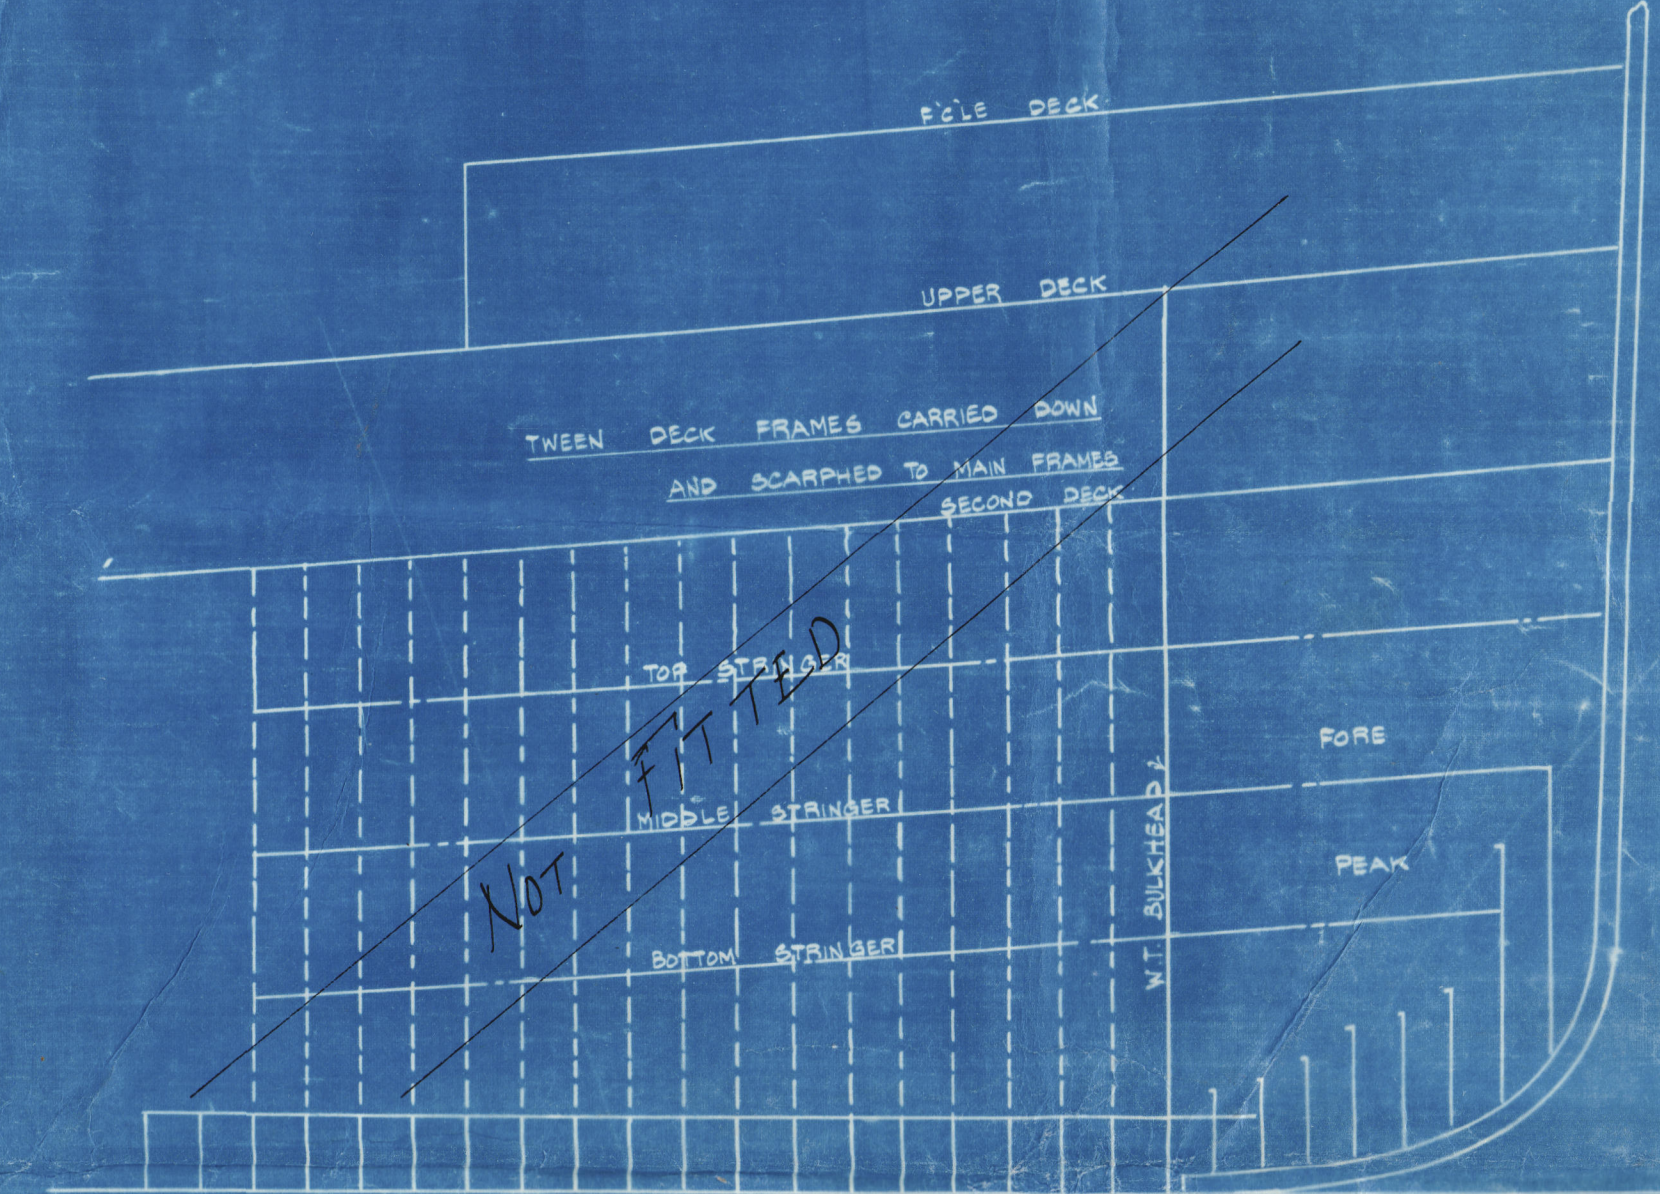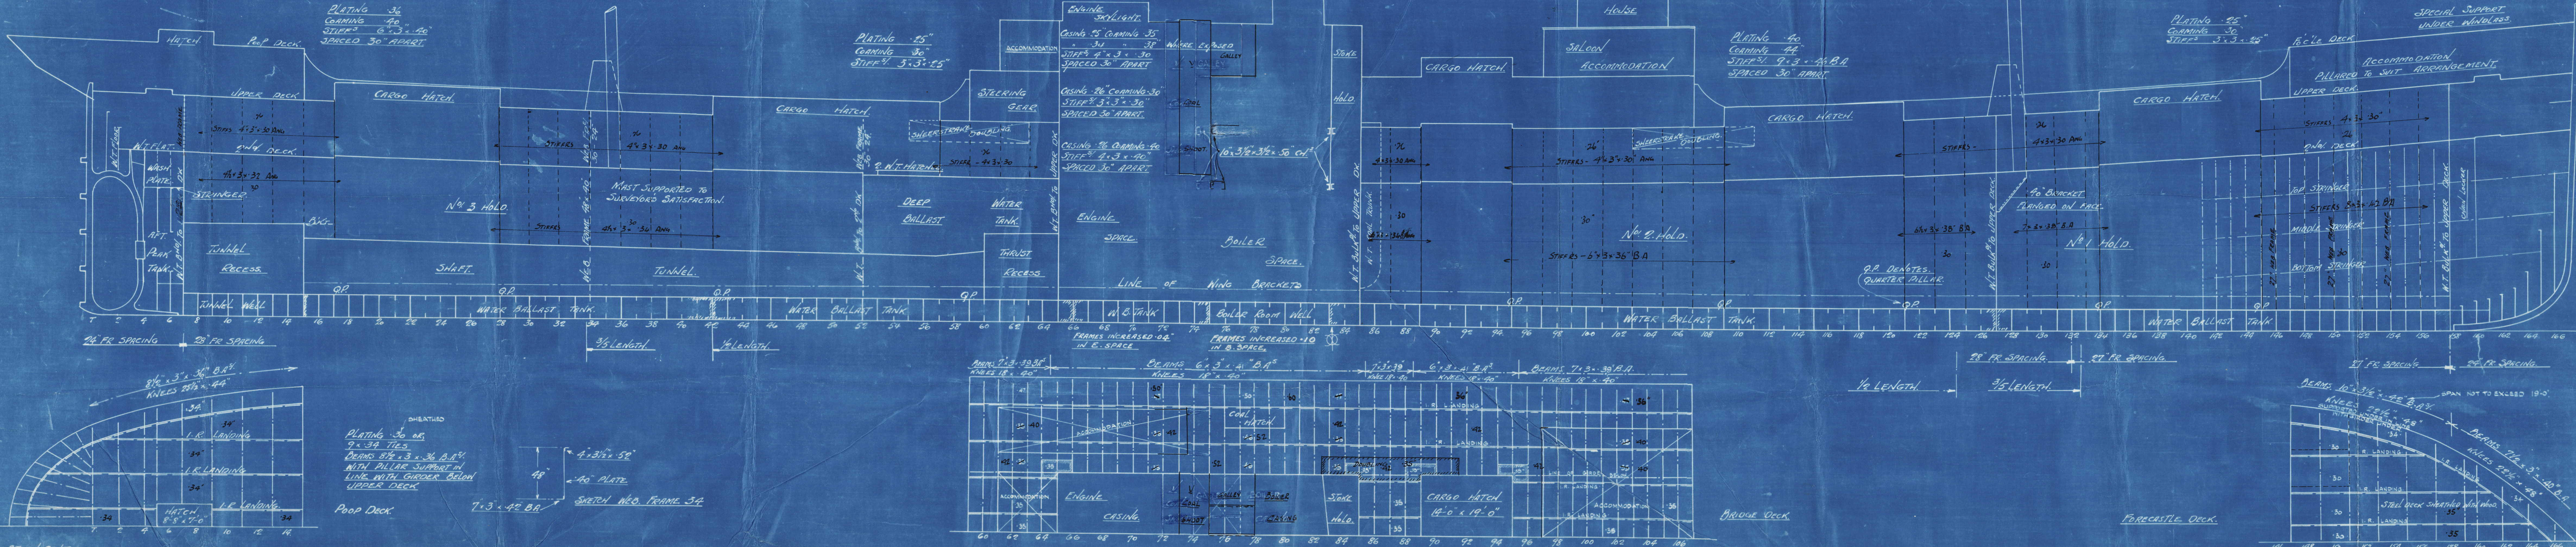

W59-0220


Lithgow Limited

No 780.

S. S. "MARSEN"

Profile & Becks (as built).

Grk Rep No. 18576.

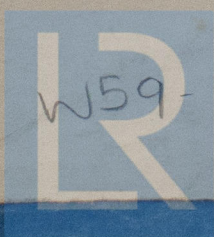

© 2021

Lloyd's Register

Foundation