



S. S. 342  
PLAN OF UPPER DECK  
SHOWING ENGINE & BOILER OPENINGS  
SCALE  $\frac{1}{4}$  = ONE FOOT.



 

Belfast  
Charlotte Wolff's  
No 342

Plan of Upper deck  
Walmer Castle

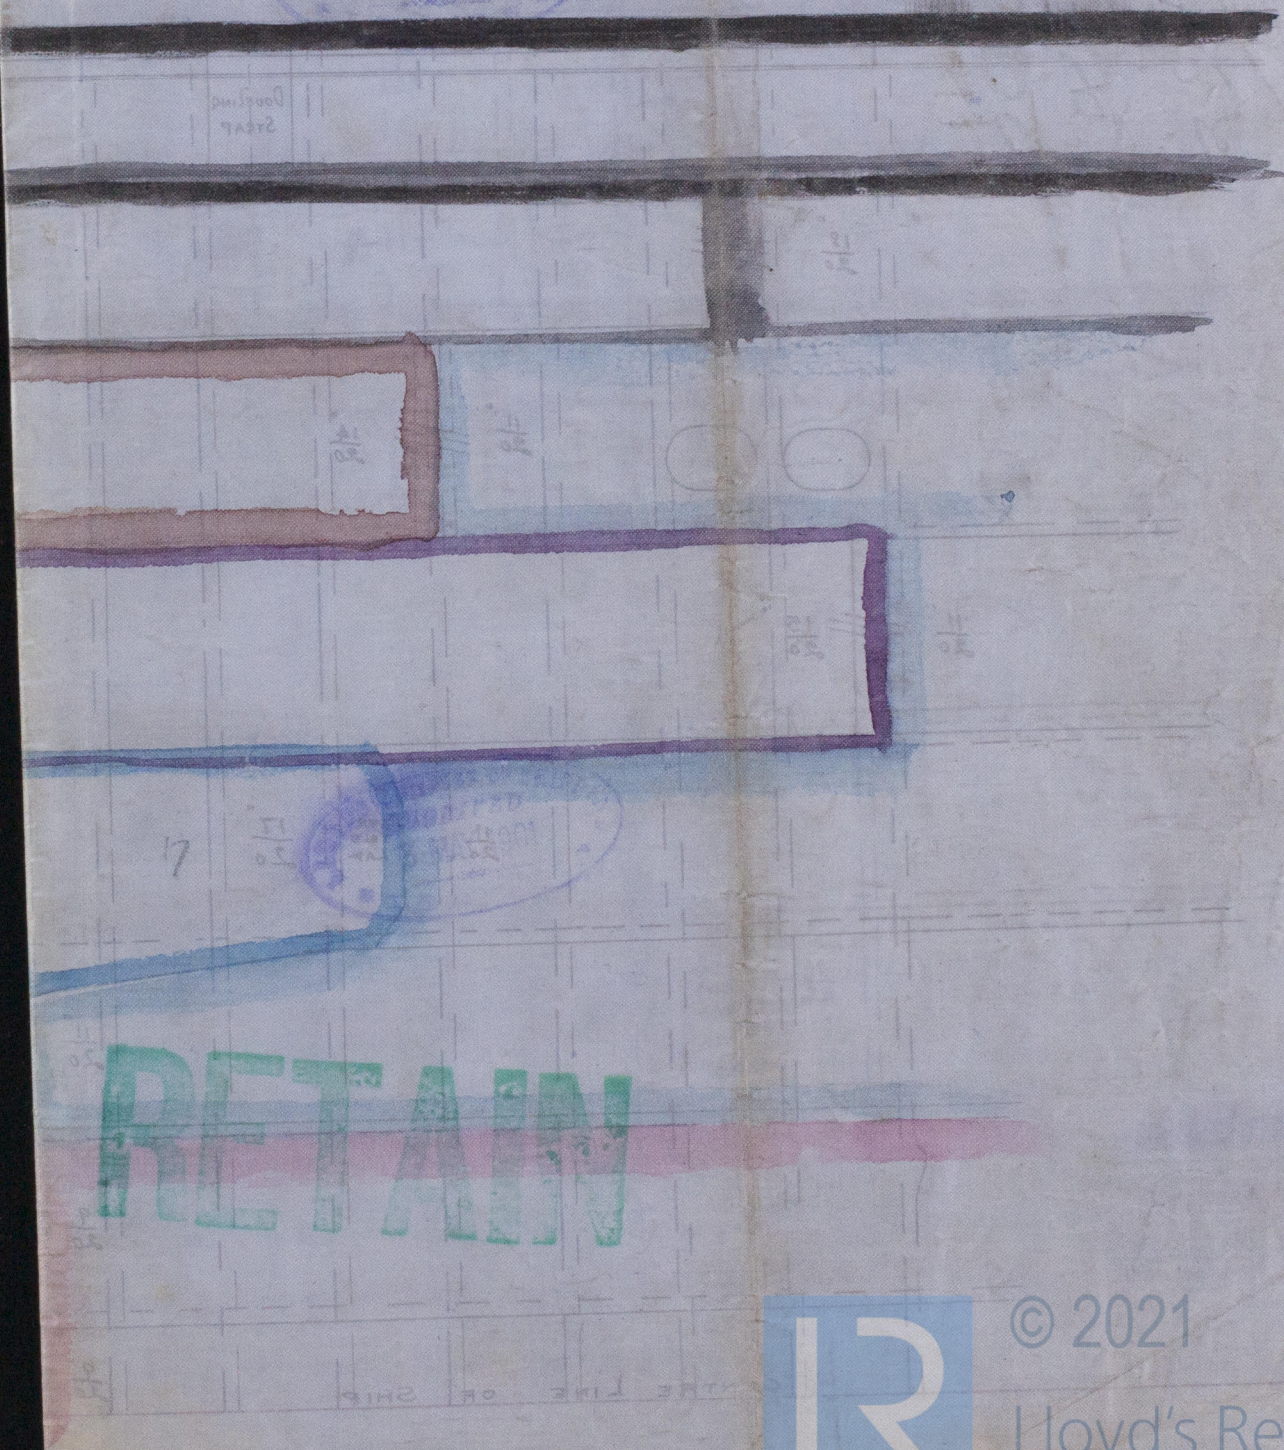

RETAIN

W590-0102



© 2021

Lloyd's Register  
Foundation