



2.4.01  
 13.4.01  
 27.5.01

"WALMER CASTLE"  
 S. S. N° 342  
 TRANSVERSE SECTIONS THRO'  
 ENGINE AND BOILER SPACES  
 SCALE  $\frac{1}{4}$ " = ONE FOOT

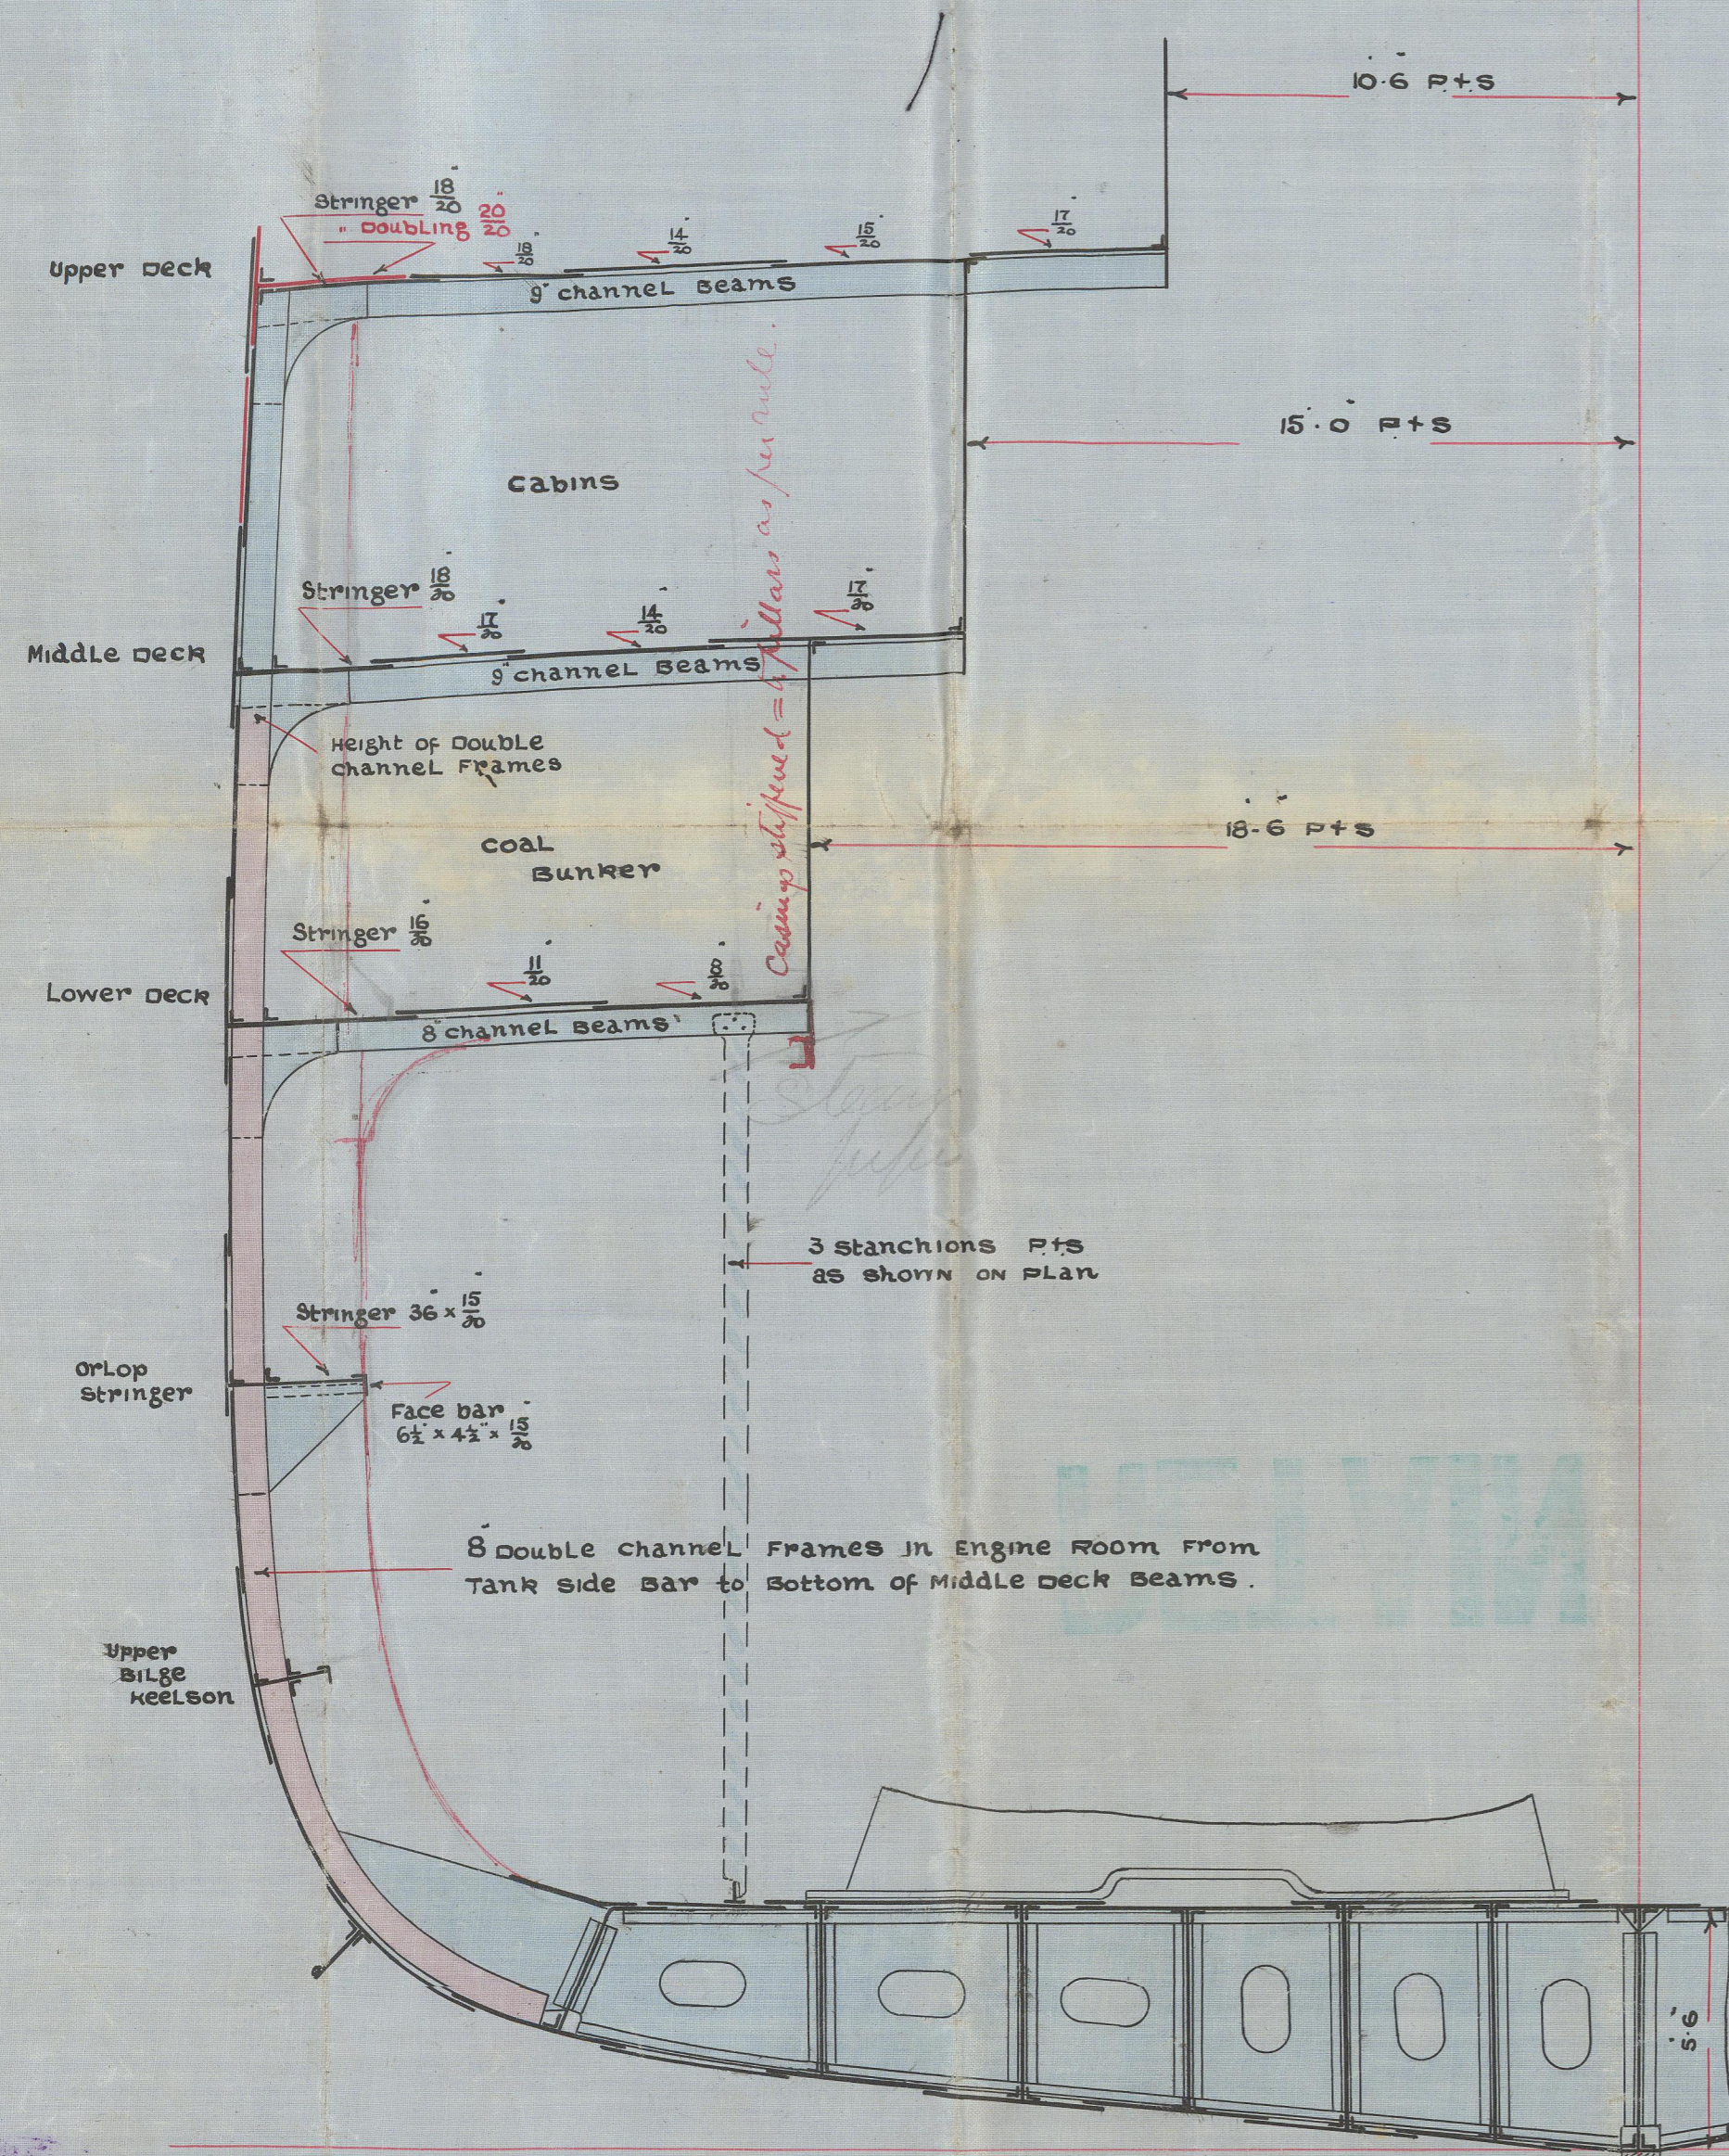





Section thro' Engine Space

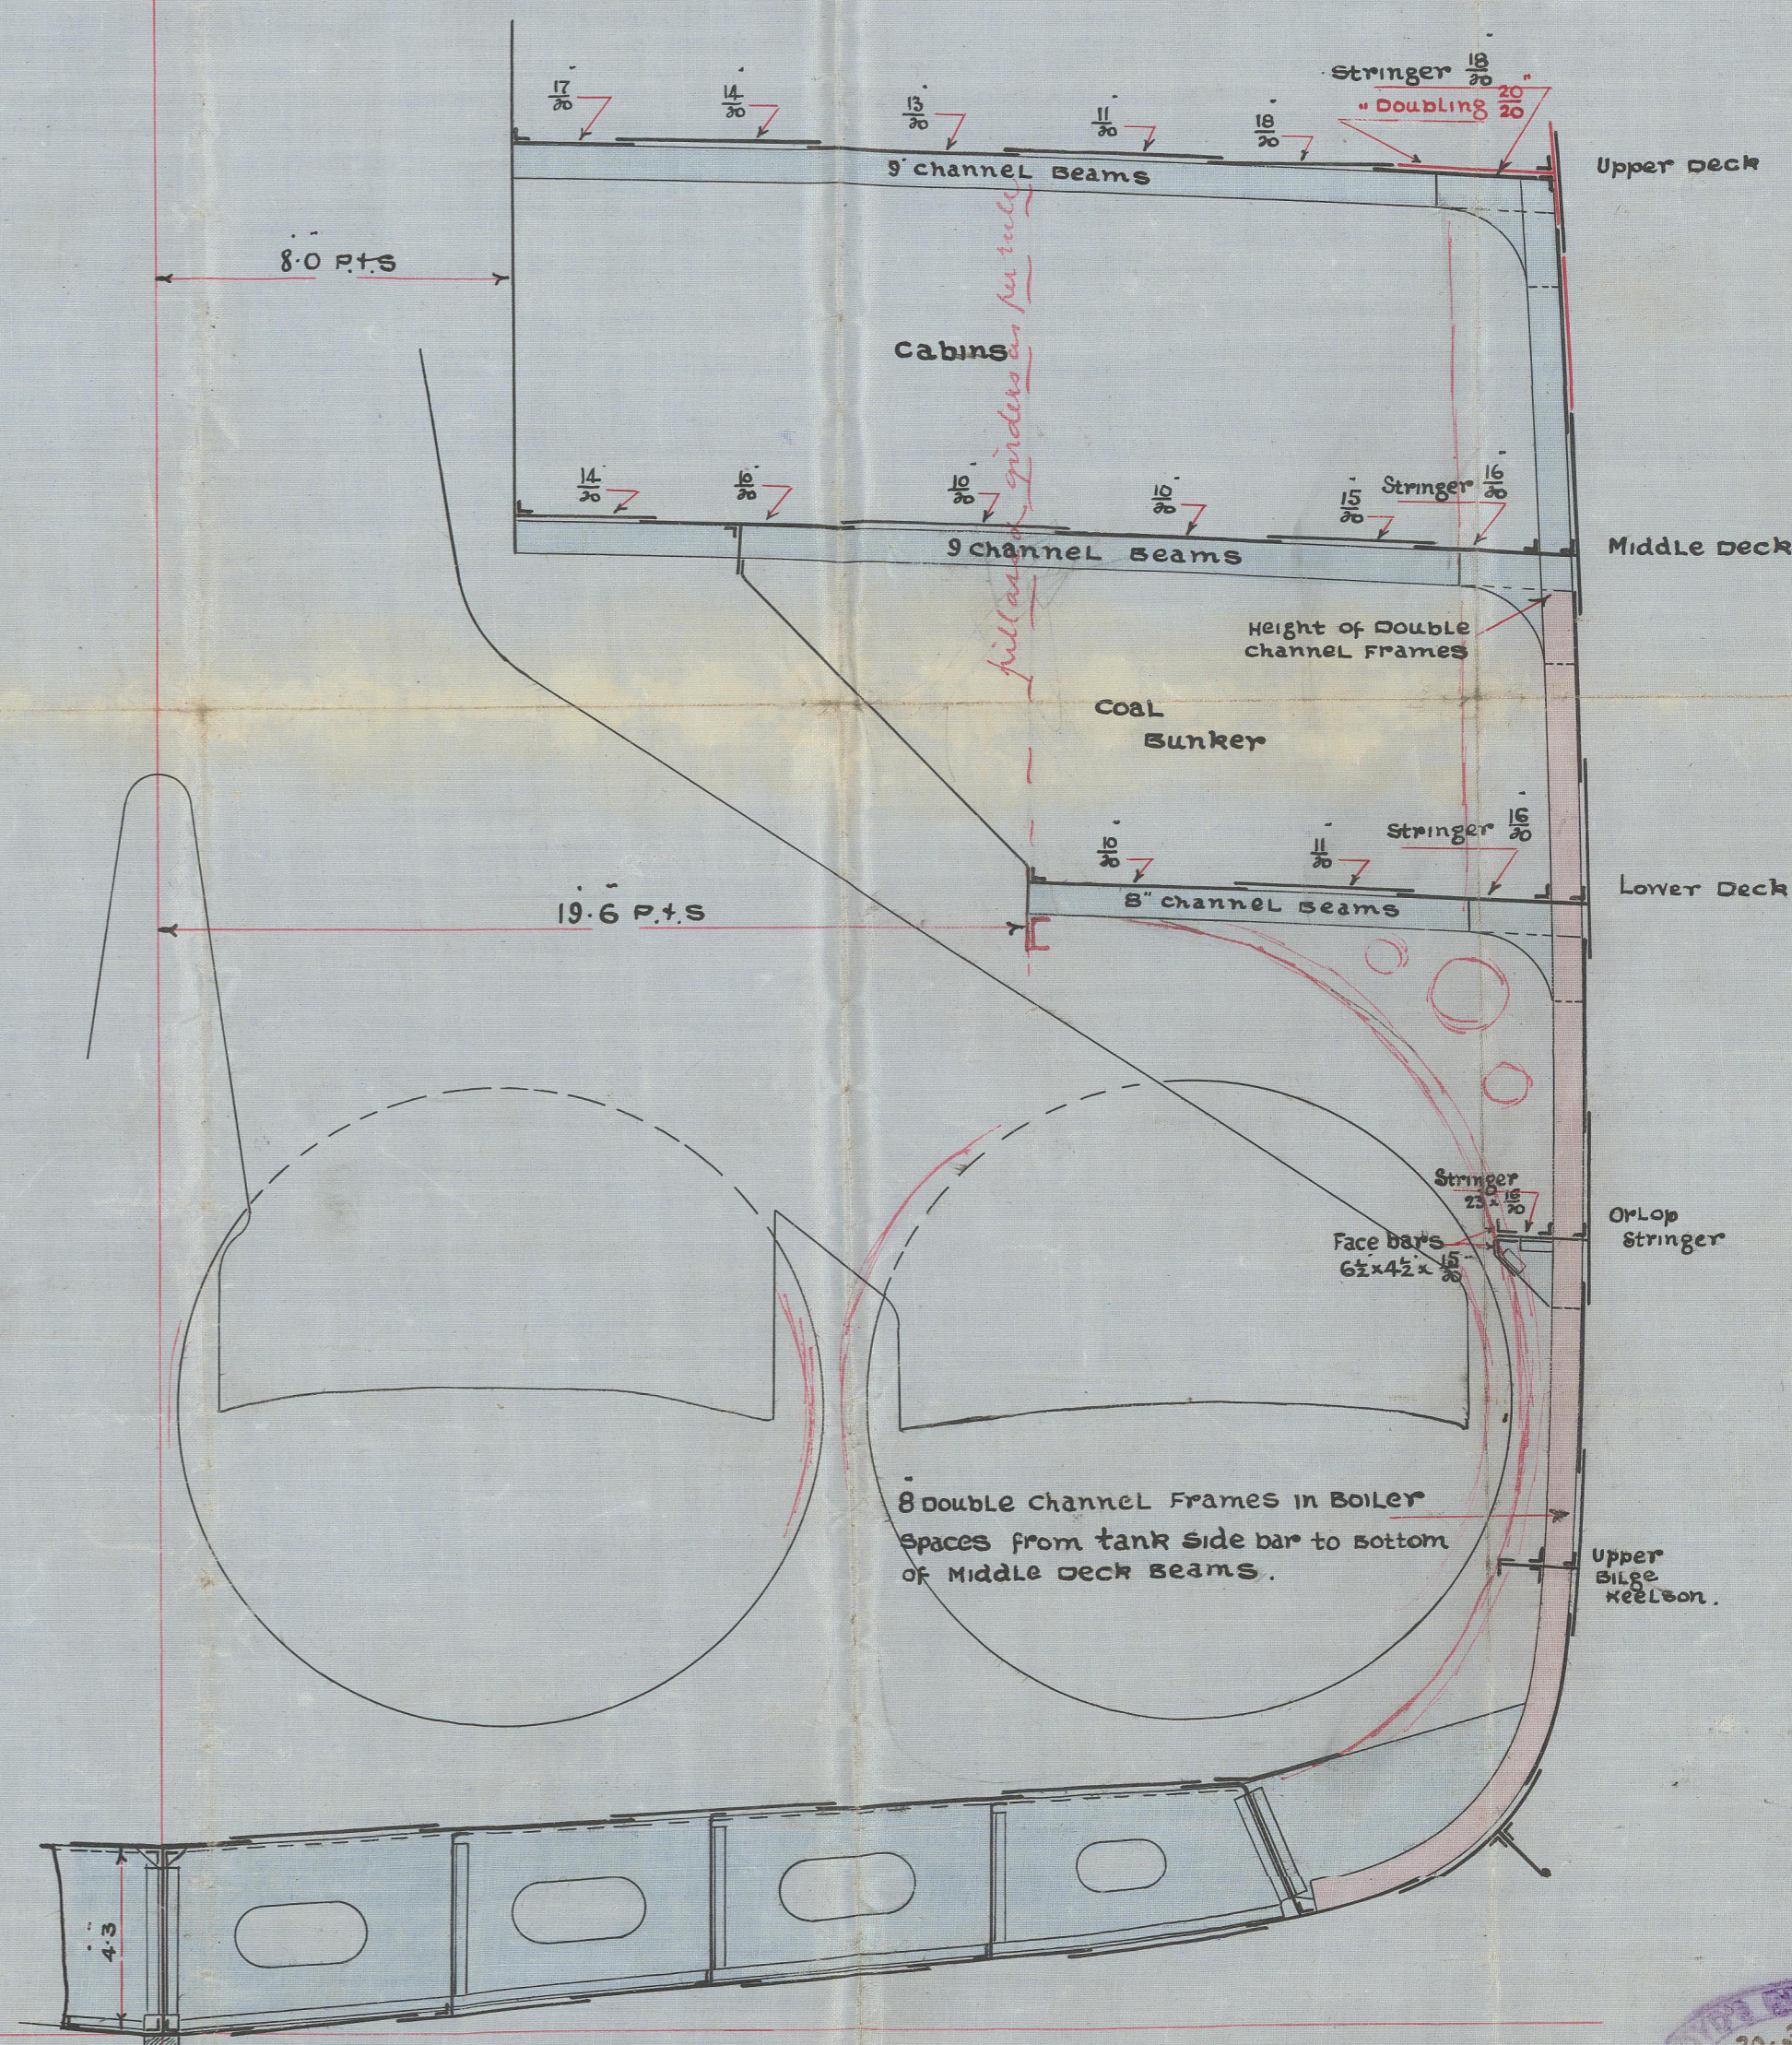

Section thro' Boiler Spaces

Belfast.  
Holland Wolff's  
No 342 -

Transverse Section in  
Engine & Boiler space  
Walmer Castle

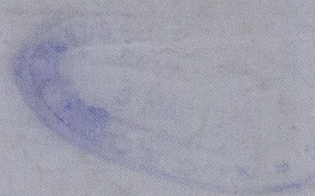 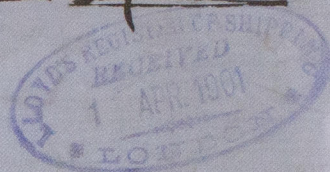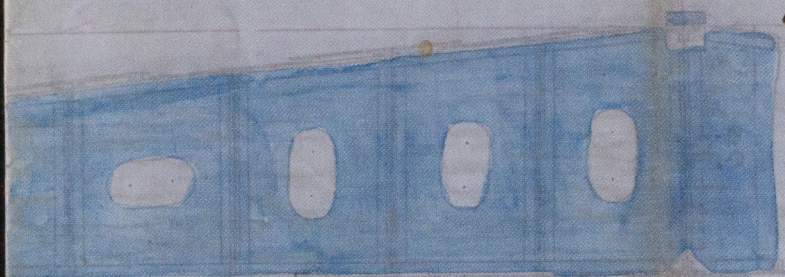

RETAIN



© 2021

Lloyd's Register  
Foundation

W5910-0106