


3.6.09
25.6.09

— Longitudinal Section of Screw Steamer. —
Dimensions 350' x 45' 9" x 29' 6" M.L. to Spar Deck.
Scale $\frac{1}{2}$ " = 1 foot.

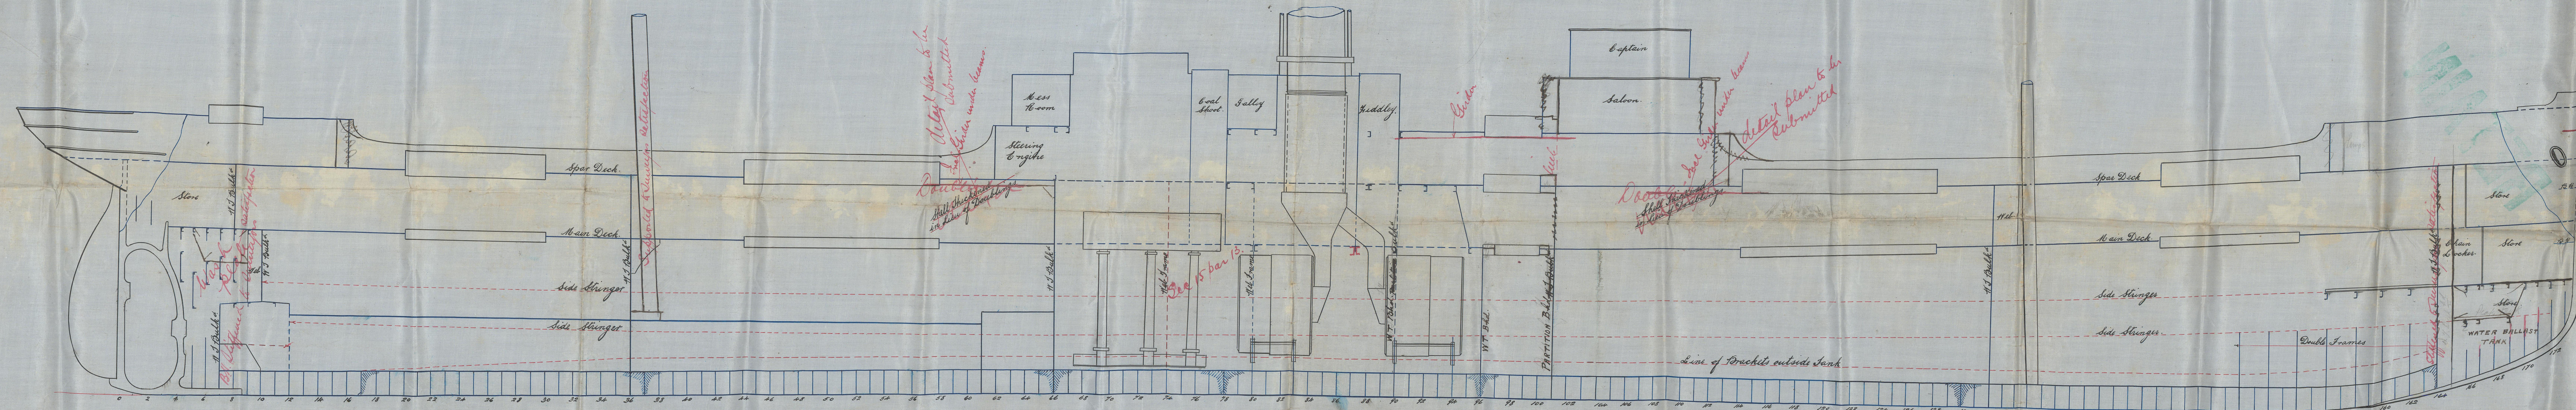

At least plan to be submitted
Detail plan to be submitted

Detail plan to be submitted
Detail plan to be submitted

Deck plans to be submitted.

Bottom forward strengthened as per rule.

C.B.
3.6.09.

Workman Clark & Co.

N^o 288

Profile

© 2021

Lloyd's Register
Foundation

W590-0178