


MIDSHIP SECTION

SSN 578-588

DIMS: 400' BP x 52' EX 51'9" MLD x 30' MLD

TO CLASS 100 A.1 AT LLOYDS SPECIAL SURVEY SPAR DR RULE

SCALE 1/2" = 1'-0"

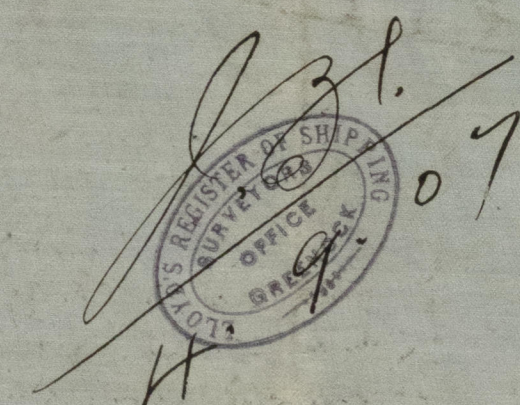

13.9.07
No. 588442 19.9.07

SCANTLINES & DETAILS OF CONSTRUCTION NOTED HEREON
ARE SUBMITTED ON THE UNDERSTANDING THAT THEY ARE THE
MINIMUM WHICH WILL BE ACCEPTED FOR CLASS AT THIS DATE AND
IF NOT THEY ARE TO BE AMENDED. ERRORS & OMISSIONS EXCEPTED





EQUIPMENT NUMERAL

1/2 BEAM	25.85
1/2 GIRTH	53.23
DEPTH	31.04
LENGTH	110.12
	43972.70

POOP 36'0" x 75, BRIDGE 120'0" x 75, FORECASTLE 40'0" x 75 = 2250.00
46022.70
ERECTOR'S ON ERECTIONS (52 x 723) 377.00
EQUIPMENT NUMERAL 46399.70


EQUIPMENT

2 BOWER ANCHORS	18 CWT EX STOCK
1 " "	40 1/2 " " "
1 STREAM " "	16 1/4 " " "
1 KEDGE " "	7 " " "
270 FATHOMS 2 1/4" STUD CHAINCABLE - 645-3-0	
90 " 1 1/4" STREAM CHAIN OR 4 3/4" STEEL WIRE 1 1/2" CABLE	
120 " 1 1/4" TOWLINE OR 4 3/4" STEEL WIRE	
2 WARPS 8" OR 2 3/4" STEEL WIRE 90 FMS EACH	
2 " 7" 2 1/2" " " " "	

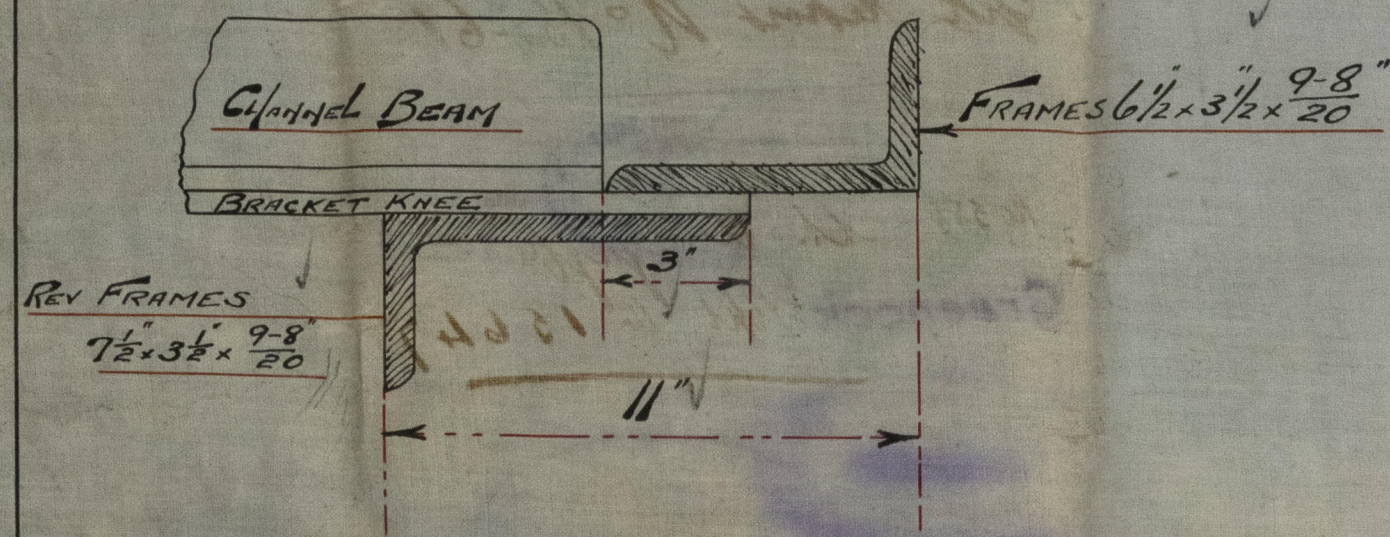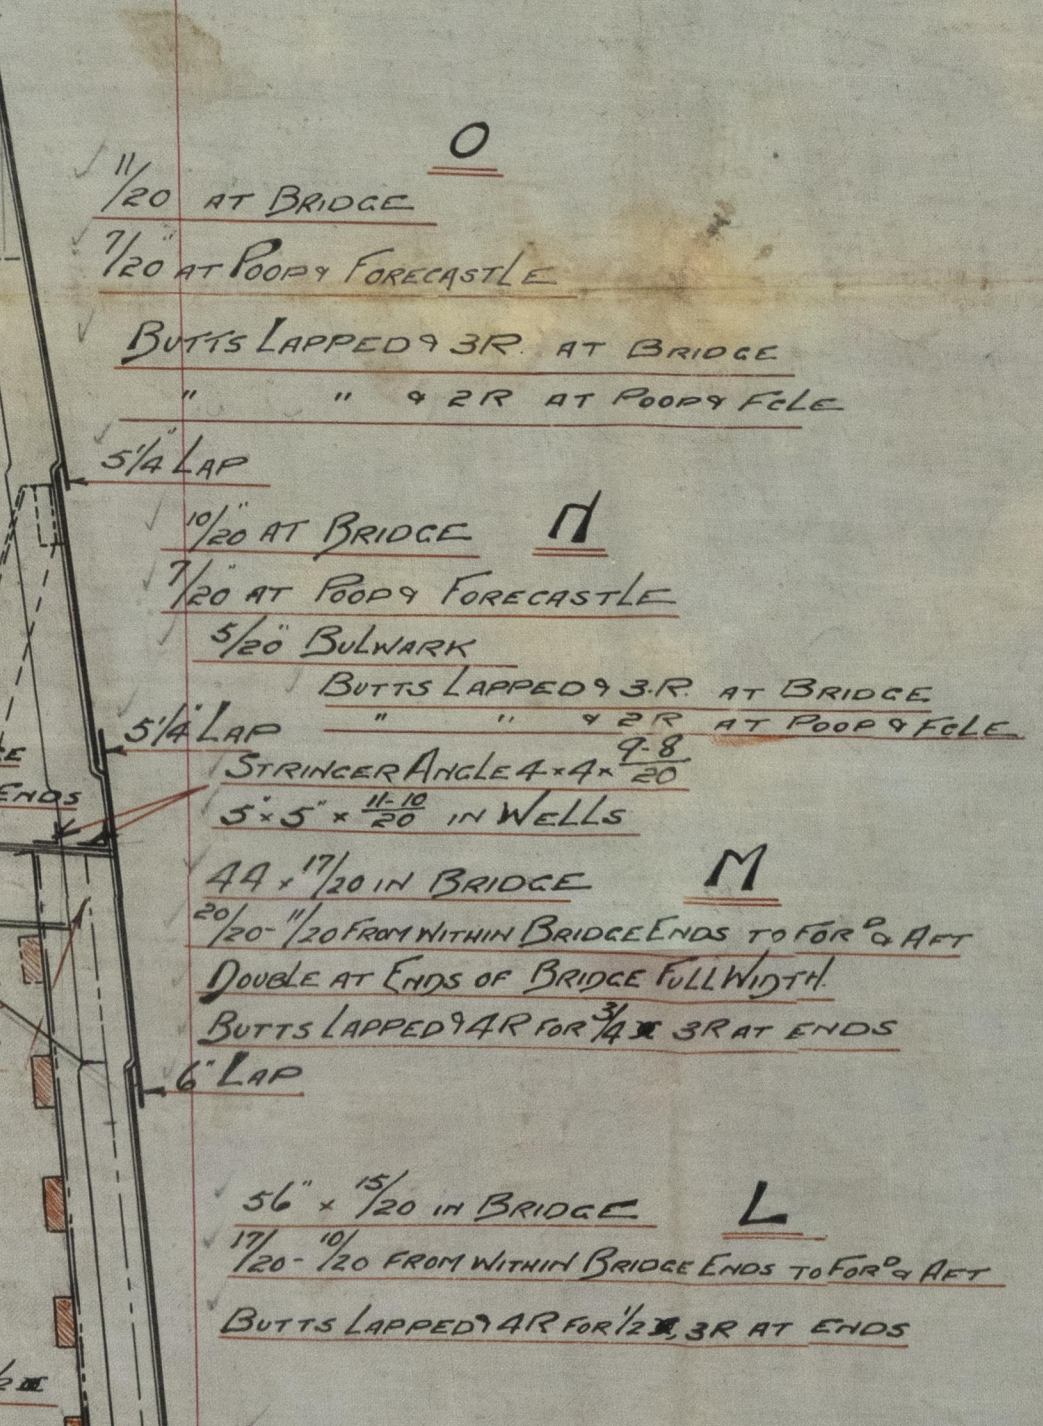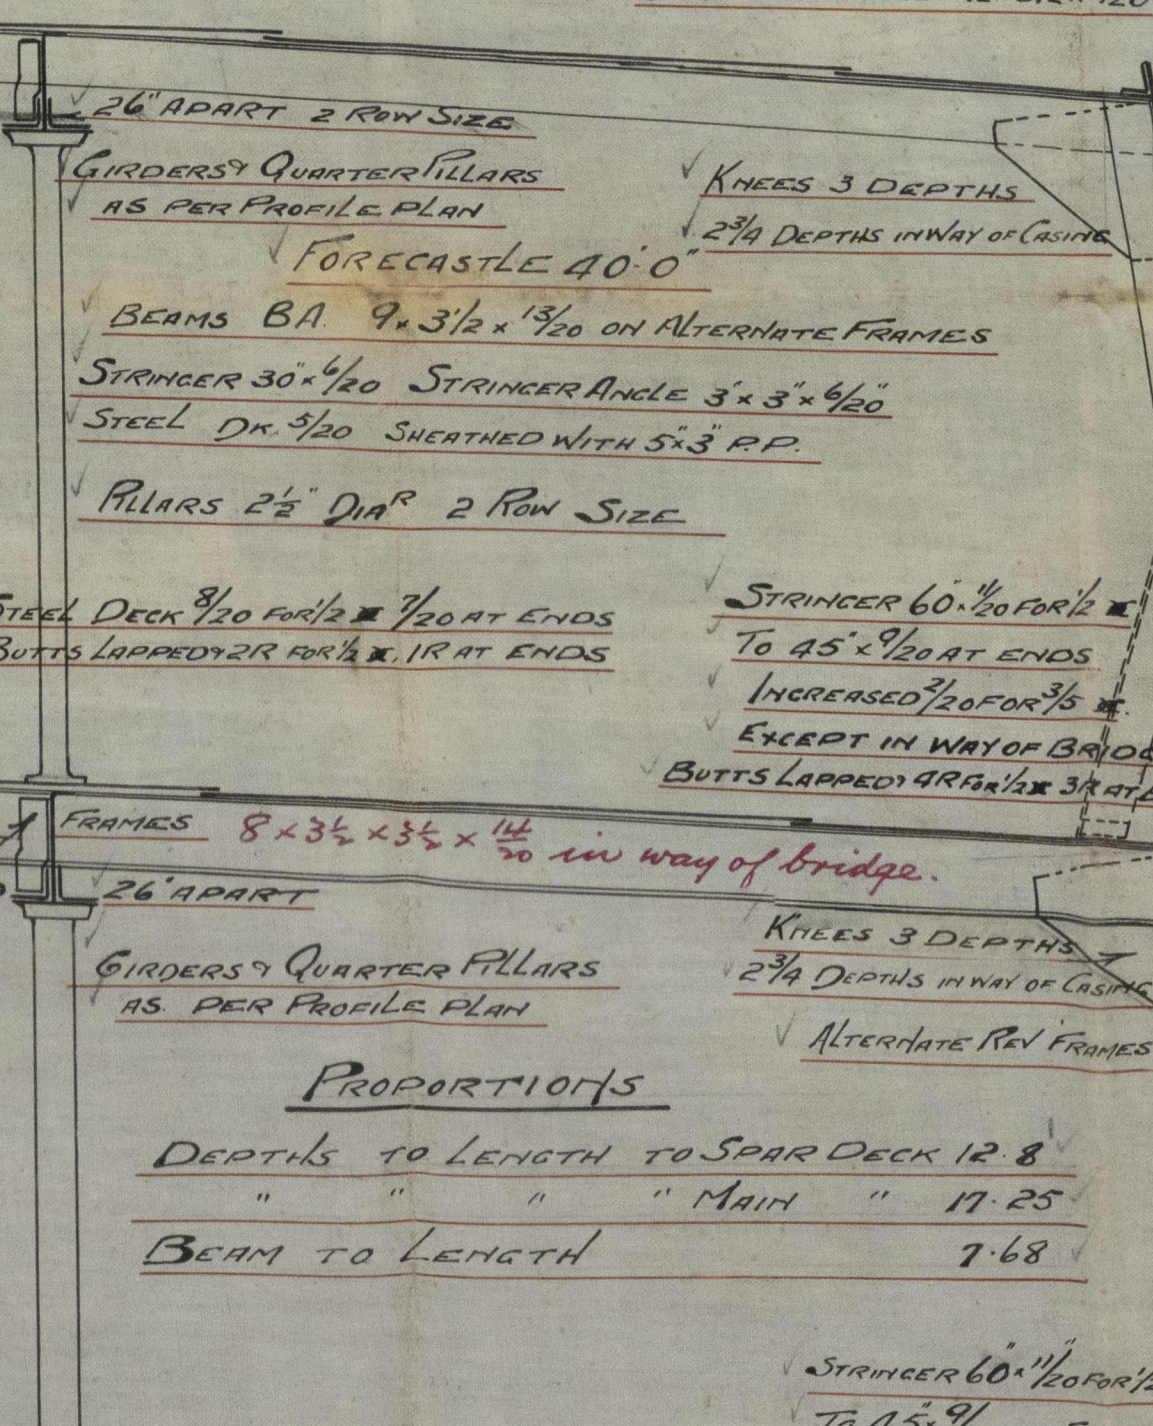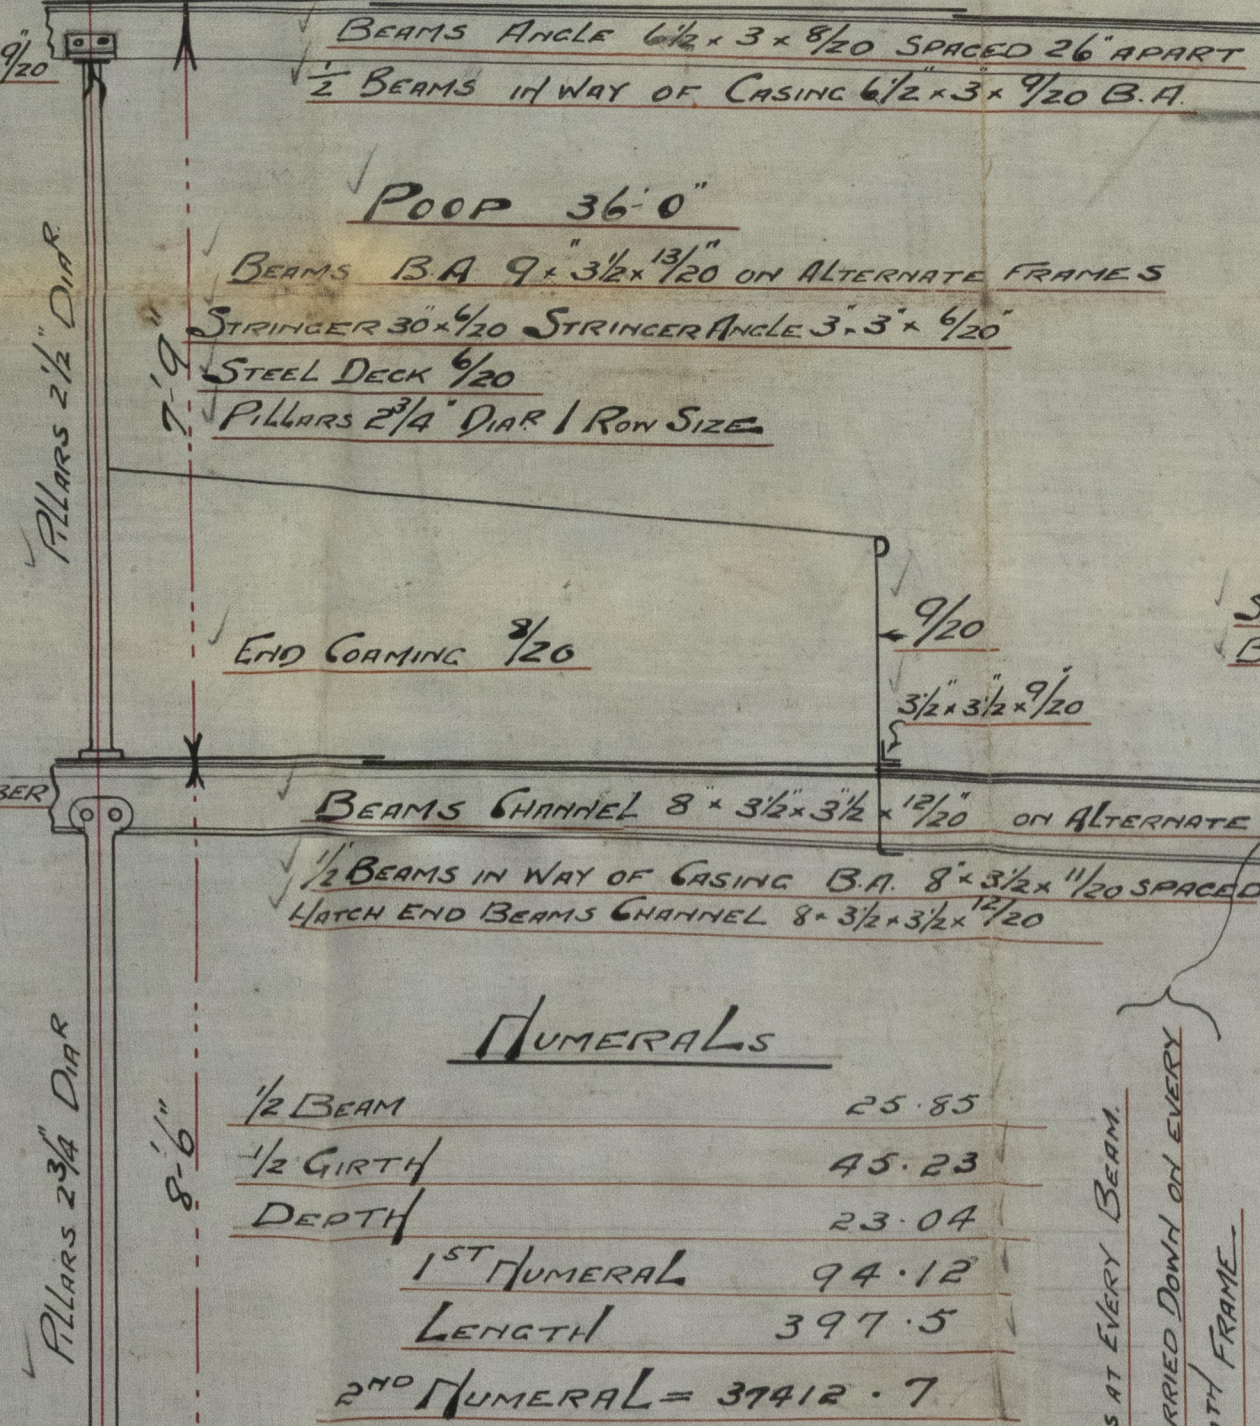

SECTION OF DEEP FRAMING

SCALE 3" = 1'-0"

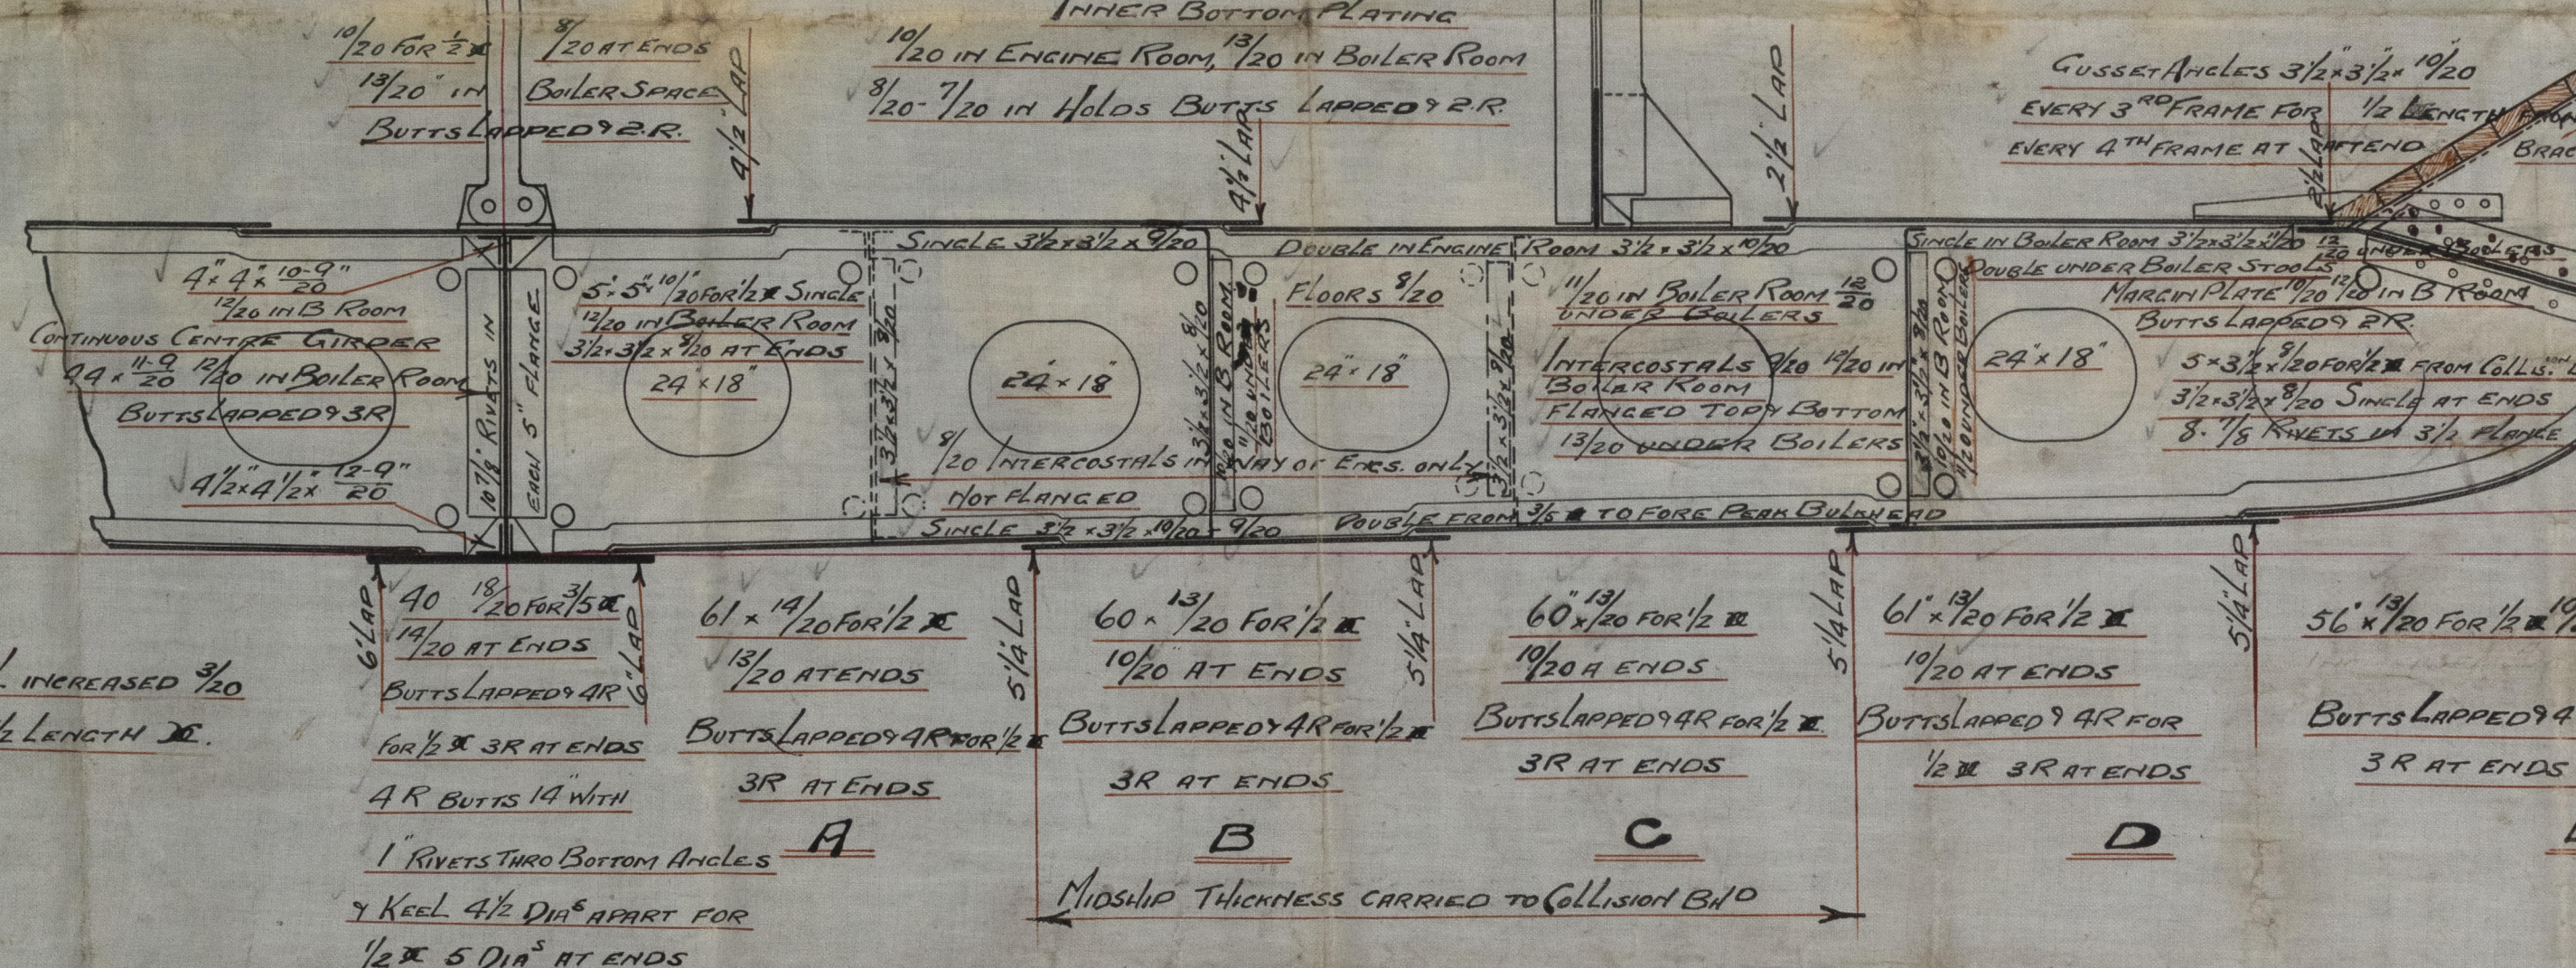

See appended plan of double bottom for Sp. No. 588

Madrik Section

Russell H^{oo} No 5784 ~~588~~

No: 588 appd: 19/9/07

No: 578: —

L.S. Barnockburn

Gr report No 15461.

No 588.

M. Ardgyfe

Greenock Rpt No 15647



© 2021

Lloyd's Register
Foundation

MS90-0213