


S.S. "BERBICE"

MIDSHIP SECTION

SCALE $\frac{1}{4}'' = 1 \text{ FOOT}$

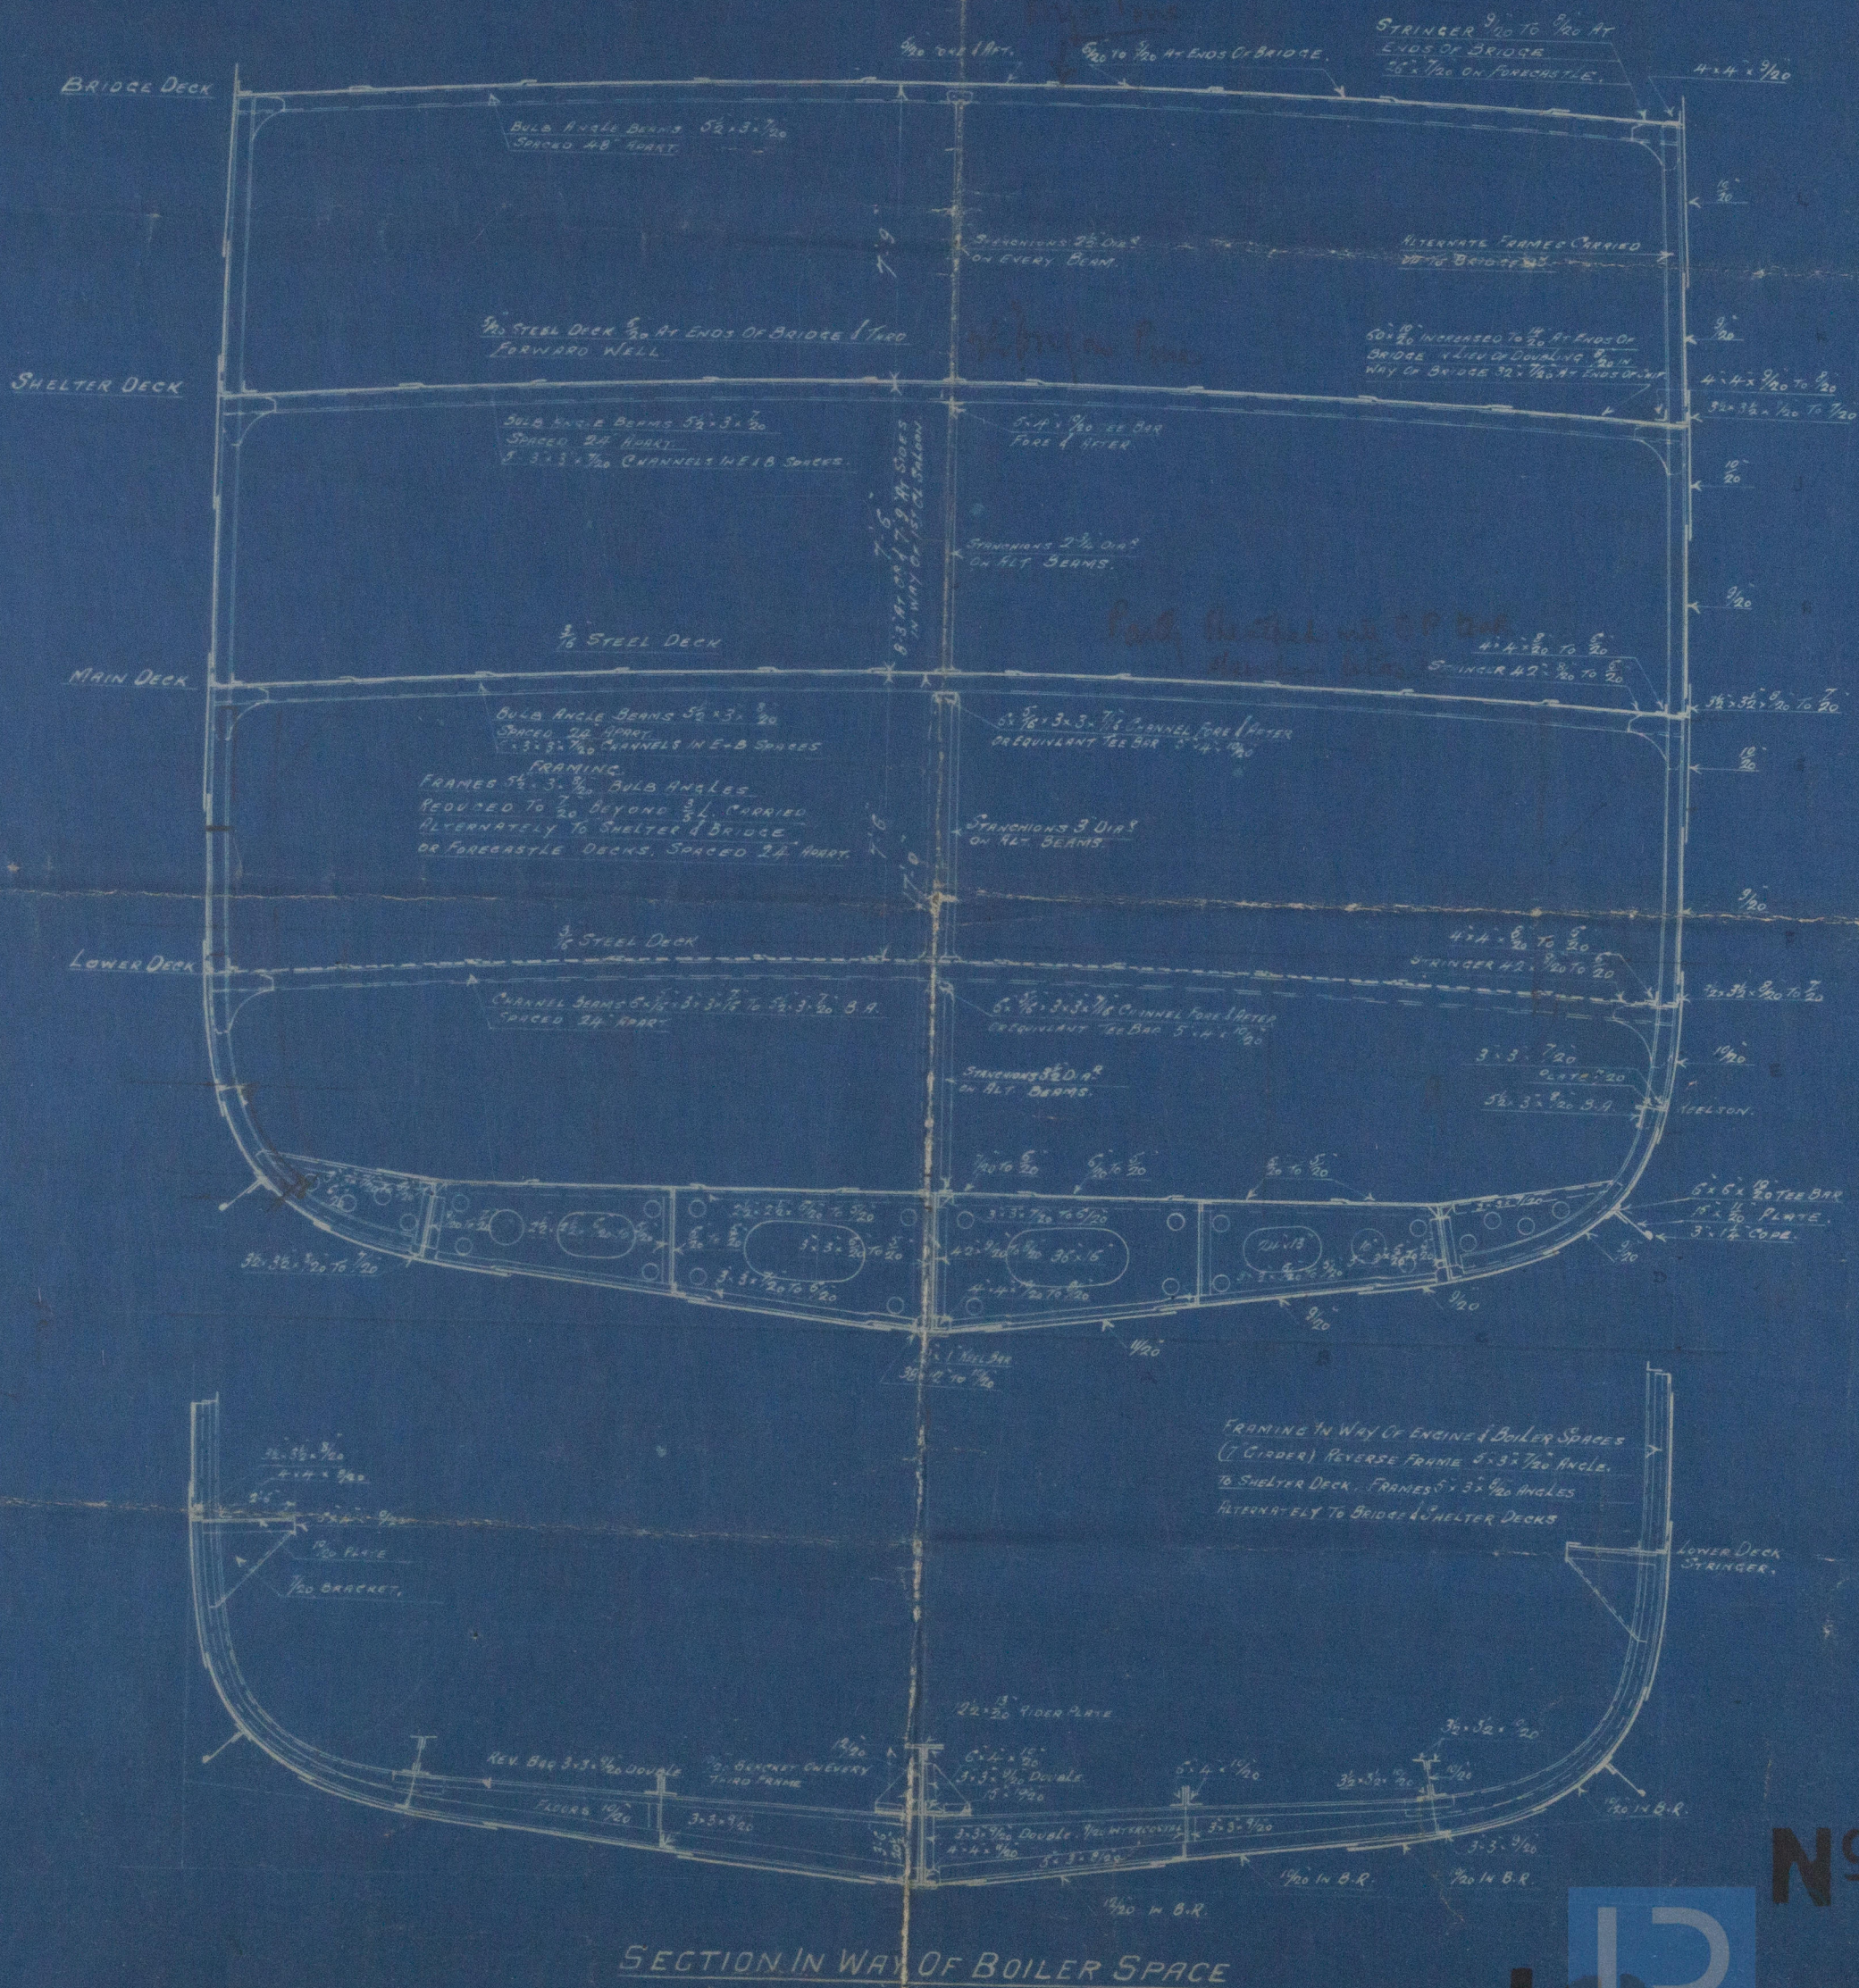

Nº 42



Register Foundation


S. B. [unclear]
[unclear]

(Mid Section)

Baltara


Lon 87545

MIDSHIP SECTION

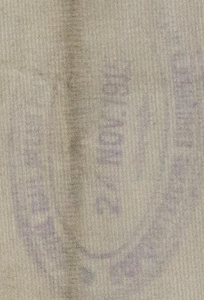

RETAIL

W592-0129

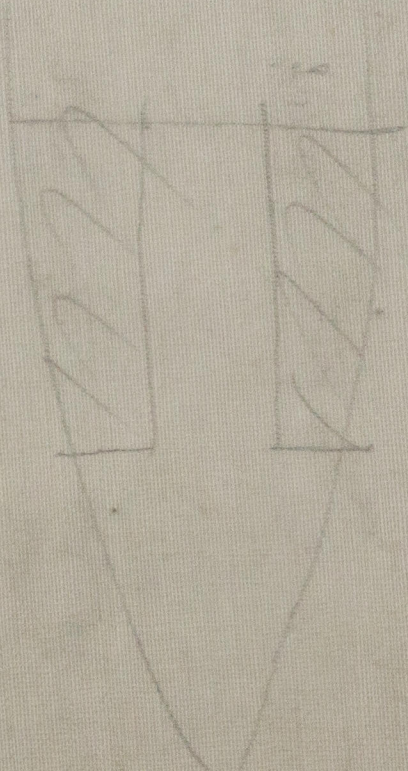

© 2021
Lloyd's Register
Foundation