


Scale $\frac{1}{8}$ ". 1 Foot

26-4-02
1-5-02
10-5-02

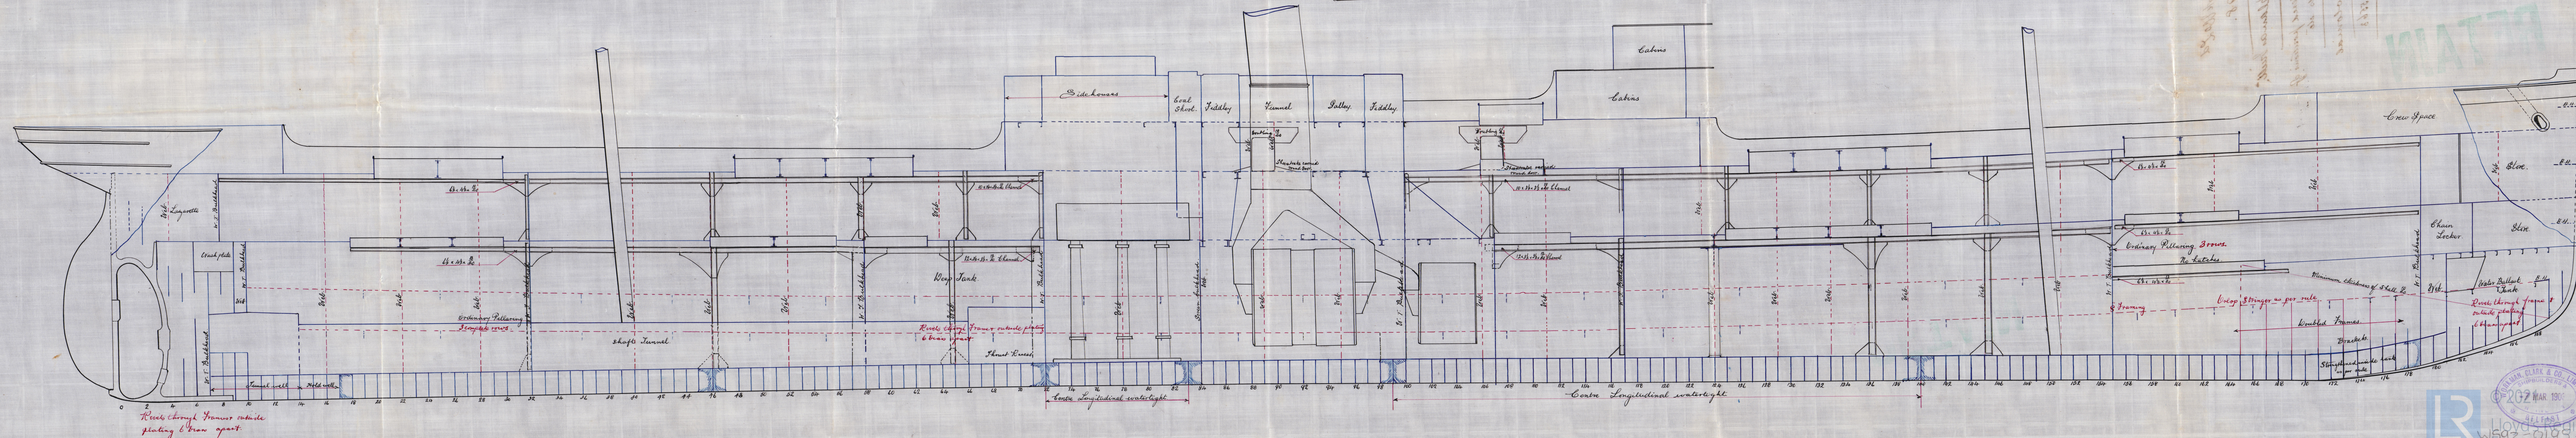

For Enclosure to

Foundation

Messrs. *Lloyd Surveyors*.

WS92-0195½

Workman Clark & Co Ltd

S.S 198.

Profile plan as built.

Showing altered positions of
bulkheads etc

S. S. Colonial

Rel 5563

For Enclosure to

© 2021

W592-0195
Lloyd Register
Foundation