


26.4.02  
 1.5.02  
 10.5.02  
 23.5.02 (199)  
 6.6.02  
 18.6.02  
 25.6.02  
 8.8.02  
 3.11.02

27.1.1901  
 22.2.1901  
 22.2.1901  
 22.2.1901

Longitudinal Elevation of No 198 SS.  
 Scale 1/8" = one ft.

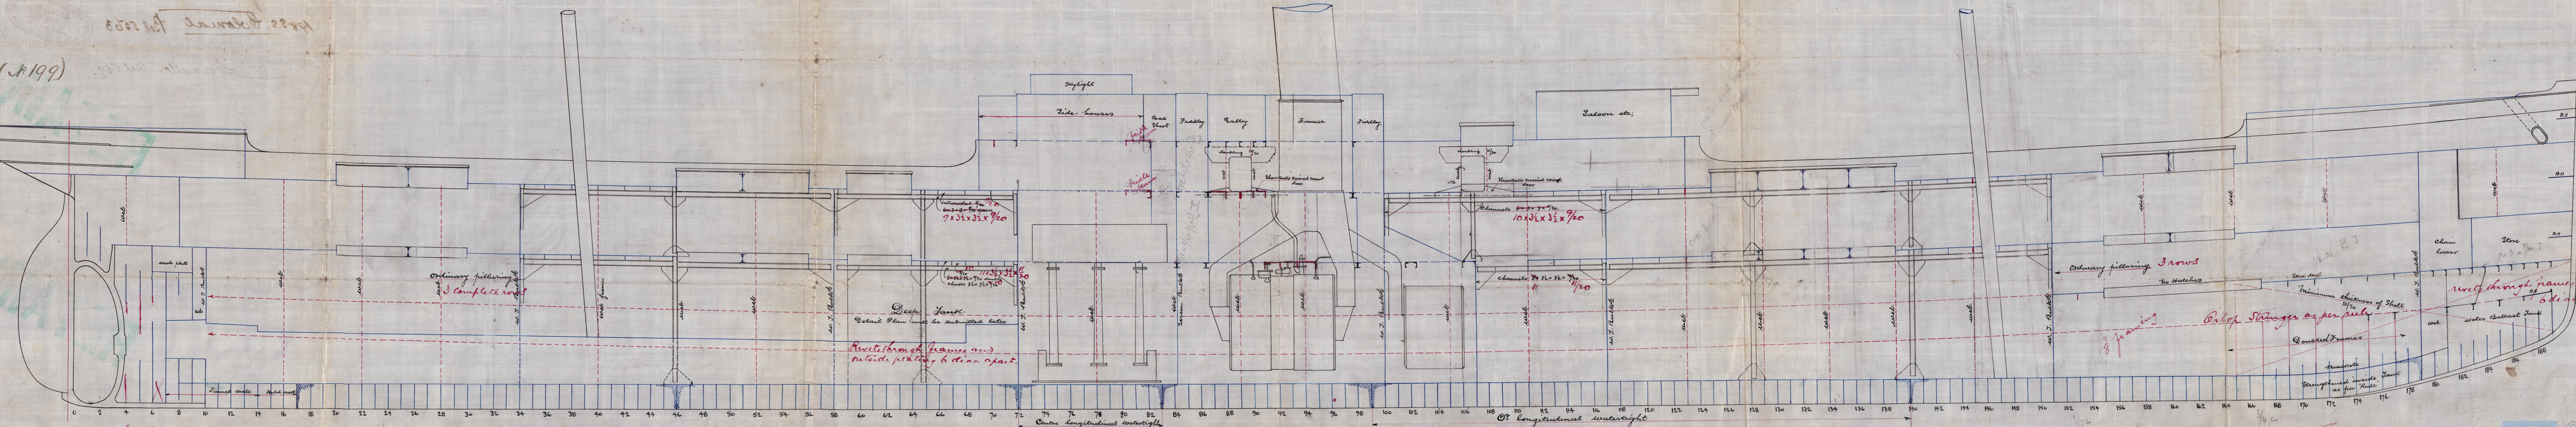

rivets through frames  
 and outside plating  
 6 dia. apart.

Rivets through frames and  
 outside plating, 6 dia. apart.

rivets through frames and  
 outside plating  
 6 dia. apart.

J.D.L.  
 26.  
 1/5/02 1/4/02



Messrs Workman Clark & Co

S.S. 198 + 9

To class 100 A.1. Spar DK.

Profile Plan

198 S.S. Colonial Bel 5063

S.S. "Hounsellor" Bel 5593.

RETAIN

RETAIN



© 2021

Lloyd's Register  
Foundation

W592-0199