


[Faint handwritten notes and a purple circular stamp are visible at the top of the page.]

2502


1-1-1

9/17/18

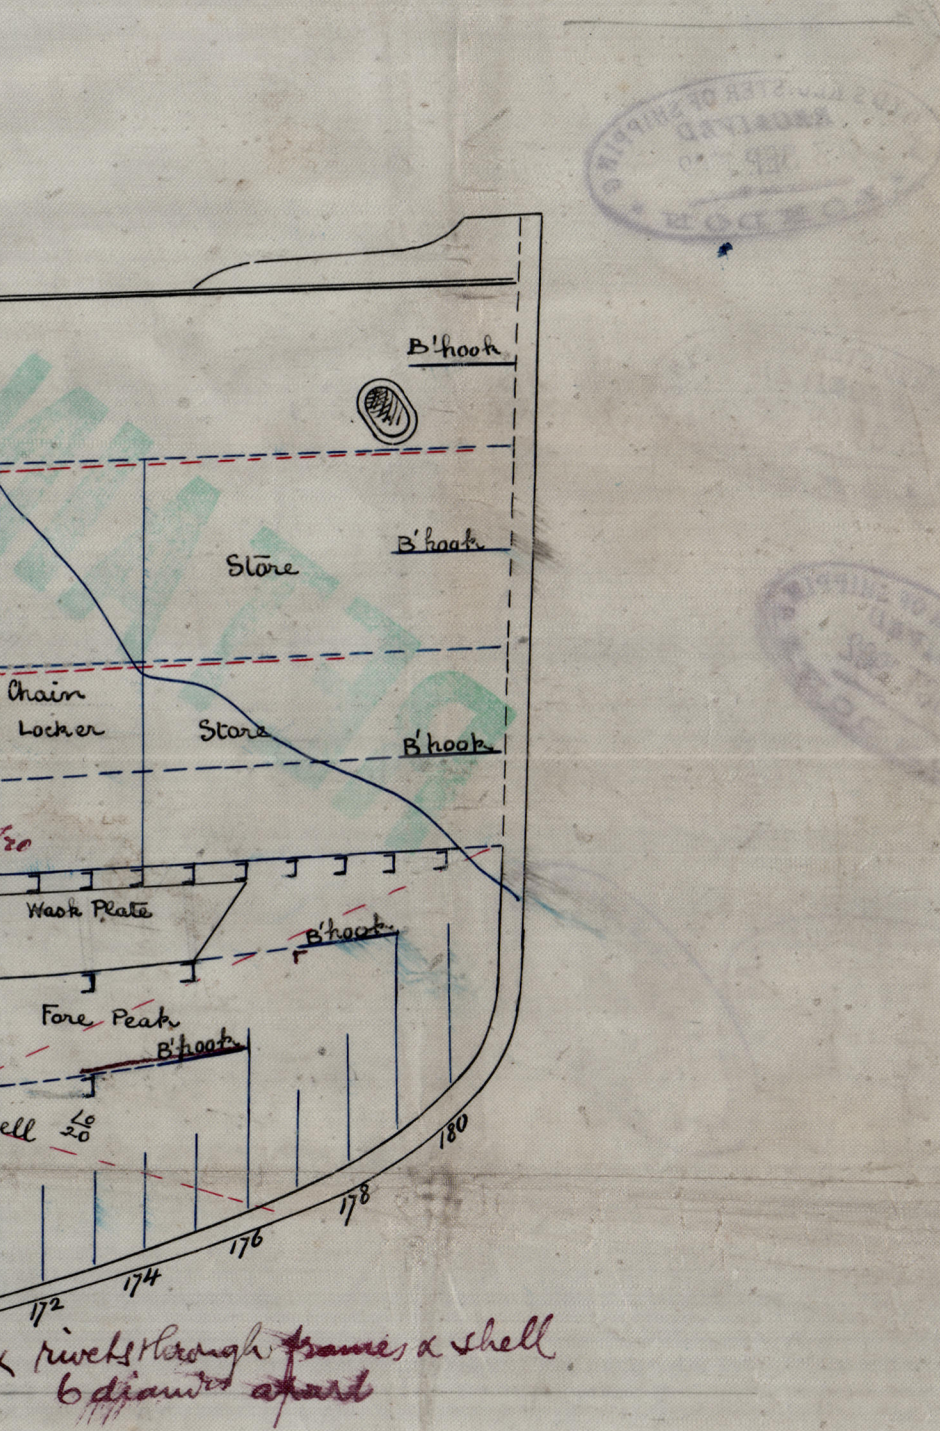

Messrs Workman Clark & Co




SS No 200.
(Star of Ireland)
Profile Plan

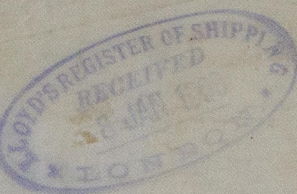

Ref. 5628.

To Class 100 A. 1.

Messrs J. P. Corry & Co.

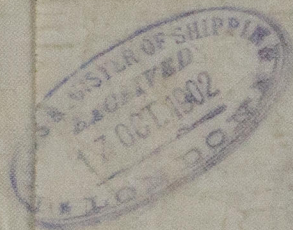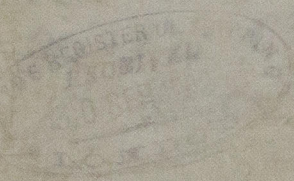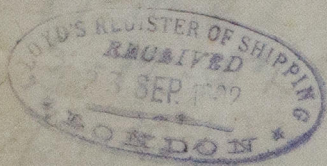




© 2020

Lloyd's Register
Foundation