

13/8/29


Nº 570

PROFILE & DECKS.

CLASS 100 A1 LLOYDS

SCALE 1/8" = 1 FOOT

POORBOARD PARTICULARS			
LENGTH 37	306.0	SHEER FORWARD	7.8
LENGTH ON LOAD LINE	308.8	SHEER BL FROM FORWARD	4.3
BREADTH EXTREME	44.0	SHEER AFT	3.5
BREADTH MOULDED	43.0	SHEER BL FROM AFT	1.10 1/2
DEPTH MOULDED TO UPPER DECK	21.6	RAISED QUARTER DECK	176.8.4.9
APPROX UNDER DECK TONNAGE	211.6 TON	FORECASTLE	34.4.7.3
DISPLACEMENT COEFFICIENT	.770	DEPTH OF HOLD	19.4 1/2
NO CEILING	NO CAISSO BATTEN	RAISED QUARTER DECK TYPE	DEEP BULB ANGLE FRAME

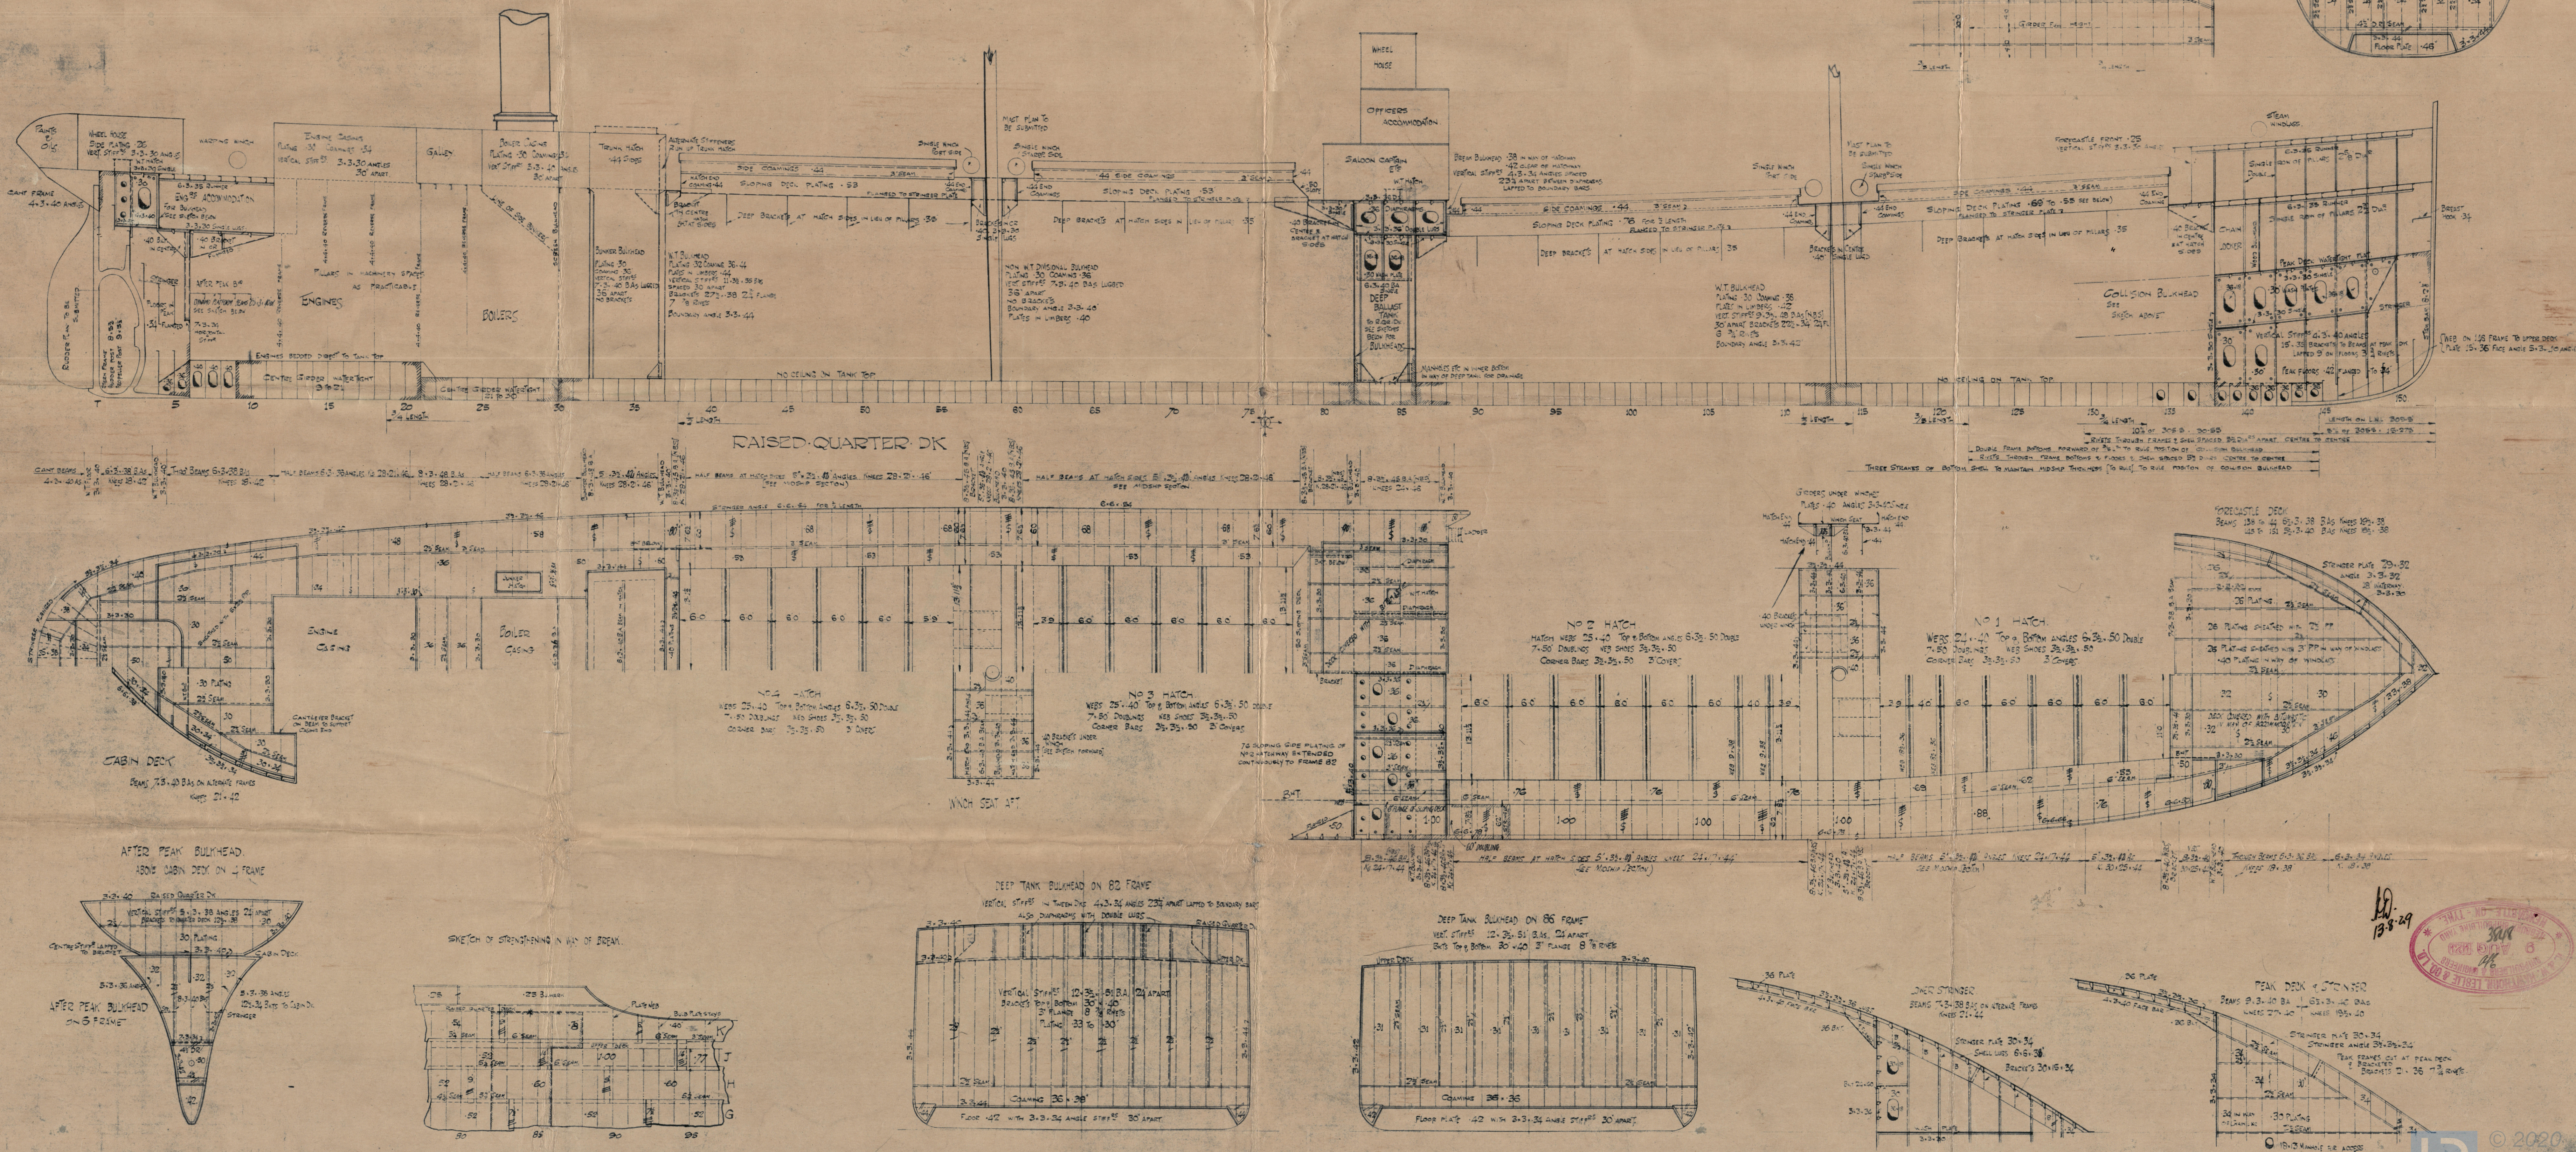

11.5
75
920
805
10. 8970/10
78 12 9
88 939
88 59



© 2020

Lloyd's Register
Foundation

2

Hawthorn Leslies

570

Prople rock Plans

S. S. "KIRK WOOD".

NEWCASTLE ON TYNE.

Report No. 85288.

RETAIN



© 2020

Lloyd's Register
W593-0137
Foundation