

OIL CARRYING STEAMER

MIDSHIP SECTION

SCALE 1:25

DIMENSIONS


LENGTH F.T. 401.90
BREADTH 54.80
DEPTH 31.33
TRANSVERSE NUMBER B+D = 86.13
LONGITUDINAL NUMBER Lx(B+D) = 34616

CLASS 100 A1 "CARRYING PETROLEUM IN BULK"

UNDER DECK TONNAGE ABOUT TONS. 5400

EQUIPMENT

EQUIPMENT NUMBER	LESS THAN 37600
1 BOWER ANCHOR	CWTS. 63 3/4 STOCKLESS
1 " "	" 63 3/4
1 " "	" 54 1/2
1 STREAM " EX STOCK	" 17 1/2
1 KEDGE " "	" 7 1/2
STUD-CHAIN CABLES, 2 5/16 INCHES	LENGTH 270 FMS.
STREAM STEEL WIRE, 4 3/4 "	" 90 "
TOW-LINE STEEL WIRE, 5 "	" 120 "
HAWKERS AND WARPS	
N. 2 of 8"	" 90 "
N. 2 of 7"	" "

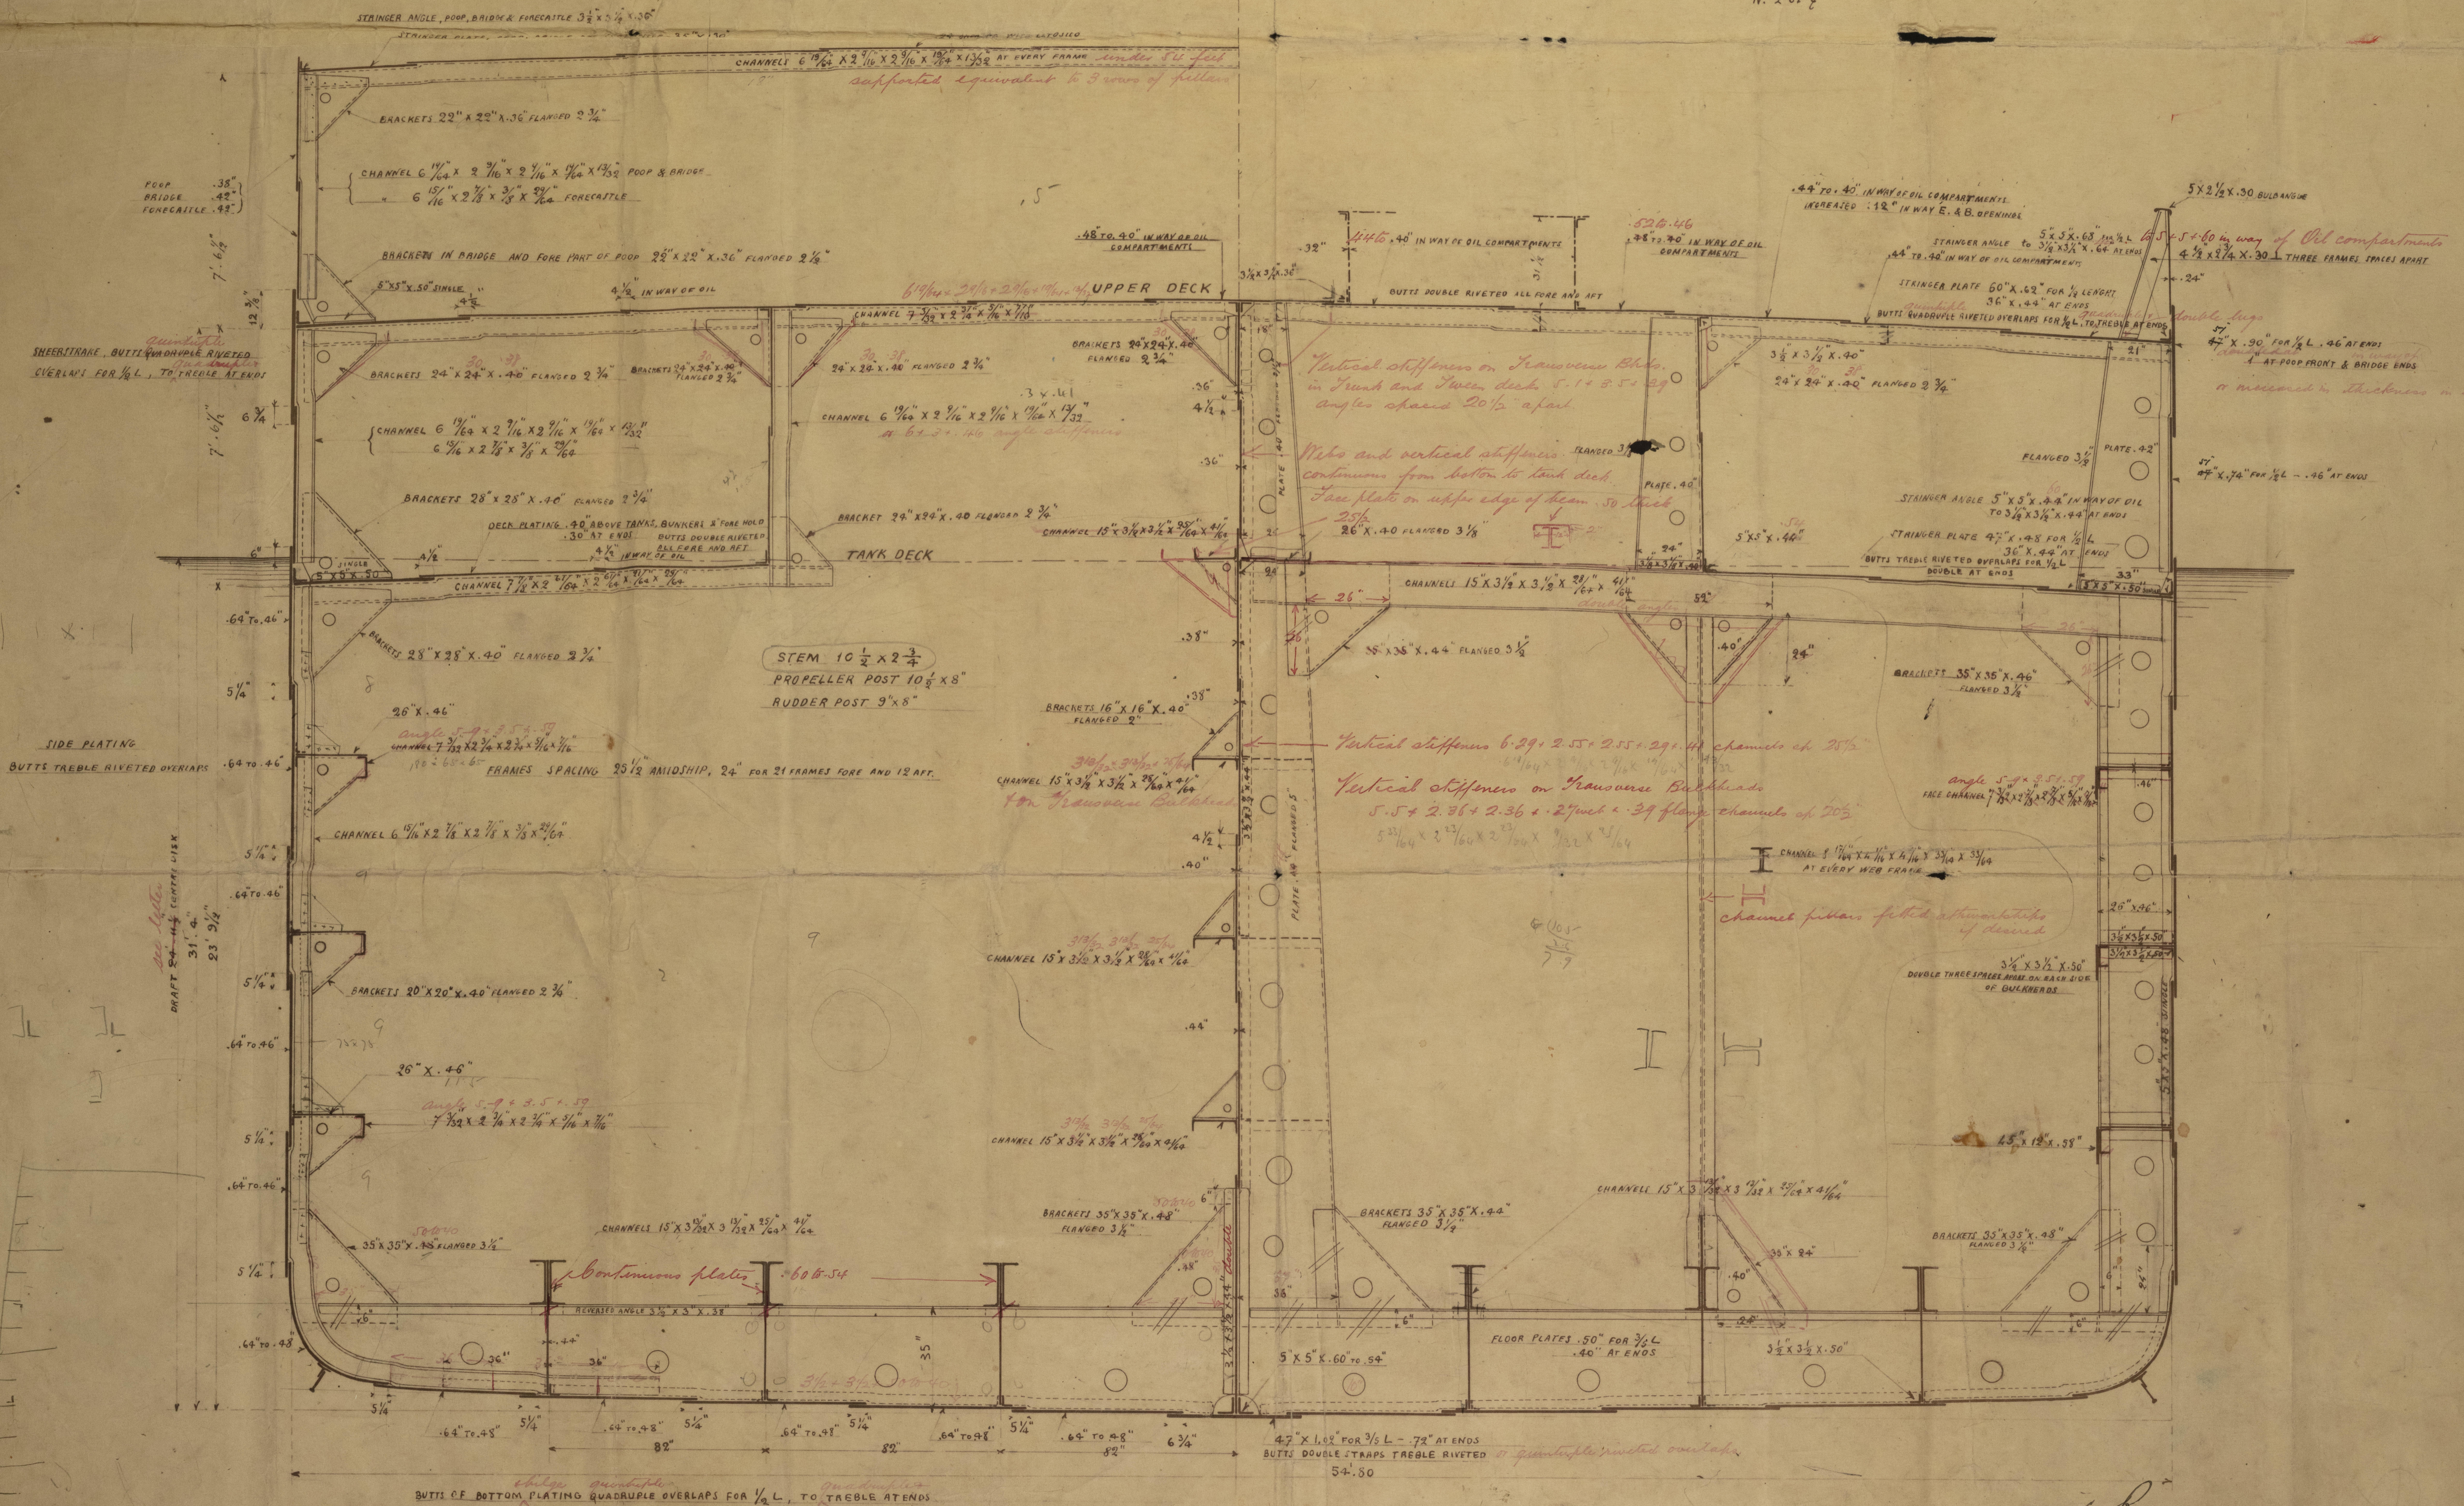

C.B.
22.4.12


(1)

APPROVED MIDSHIP SEC.

N^o 816 & 817


ODEROS. OIL STEAMERS

S.S. 'Splendor'
+ Lampo - Pen. 5734
Gen 5847

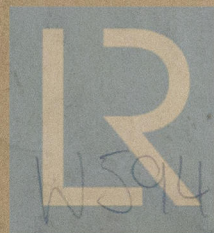

© 2020

Lloyd's Register
Foundation

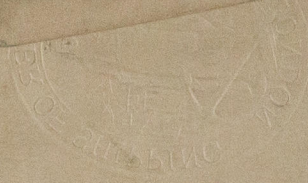

© 2020

Lloyd's Register
Foundation