

CANTIERE NAVALE-OFFICINA MECCANICA FONDERIA
 N. ODERO & C.
 Disegno N. 19923 Data 25 Maggio 1912
 GENOVA (Pace)

Dimensions

Length	D.C.	90
Width		80
Depth		31, 55
Transverse Diameter B+D		86, 15
Longitudinal Diameter L x (B+D)		34610

Class 100 A1. ♣ "Carrying Petroleum in Bulk."

Under Deck Passage about Tons 5400

Oil Carrying Steamer

Scale 1:100


N^{os} 216 & 217.

Longitudinal Section


C. J.
8/6/12

Ratcliffe Steamers
No 216 + 217
H. Odgers & Co. Ltd -
- Profile -

REMAIN

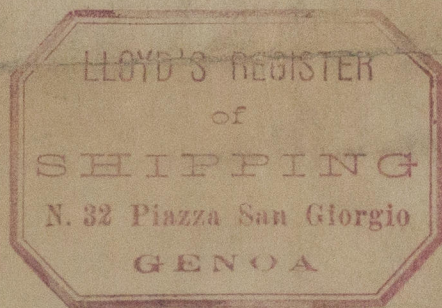


REMAIN

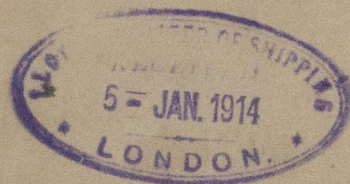

See 5734 + 5547
St. Stephen & Dante

(2)

Profile

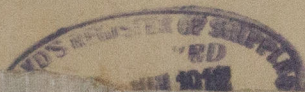

© 2020

Lloyd's Register
Foundation