

12.5.04  
21.6.04  
10.8.04


NUMERALS	
1/2 BREADTH	= 12.5
1/2 GIRTH	= 22.73
DEPTH	= 12.13
1ST NO	= 47.41
LENGTH	= 133.95
2ND NO	= 6537.61

# SS. N° 70. MIDSHIP SECTION. OF A STEEL SCREW STEAMER.

DIMS. 140-0 x 25-0 x 11-8.  
TO CLASS 100 A.I. LLOYDS.  
SCALE  $\frac{1}{2}$  = 1 FT.

EQUIPMENT NO = 6991.35  
RQDZ(4375 x 2.0) + BRIDGE 1.5(10 x 7) + F.C.L.E. 1.5(16.5 x 5) + 6537.6 = 6991.35


1 BOWER	8	1/2 CWT'S STOCKLESS
1 STREAM	2 3/4	EX STOCK
1 KEDGE	1	15
155 FATHOMS	2 1/4	STUD CHAIN
45	2 1/4	STEEL WIRE
75	5	"
90	5	HAWSER.

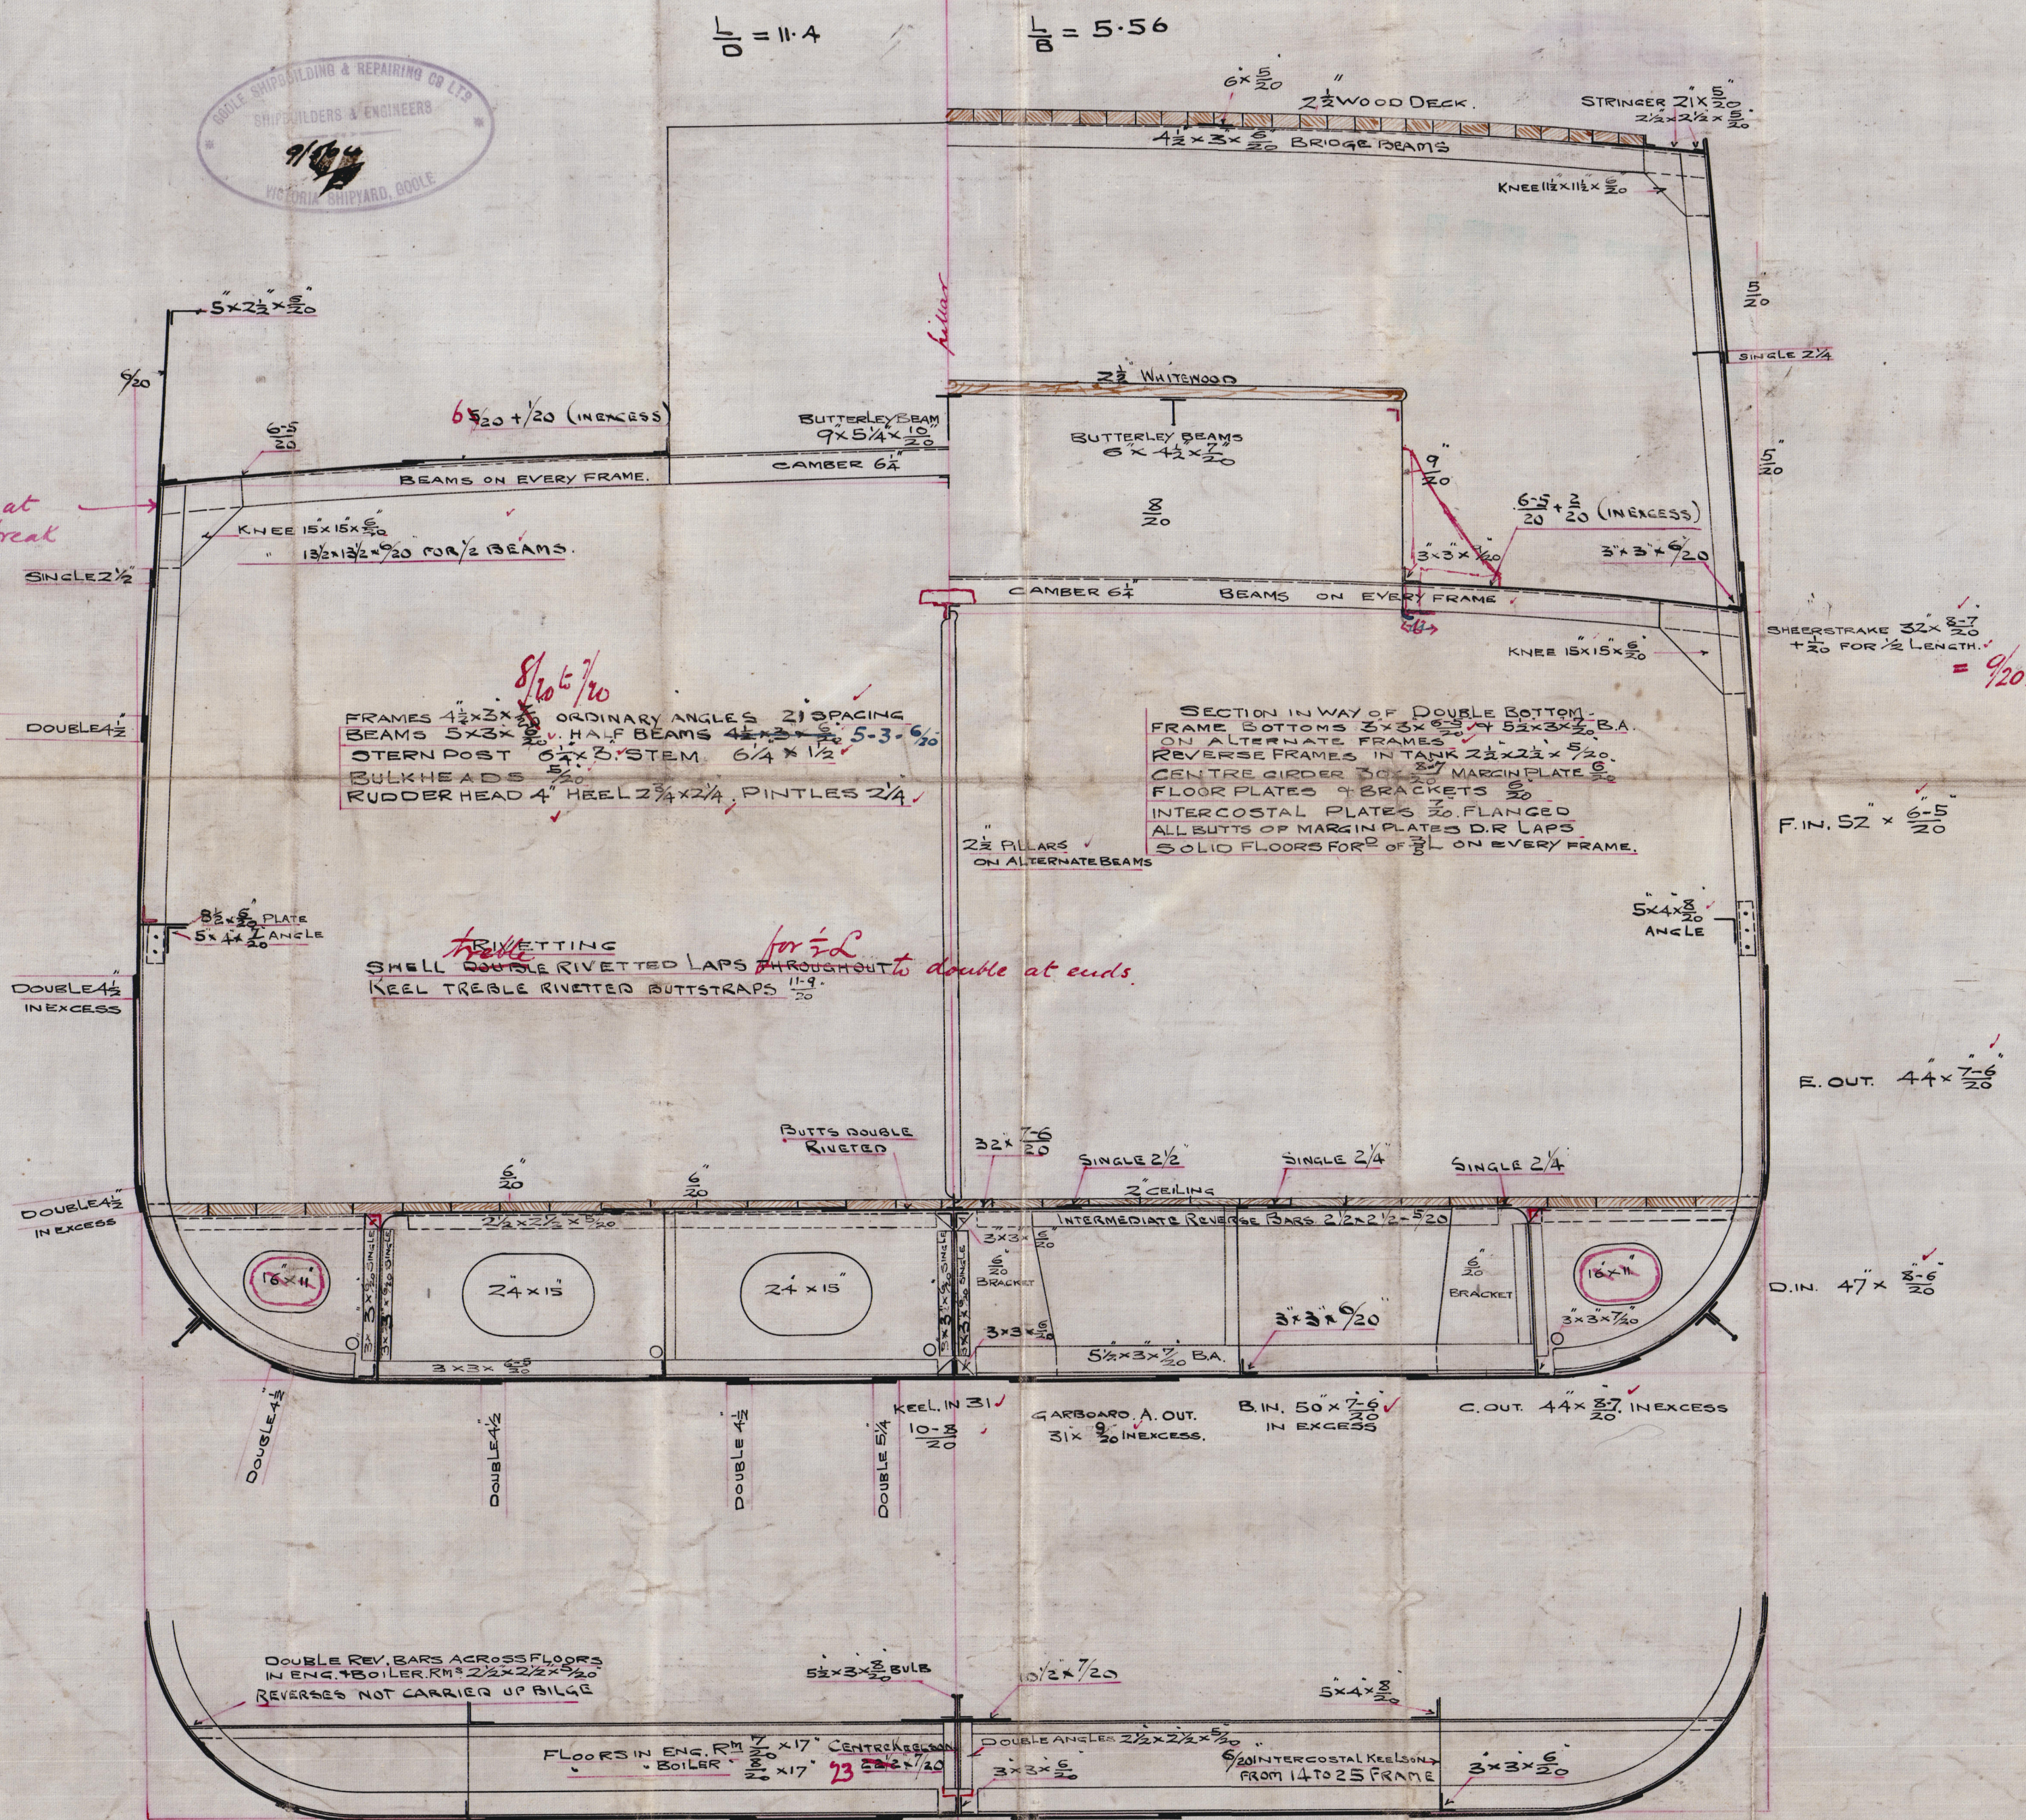

12.5.04.




*Wm Vechin*  
*Goole S & A Co.*  
*- No 70 -*

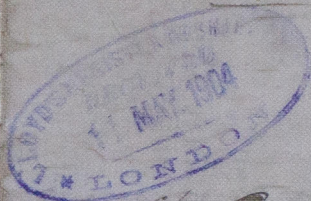

*Grace*



*Hull Report No 16430*

 

© 2021

WS 96 - 00 87

Lloyd's Register  
Foundation