


12.5.04
31.6.04



S.S. N^o 70.
PROFILE & DECK PLAN

DIMS. 140'0" x 25'0" x 11'8"
SCALE 1" = 1'0"

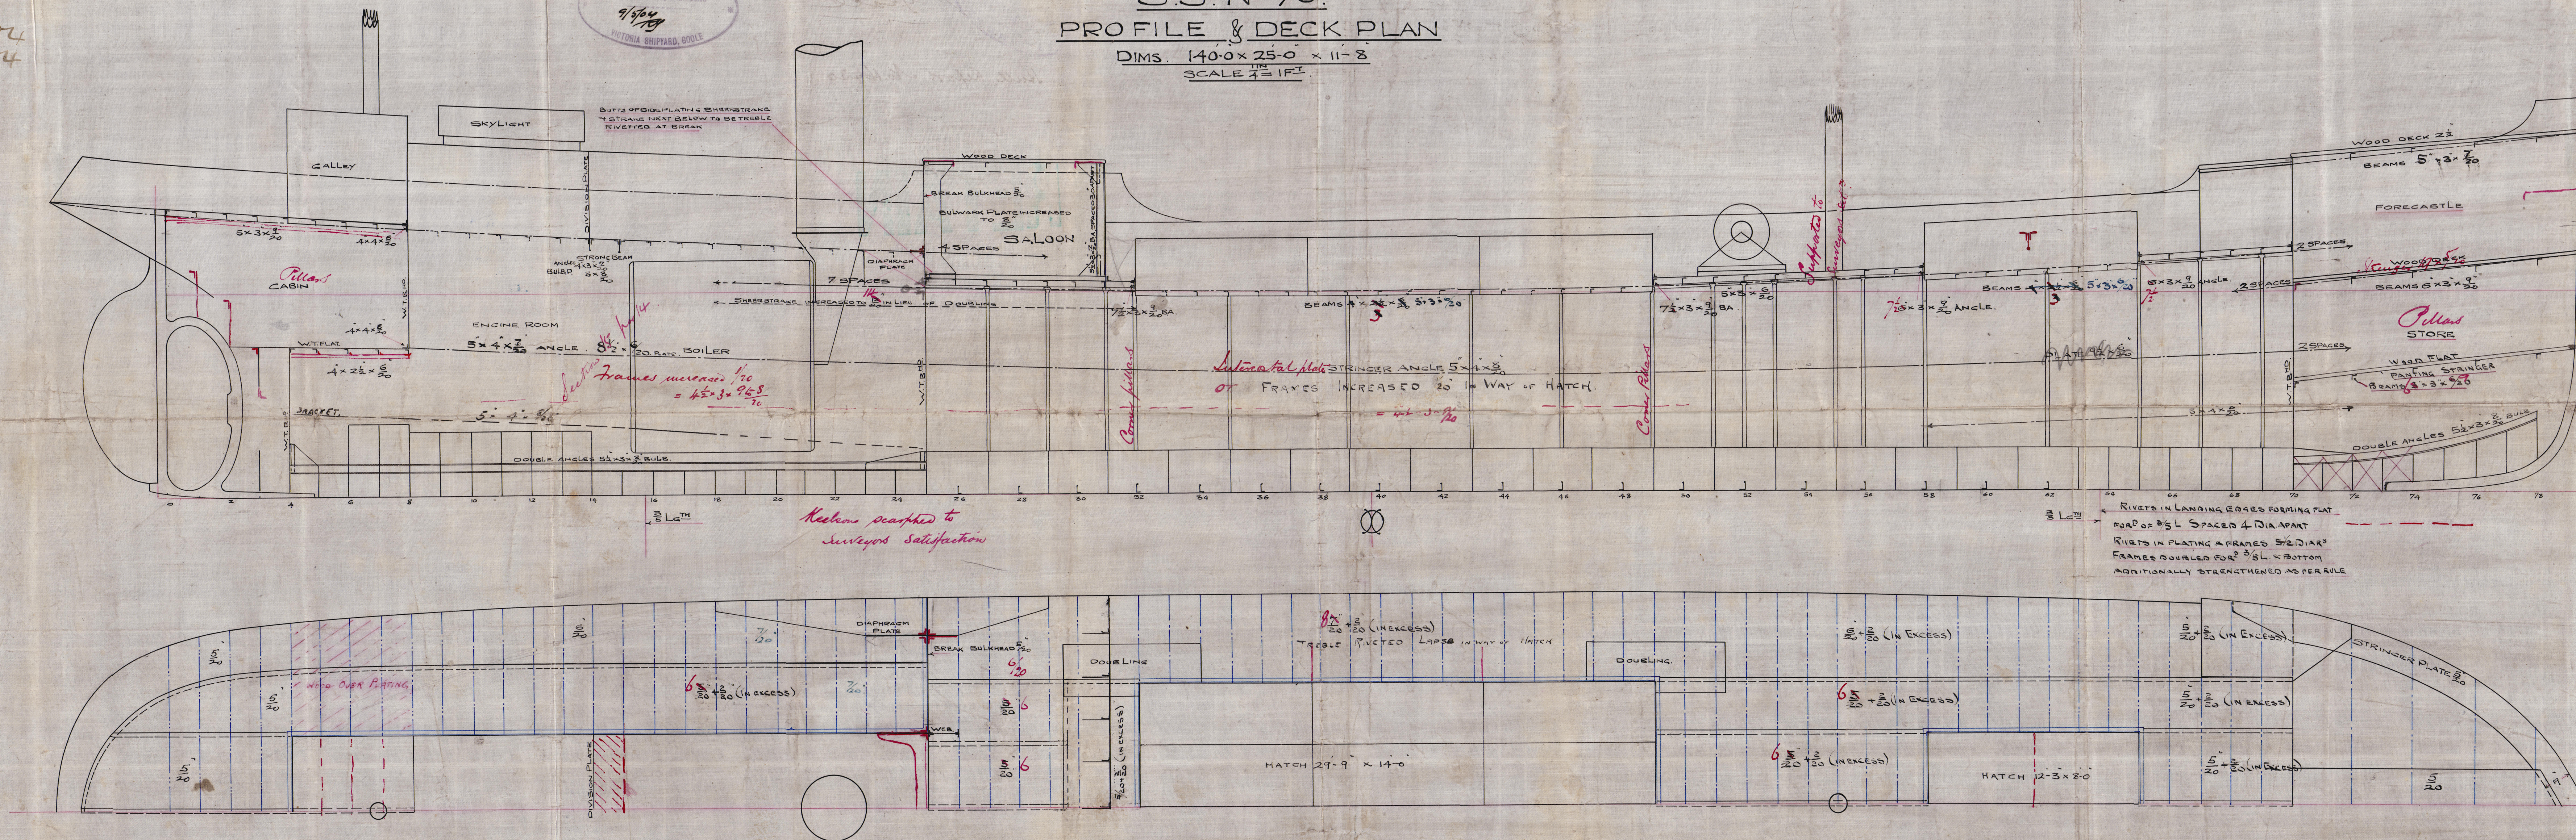

LLOYD'S REGISTER
OF SHIPPING
10 MAY 1904
* HULL *

C.B.
12.5.04.

Proble.

Goole S & R Co

- No. 70 -

Grace

Hull Report No. 16430



© 2021

W596-0088 Lloyd's Register
Foundation