



31-10-09

# PROFILE. S.S. No 267.

LENGTH B.P.	94'0
BREADTH MOULDED	22'0
DEPTH MOULDED M <sup>d</sup> D <sup>s</sup>	9'6
DEPTH OF HOLD	8'10 1/4
LOAD DRAFT	8'6
FREEBOARD MAIN DECK	1'0


SCALE 1/4" = ONE FOOT.

CLASS 100 A.I. LLOYDS RAISED QUARTER DECK RULE.

ALL SCANTLING TAKEN FROM 1908 & 1909 RULES.

## STRENGTHENING AT BREAK OF RAISED QUARTER DECK


SHEERSTRAKE DOUBLED FOR LENGTH OF 11'0" AS INDICATED  
MAIN DECK PLATING TO SCARP ONE FRAME SPACE  
MAIN DECK STRINGER PLATE TO EXTEND 5'0" FRAME SPACES ABAFT BREAK BULKHEAD  
BREAK BULKHEAD 3/20" DIAPHRAGM PLATES 9/20" THICK  
FITTED BETWEEN MAIN 4 R<sup>d</sup> Q<sup>r</sup> D<sup>s</sup> SUPPORTED ON BEAMS  
WITH PILLARS TO CENTRE KEELSON

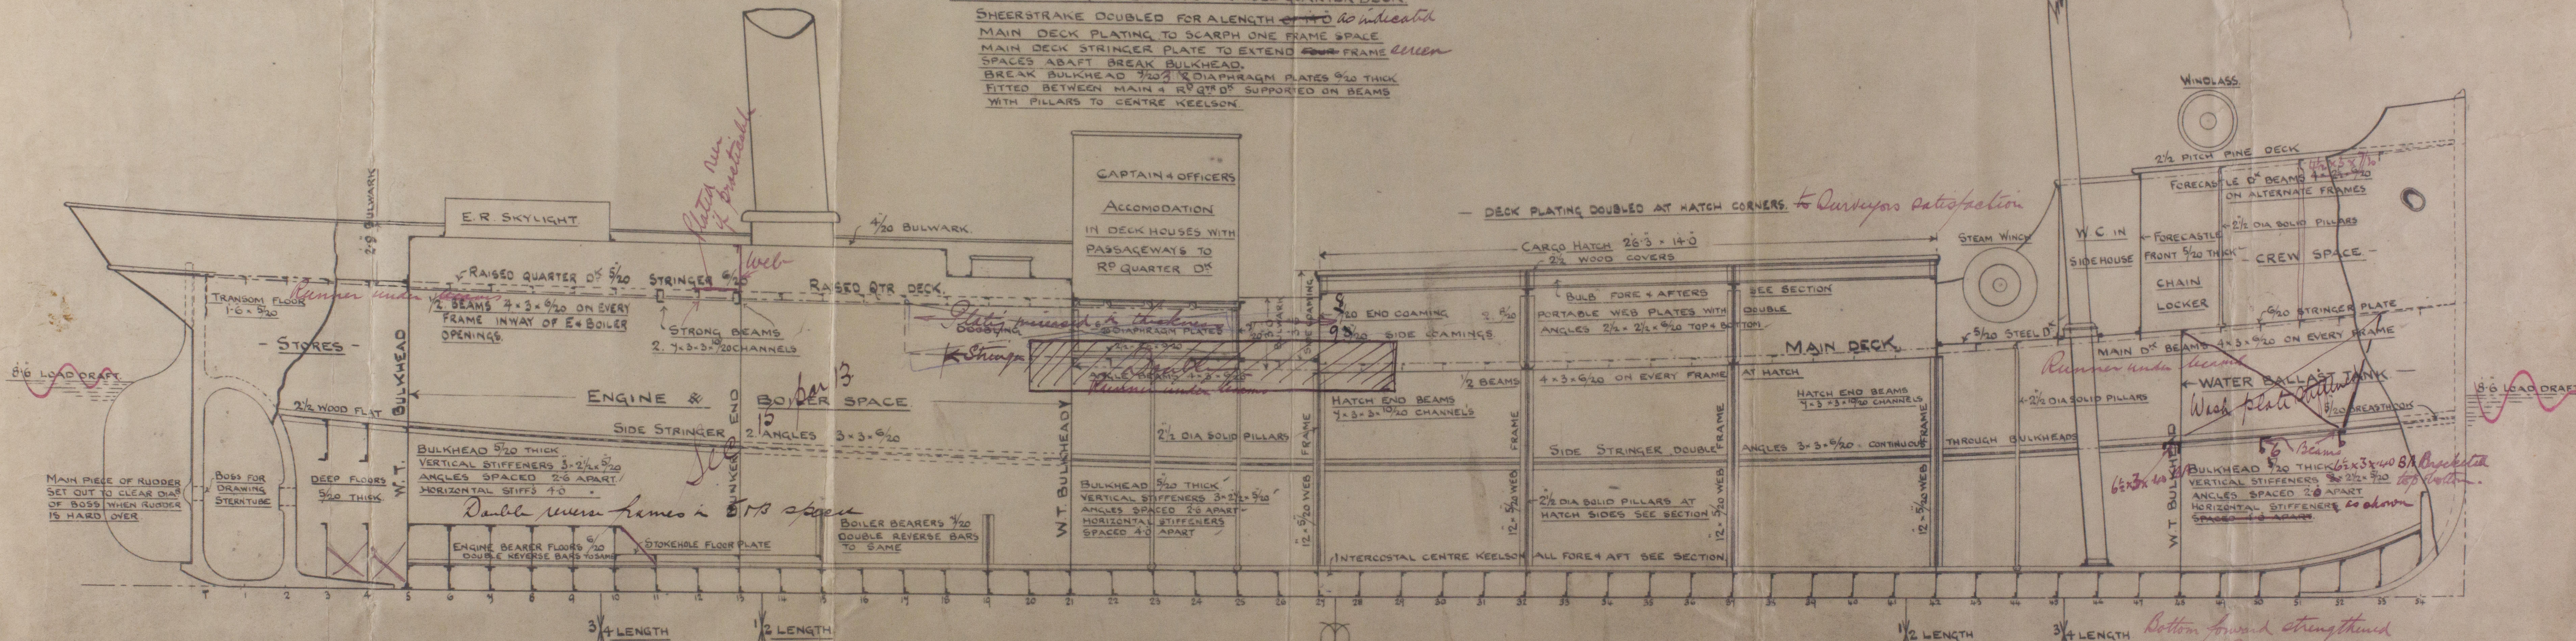

ANGLE FRAMES 3 x 2 1/2 x 5/20 SPACED 1'9" APART ALL FORE & AFT.  
REVERSE FRAMES 2 1/2 x 2 1/2 x 5/20 RUN TO MAIN & RAISED QTR DECKS AS PER SECTION.

Pillars throughout to Surveyor's satisfaction

Bottom forward strengthened as per Rule if required.

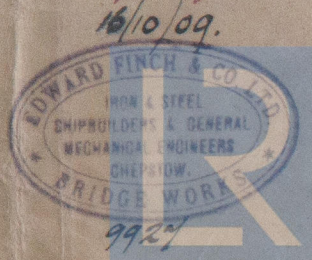

C.F.  
21/10/09



E. Finch 1865  
S.S. no. 267.

Profiles.

\*The Forester

RETAIL



© 2020

Lloyd's Register  
Foundation

W598-0021