

9.7.29

— PROFILE & DECK PLANS —

OF A

SINGLE DECK FULL SCANTLING SCREW STEAMER

LENGTH L.W.L 315'6" BREADTH MLD 45'0" DEPTH MLD 23'10"


CLASS 100A. LLOYDS

SCALE 1" = 1'00"

Wireless masts & steering gear
supported to Surveyor satisfaction

TWEEN DECK FRAMES 5" x 3 1/2" x 44" ANG ONE EVERY FRAME (SCARPHED TO MAIN FRAME)
4 FRAMES AT ENDS OF BRIDGE 5 1/2" x 3 1/2" x 36" B.A. ANG.

COLLISION BULKHEAD
FLOOR PLATE 45" VERTICAL PLATING 35" x 30"
TOP STIFFENERS 5" x 3 1/2" x 40" ANG (24" APART)
BOTTOM STIFFENERS 5" x 3 1/2" x 40" ANG (24" APART)
KNEES 2 1/2" x 3 1/2" x 40" (24" APART) 7" x 3" x 40" RIVETS
BND STIFFERS LUGGED TO TRANSVERSE PLATES
BOUNDARY BARS 3" x 3" x 45'7"

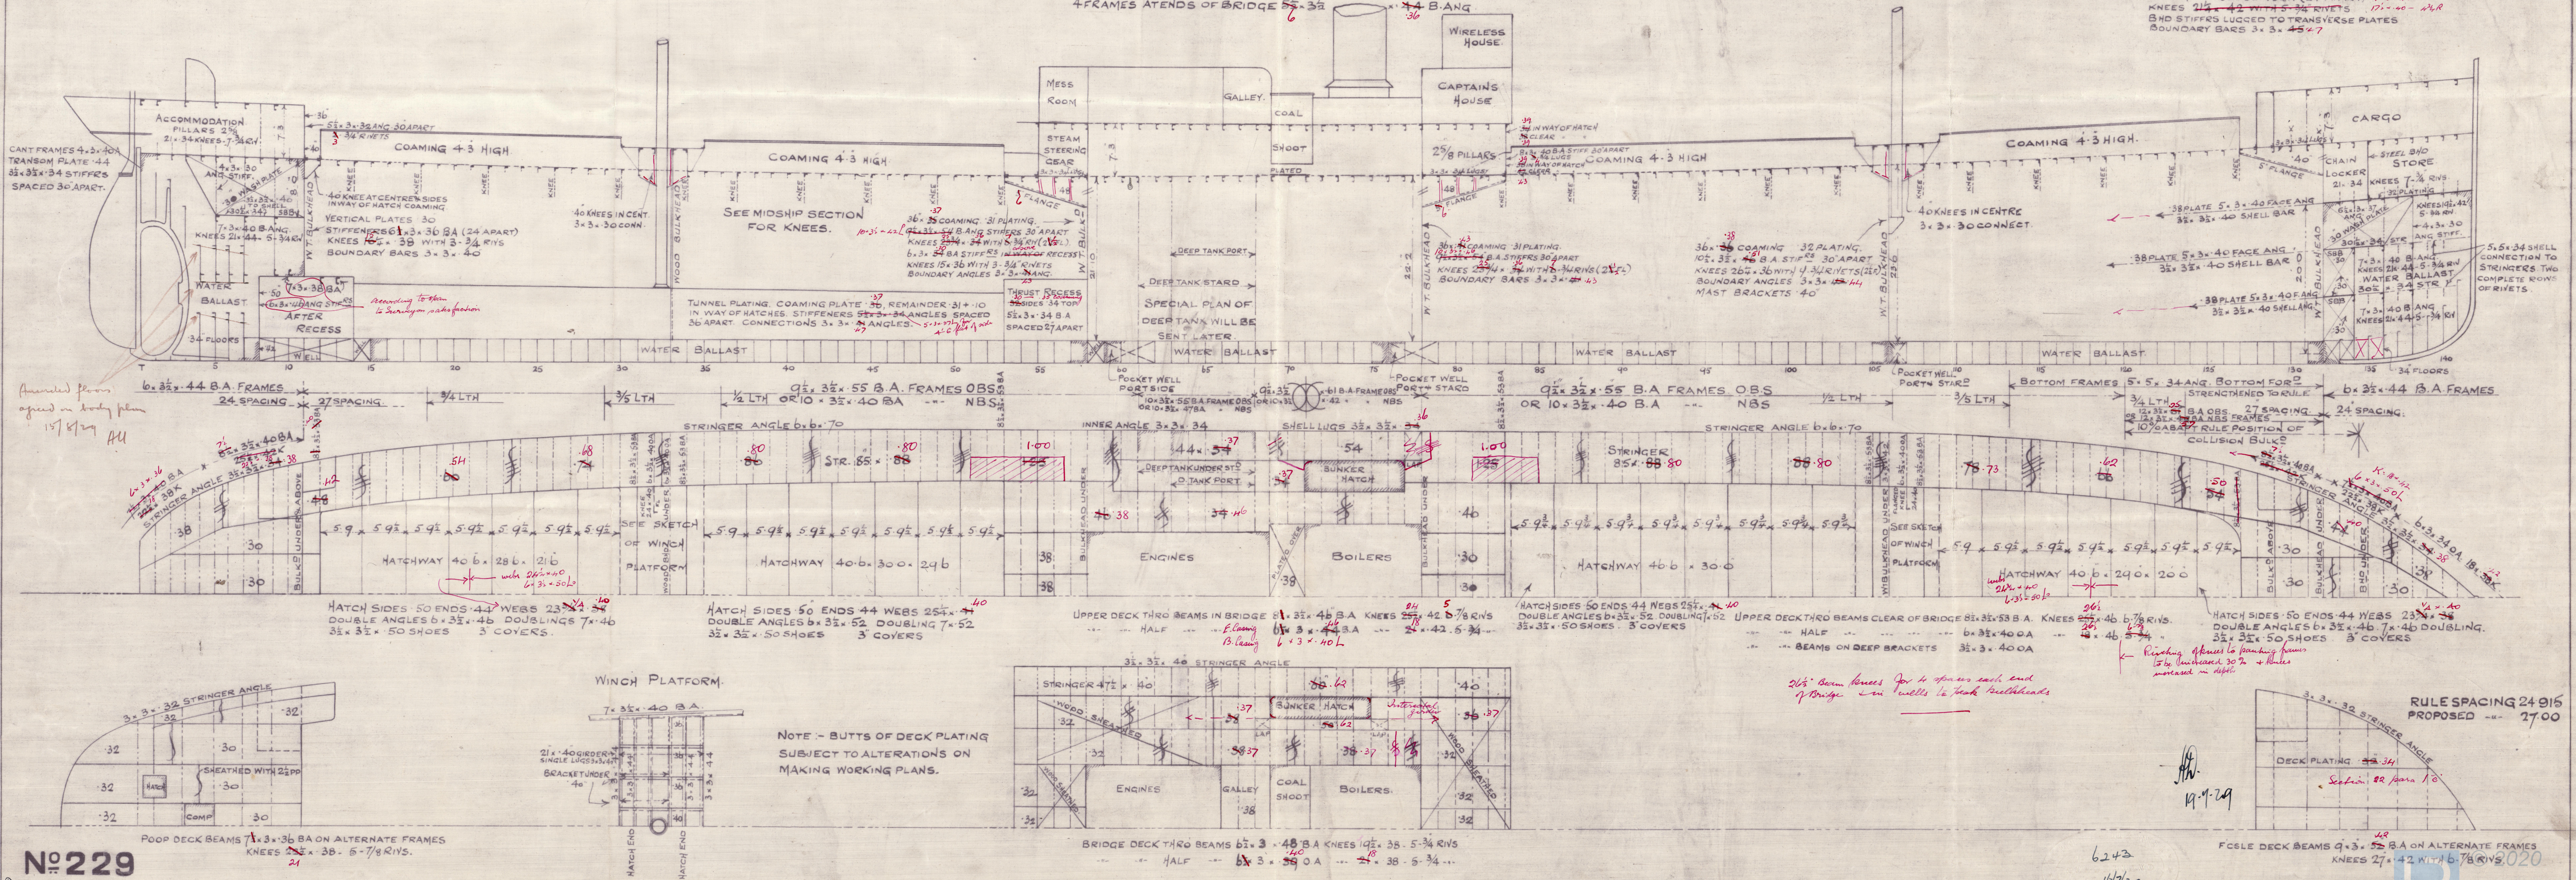

No 229

6242
16/7/29

(2.)

SUNDERLAND

MESS^{RS} W.M. PICKERSGILL & SONS LD.


S/S. 229

PROFILE & DECKS

S.S. ament.

SUNDERLAND RPT. NO. 30265.

RETAIN

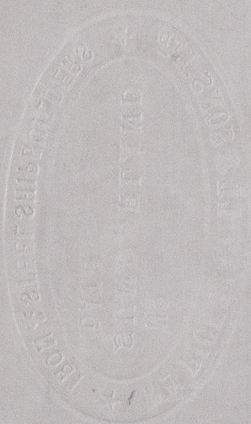

© 2020

Lloyd's Register
Foundation

W598-0146