

—NOTE—

— SKETCH SHOWING REPAIRS TO RUDDER  
EFFECTED IN NEW YORK, DECEMBER, 1915. —

— "S.S. CACIQUE." —  
— RUDDER. —


Union Iron Works Co.  
ISSUED  
OCT 4 1915  
SAN FRANCISCO, CALIF.



© 2020  
Lloyd's Register  
Foundation


W598-0271



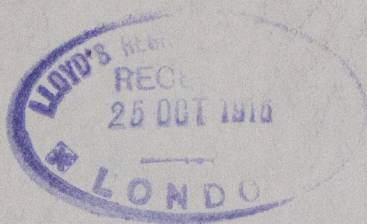

Repair to main piece  
of Rudder.

Steer S. S. "Cacique" 77

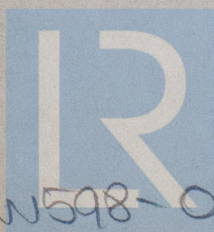

© 2020

Lloyd's Register  
Foundation

W598-02H