


1.7.09  
20.7.09  
18.7.09  
6.8.09  
4.9.09  
9.12.09

PROFILE AND DECK PLAN  
SS N<sup>o</sup> 358  
393-6.52-0-29-1/2 DM<sup>10</sup>  
SCALE 1/8" = 1 FOOT

NOTE: SPECIAL PLAN WILL BE SUBMITTED OF 8" PILLARS  
BELOW MAIN DECK. ALL PILLARS INCREASED 10%  
BEYOND APPROVED PLAN. (SPECIFICATION)

 

CT  
1/11/09



Profile

&

Decks

No 358









Messrs Short Bros. & Co.

S.S. "LACIQUE"

Report No 24344.



RETAIR

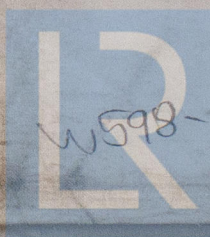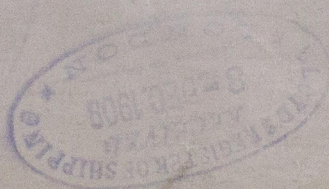 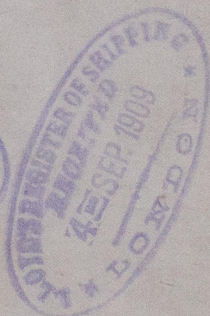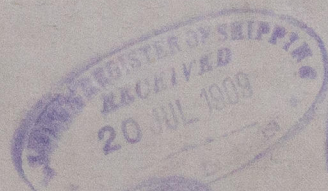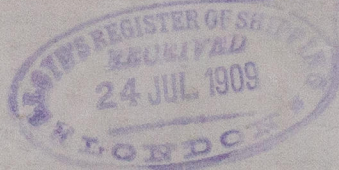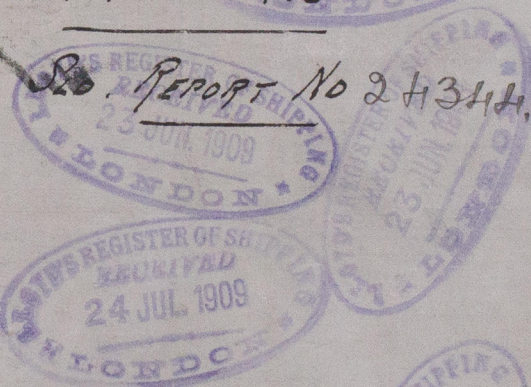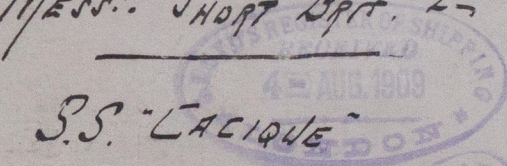

© 2020

W598-0288

Lloyd's Register  
Foundation