

## SINGLE ENDED STEEL BOILER

## SCALE 1 TO THE FOOT

WORKING PRESS 200 LBS

TEST " 400 LBS

PR. CENTAGE OF	BOARD OF TRADE
PLATE	57 407
RIVET	56 191

PERCENTAGE OF	BOARD OF TRADE	LOYDS
PLATE	85.064	85.064
RIVET	86.85	87.84

OUTSIDE  $\frac{13}{32}$   
BUTT STRAPS  
INSIDE  $\frac{11}{32}$   
RIVETS STEEL

*NOTE*

ADDITIONAL STAY TUBES MARKED S- 3 $\frac{1}{2}$ " DIA x  $\frac{1}{2}$ " THICK SWELLED  $\frac{3}{16}$ " AT FRONT END

1349 DIA x 1040

TO PASS { BOARD OF TRADE  
LLOYDS } SURVEYS

*Y. Tomayeda*



Nos 123 + 125

S. S. Borcher


---

7

J. S. S. Aki Maru

Melton Brook No 142

Aki Maru  
bag. 272

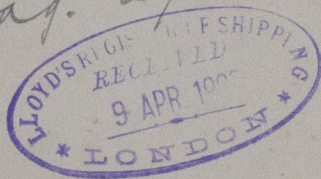

W599-0257